


AO
Architecture.
Design.
Relationships.

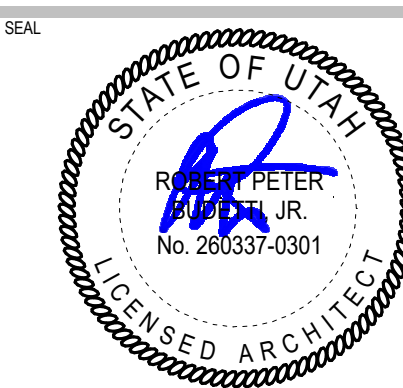

**MOUNTAIN VIEW VILLAGE
PHASE II BUILDING M -
INTERIOR PACKAGE**

W 13400 S & Mountain View Corridor
Riverton, Utah 84065

COVER SHEET

Project Number: 2018-602
Plan Check Number: Permit Number:

[illegible]

S H E E T

M

ID-T1

ABBREVIATION				FOR ADDITIONAL ABBREVIATIONS REFER TO THE DOOR SCHEDULE, FINISH SCHEDULE, AND THE ENGINEER'S DRAWINGS			
A	DIAMETER	FA	FIRE ALARM	PARTN	PARTITION		
A-1	SQUARE FOOT / FEET	FDN	FOUNDATION	P	PROPERTY LINE		
A-2	AND	F.D.	FLOOR DRAIN	PL	PLATE		
A-3	AT	F.E.	FIRE EXTINGUISHER	PLAM	PLASTIC LAMINATE		
A-4	CENTER LINE	F.F.	FINISH FLOOR	PLAS	PLASTER		
A-5	PERPENDICULAR	FIN	FINISH	PLMG	PLUMBING		
A-6	FOUR OR NUMBER	FLND	FLYWOOD	PLND	PLYWOOD		
A-7	EXISTING	FLASH	FLASHING	P.O.C.	POINT OF CONNECTION		
A-8	ANCHOR BOLT	FLR	FLOOR	PR	PAIR		
ABV	ABOVE	FLOR	FLUORESCENT	P.T.	PRESSURE TREATED		
AC	AIR CONDITIONING	F.H.C.	FIREHOSE CABINET	Q.T.	QUARRY TILE		
A.C.	ASPHALTIC CONCRETE	F.L.	FLOOR LINE	RGR	RISER		
ACUST	ACOUSTIC ACOUSTICAL	F.O.C.	FACE OF CONCRETE	RAD	RADIUS		
ADL	ADDITIONAL	F.O.F.	FACE OF FINISH	R.D.	ROOF DRAIN		
A.D.	AREA DRAIN	F.O.M.	FACE OF MASONRY	R.DW	REDWOOD		
ADJ	ADJACENT	F.O.S.	FACE OF SHEATHING	REF	REFER TO		
AFF	ABOVE FINISH FLOOR	F.O.ST	FACE OF STEEL	REFR	REFRIGERATOR		
AGGR	AGGREGATE	FRF	FIREPROOF	REF	REFERENCE		
ALUM	ALUMINUM	FRT	FIRE RETARDANT TREATED	REFR	REFRIGERATION		
APPROX	APPROXIMATE	F.S.	FINISH SURFACE	REG	REGISTER		
ARCH	ARCHITECTURAL	F.L.S.	FLOOR SINK	REIN	REINFORCING		
ASB	ASBESTOS	FTG	FOOTING	REQ	REQUIRED		
ASPH	ASPHALT	FURR	FURRING	REQM	REQUIREMENT		
ASR	AUTO SPRINKLER RISER	FUT.	FUTURE	RESIL	RESILIENT		
AUTO	AUTOMATIC			R.H.B.	RECESSED HOSE BIB		
BL	BOARD	GA	GALVE	RM	ROOM		
BTUM	BUTYMBUS	GAUV	GALVANIZED	R.O.	ROUGH OPENING		
BLDG	BUILDING	G.B.	GRAB BAR	R.O.W.	RIGHT OF WAY		
BLK	BLOCK	G.C.	GENERAL CONTRACTOR	R.S.	ROUGH SAWN		
BLKG	BLOCKING	G.I.	GALVANIZED	R.W.L.	RAIN WATER LEADER		
BM	BEAM	GL	GLAZZ	S.	SOUTH		
B.O.	BOTTOM OF	GRD	GROUND	SAT.	SUSPENDED ACOUSTIC TILE		
BOT	BOTTOM	GR	GRADE	S.C.	SOLID CORE		
BTWN	BETWEEN	GYP	GYPJUM	SCHD.	SCHEDULE		
C	CAMBER	H.B.	HOUSE BIB	SECT.	SECTION		
CAB	CABINET	H.C.	HOLLOW CORE	S.F.	SQUARE FOOT (FEET)		
C.B.	CATCH BASIN	HDR	HEADER	SH	SHEET		
CEM	CEMENT	HDW	HARDWARE	SH	SIMILAR		
CER	CERAMIC	HWWD	HARDWOOD	SIM	SIMILAR		
C.H.B.	CONCEALED HOSE BIB	H.M.	HOLLOW METAL	SPEC.	SPECIFICATION (S)		
C.I.	CAST IRON	HORIZ	HORIZONTAL	SO	SQUARE		
CJ	CEILING JOINT	H.P.	HIGH POINT	S.S.	STAINLESS STEEL		
CL	CEILING	H.R.	HOUR	SSA	SERVICE E SINK		
CLR	CONTROL JOINT	H.T.	HEIGHT	STA	STEEL		
CMU	CONCRETE MASONRY UNIT	HVAC	HEATING, VENTILATION, & AIR CONDITIONING	STL	STEEL		
C.O.	CONCRETE OPENING			STOR	STORAGE		
CO	CLEANOUTS	I.D.	INSIDE DIAMETER	STRUCT	STRUCTURAL - STRUCTURE		
COO	COLUMN	I.E.	INVERT ELEVATION	SUSP.	SUSPENDED		
CONC	CONCRETE	I.N.	INCH	SYN	SYMMETRICAL		
CON	CONNECTION	INFO	INFORMATION	T	TEMPERED		
CONST	CONSTRUCTION	INSUL	INSULATION	TRO	TREAD		
CONT	CONTINUOUS	INT.	INTERIOR	T.O.B.	TOP OF BEAM		
CONTR	CONTRACTOR			T.C.	TOP OF CURB		
COOR	CORRIDOR	JT.	JOINT	T.D.	TOP OF DRAIN		
COUN	COUNTERSINK			TEL	TELEPHONE		
CY	CENTER	LAM	LAMINATE	T&G	TONGUE & GROOVE		
CYR	CUBIC YARD	LAV	LAVATORY	THK	THICK		
		L.T.	LIGHT	T.J.	TRUSS JOIST		
DBL	DOUBLE			T.O.	TOP OF		
DEPT	DEPARTMENT	MAX.	MAXIMUM	T.O.C.	TOP OF CONCRETE		
DET	DETAIL	MECH.	MECHANICAL	T.O.P.	TOP OF PARAPET		
D.F.	DRINKING FOUNTAIN	MEMB.	MEMBRANE	T.O.PL	TOP OF PLATE		
DIA	DIAMETER	MET	METAL	T.O.S.	TOP OF STEEL		
DM	DIMENSION	MFR	MANUFACTURER	T.O.SH	TOP OF SHEATHING		
DMP	DRAIN	M.H.	MANHOLE	T.O.W.	TOP OF WALL		
DN	DOWN	MIN.	MINIMUM	T.P.	TOP OF PAVEMENT		
DR	DOOR	MIR	MIRROR	T.V.	TELEVISION		
DRS	DRAINSPROUT	MISC.	MISCELLANEOUS	TYP	TYPICAL		
D.S.P.	DRY STANDPIPE	M.O.	MAINTAINED OPENING	UNF.	UNFINISHED		
DWG	DRAWING	MOUNT	MOUNTED	UNO	UNLESS NOTED OTHERWISE		
		MUL	MULLION	VERT	VERTICAL		
E	EAST			V.C.T	VINYL COMPOSITE TILE		
EA	EACH	N	NORTH	V.F.	VENT IN FIELD		
EJ	EXPANSION JOINT	N.F.A.	NET FREE VENT AREA	V.T.R.	VENT THROUGH THROUGH		
ELEC	ELECTRICAL	N.L.C.	NOT IN CONTRACT		ROOF		
EL	ELEVATION	N.C.	NUMBER	V.S.F.	VINYL SHEET FLOORING		
EMER	EMERGENCY	NOM.	NOMINAL				
ENCL	ENCLOSURE	N.T.S.	NOT TO SCALE				
E.P.	ELECTRICAL PANELBOARD						
EPS	EXPANDED POLYSTYRENE	O.A.	OVERALL	W	WEST		
EQ	EQUAL	OBS	OBSERVED	W	WITH		
EQUIP	EQUIPMENT	O.C.	ON CENTER	W.C.	WATER CLOSE		
E.W.C.	ELECTRIC WATER COOLER	O.D.	OUTSIDE DIAMETER	WD	WOOD		
E.W.	EACH WAY	OFD	OVERFLOW DRAIN	WH	WATER HEATER		
EXIST	EXISTING	OFF	OFFICE	WIO	WITHOUT		
EXP	EXPANSION	OPN	OPENING	WP	WATERPROOF		
EXT	EXTERIOR	OPP	OPPOSITE	W.R.	WATER RESISTANT		
				W.W.F.	WELDED WIRE FABRIC		
				WT	WEIGHT		

SYMBOLS				FOR ADDITIONAL SYMBOLS REFER TO THE PLANS, SECTION, AND ELEVATIONS GRAPHIC LEGENDS, AND THE ENGINEER'S DRAWINGS			
SYMBOL		DESCRIPTION		SYMBOL		DESCRIPTION	
DETAIL REFERENCE				BUILDING AND WALL SECTIONS			
		DETAIL NUMBER PHASE &/OR BUILDING SHEET NUMBER SUBJECT POINTER				DETAIL NUMBER PHASE &/OR BUILDING CUT PLANE SHEET NUMBER	
EXTERIOR ELEVATION				INTERIOR ELEVATION			
		DETAIL NUMBER PHASE &/OR BUILDING SHEET NUMBER				DETAIL NUMBER PHASE &/OR BUILDING SHEET NUMBER ELEVATION REFERENCE	
DOOR NUMBER				CEILING HEIGHT			
		DOOR NUMBER				CEILING HEIGHT ABOVE REFERENCE ELEVATION CEILING TYPE	
ASSEMBLY TYPE				KEYNOTE			
		ASSEMBLY TYPE SUBJECT ASSEMBLY SEE SHEET A0.0-1 AND A0.0-2				KEYNOTE (NEW CONSTRUCTION)	
ACCESSORY TYPE				STOREFRONT / WINDOW TYPE			
		ACCESSORY TYPE				STOREFRONT / WINDOW TYPE	
MISCELLANEOUS TYPE				CLOUD & DELTA			
		MISCELLANEOUS TYPE				REVISION SUBJECT REVISION IDENTIFIER	
SIMPLE FINISH: MATERIAL AND COLOR				COMPLEX FINISH: MATERIAL, COLOR, AND ADD'L INFO.			
		MATERIAL COLOR				MATERIAL COLOR ADDITIONAL INFO.	
ROOM TAG				MATCH LINE			
		NAME ROOM NAME ROOM FLOOR AREA ROOM NUMBER				MATCHLINE SEE: AX-X-X MATCH LOCATION	
ROOM OCCUPANCY LOAD				EGRESS WIDTH			
		RM. OCCUPANCY GROUP RM. NAME OR NUMBER OCC. LOAD FACTOR RM. FLOOR AREA RM. OCCUPANCY LOAD				EGRESS COMPONENT OCCUPANT LOAD REQ'D MINIMUM WIDTH PROVIDED WIDTH	
GRID LINE IDENTIFICATION - NEW				GRID LINE IDENTIFICATION - EXISTING			
		GRID LINE IDENTIFICATION NEW CONSTRUCTION				GRID LINE IDENTIFICATION EXISTING CONSTRUCTION	
SPOT ELEVATION - DATUM				SPOT ELEVATION - SURVEY			
		ELEVATION ABOVE BUILDING DATUM				ELEVATION BASED ON SURVEY DATUM	

MATERIALS LEGEND			
	EARTH SHOWN IN SECTION		GYPSUM BOARD SHOWN IN SECTION
	CONCRETE PLAN OR SECTION		CONT. WOOD BLOCKING SHOWN IN SECTION
	BRICK SECTION OR ELEVATION		FINISHED WOOD SHOWN IN SECTION
	RIGID INSULATION OR SAFING PLAN OR SECTION		PLYWOOD SHOWN IN SECTION
	METAL - TYPE AS NOTED PLAN OR SECTION		SPRAYED FIREPROOFING SHOWN IN SECTION
	METAL - ROLLED SHAPE PLAN OR SECTION		BATT INSULATION SHOWN IN SECTION
	PLASTER SHOWN IN SECTION		GLASS SHOWN IN SECTION
	DENGLASS SHOWN IN SECTION		CMU SHOWN IN SECTION

GENERAL NOTES

1. CENTRAL PROPERTIES, LLC INTERIOR DESIGN DRAWING SHEETS ARE FOR THE ARCHITECT'S INFORMATION AND USE. REFER TO THE ARCHITECT'S DRAWINGS FOR FRAMING, CONSTRUCTION, AND FOR A CONSOLIDATED DOCUMENTATION OF THE PROJECT ENGINEERING REQUIREMENTS AND SPECIALTY CONSULTANT INFORMATION.

A. CENTRAL'S INTERIOR REFERENCE PLANS AND ARCHITECTURAL DETAILS ARE FOR DESIGN INTENT ONLY AND ARE NOT INTENDED TO DICTATE WALL AND DOOR TYPES, CONSTRUCTION METHOD, SUBSTRATE ASSEMBLIES, METHODS OF ATTACHMENT, STRUCTURAL SUPPORT & STABILITY, INTERIOR DIMENSIONS PROVIDED ARE FROM FINISHED SURFACES OF FLOORS, WALLS, AND CEILINGS. UN, ALLOW FOR THICKNESS OF FINISH MATERIALS AND REQUIRED SUBSTRATES.

B. DRAWING DIMENSIONS: WRITTEN DIMENSIONS SHALL GOVERN. MAINTAIN DIMENSIONS MARKED AS "MAX", CLEAR OR "HOLD" DO NOT SCALE DRAWINGS.

C. CENTRAL'S FF & E DRAWINGS INDICATE FURNISHINGS AND EQUIPMENT TO BE PROVIDED UNDER A SEPARATE CONTRACT. ALL EQUIPMENT AND HARDWIRED DECORATIVE LIGHTING TO BE INSTALLED BY THE GENERAL CONTRACTOR (G.C.), UN, ANY FF & E ITEMS INDICATED AS "BY G.C." TO BE PROVIDED BY THE GENERAL CONTRACTOR.

D. WHERE DISCREPANCIES OCCUR OR SUPPLEMENTAL INFORMATION IS REQUIRED IN THE INTERIORS DRAWING PACKAGE, INFORM KLA IMMEDIATELY.

2. ALL WORK SHALL CONFORM WITH CODES, LAW, ORDINANCES, RULES AND REGULATIONS OF PUBLIC AUTHORITIES GOVERNING THE WORK INCLUDING, WITHOUT LIMITATION, LOCAL BUILDING, FIRE/LIFE/SAFETY, AND HEALTH DEPARTMENTS' APPROVAL.

A. REFER TO ARCHITECTURAL CODE DRAWINGS.

B. WHERE CONFLICTS OCCUR, INFORM CENTRAL IMMEDIATELY.

3. THE ATTAINMENT OF AND PAYMENTS FOR PERMITS AND INSPECTIONS AS REQUIRED BY THR PROJECT ARE NOT WITHIN CENTRAL'S SCOPE OF WORK.

4. ALL BACK OF HOUSE AND EXTERIOR AREAS REPRESENTED IN PLANS AND ELEVATIONS NOT INDICATED AS "NIS" (NOT IN SCOPE) OR "BOH" (BACK OF HOUSE) ARE FOR ARCHITECTURAL FINISHES AND/OR FF&E ONLY. ALL RELATED EQUIPMENT, MILLWORK AND OTHER REQUIREMENTS ARE BY OTHERS.

5. REQUESTS FOR SUBSTITUTIONS, REVISIONS OR CHANGES MUST BE SUBMITTED BY THE CONTRACTOR, FOLLOWING THE ARCHITECTS SUBMITTAL PROCEDURE, TO THE ARCHITECT AND CENTRAL FOR REVIEW PRIOR TO PURCHASE, FABRICATION, AND INSTALLATION.

6. SHOP DRAWINGS SHALL BE PREPARED IN ACCORDANCE WITH THE ARCHITECT'S PROCEDURES AND SUBMITTED TO THE OWNER. DESIGNATED PROJECT MANAGER FOR DISTRIBUTION, REVIEW AND APPROVAL PER THE PROCEDURES ESTABLISHED BY THE ARCHITECTS.

7. FINISH SAMPLES AND MILLWORK.

A. UNLESS OTHERWISE DICTATED BY THE OWNER/CLIENT, ALL WOODWORK SHALL CONFORM TO THE REQUIREMENTS OF PREMIUM GRADE CONSTRUCTION AS ESTABLISHED BY THE QUALITY STANDS OF THE AAI (ARCHITECTURAL WOODWORK INSTITUTE) OR PREVAILING LOCAL INDUSTRY STANDARDS.

B. SAMPLES OF ALL FINISH MATERIALS TO BE SUBMITTED TO THE CONTRACTOR & CENTRAL FOR REVIEW AND APPROVAL PRIOR TO FABRICATION OR APPLICATION.

C. FOR WOOD VENEERS, LOG FLITCH TO BE SUBMITTED TO CENTRAL FOR REVIEW AND APPROVAL. CENTRAL SHALL BE INFORMED OF ANY REQUIRED SUBSTITUTIONS.

D. FOR STAIN GRADE SOLID WOOD AND WOOD VENEERS, PROVIDE A MINIMUM OF (3) VARIATIONS OF THE FINISHED SAMPLES. MINIMUM SAMPLE SIZE TO BE 6" X 12", UNLESS OTHERWISE NOTED.

E. PROVIDE FULL-SIZED SAMPLES / MOCK-UPS WHERE REQUESTED BY ARCHITECT OR CENTRAL.

F. ALL FINISH MATERIALS TO BE TREATED WITH NECESSARY FLAME-RETARDANT PROCESS. G.C. SHALL NOTIFY THE CONSULTANTS FOR (BAY CHANGES IN COLOR OR EFFECT TO THE FINISHED MATERIAL.

8. APPLICATION / INSTALLATION OF FINISHES ON WALLS, FLOORS AND CEILINGS SHALL BE A PART OF THE CONTRACTORS SCOPE. ANY MAINTENANCE OR INSTALLATION DIRECTIONS FROM THE MANUFACTURER WHICH ARE NOT COVERED IN THE SPECIFICATIONS OR DETAILLED IN THE DRAWINGS, THE CONTRACTOR SHALL NOTIFY THE ARCHITECT AND CENTRAL AND ACQUIRE CLARIFICATION PRIOR TO INSTALLATION. CONTRACTOR TO INSTALL FINISHES PER ARCHITECT'S PERFORMANCE SPECIFICATIONS OR PER MANUFACTURERS INSTRUCTIONS, WHICHEVER IS MORE RESTRICTIVE, WHEN INSTALLING PER THE LATTER, NOTIFY THE ARCHITECT AND CENTRAL.

9. INTERIOR DOOR STYLE DRAWINGS ARE FOR DESIGN INTENT ONLY. DOOR FINISHES ARE NOTED ON THE "DOOR STYLES & DETAILS" SHEET(S). DOOR TRIM FINISHES ARE INDICATED IN INTERIOR ELEVATIONS. REER TO THE ARCHITECT'S DOOR SCHEDULE FOR ALL DOOR TYPES AND INFORMATION INCLUDING, BUT NOT LIMITED TO COMPOSITION, FIRE & ACOUSTIC RATING, AND HARDWARE.

10. DOOR HARDWARE INDICATED IN INTERIOR DRAWINGS ARE DECORATIVE AND FOR FINITY. DESIGN, AND FINISH ONLY. REFER TO THE ARCHITECT'S HARDWARE SCHEDULE FOR ALL HARDWARE & LOCKING REQUIREMENTS.

11. CONTRACTOR SHALL PROVIDE ADEQUATE CONCEALED BLOCKING ON WALLS AND CEILINGS TO SUPPORT WALL AND CEILING MOUNTED FIXTURES AND EQUIPMENT INCLUDING, BUT NOT LIMITED TO HARD-WIRED LIGHTING FIXTURES, ARTWORK, MIRRORS AND OTHER WALL-MOUNTED ACCESSORIES, SCULPTURES, DRAPERY TRACKS, WALL-MOUNTED TV'S, GRAB BARS, CANTILEVERED VANITIES AND/OR CABINERY. REFER TO THE ARCHITECT'S DRAWINGS FOR THE REQUIRED BLOCKING AND/OR FRAMING TYPE, INSTALLATION, DETAILS, AND ADDITIONAL STRUCTURAL INFORMATION.

12. VANITY INSTALLATION, WHERE A TILED WANSICOT OCCURS AROUND THE VANITY, INSTALL THE TILE WANSICOT PRIOR TO THE VANITY & STONE TOP INSTALLATION. FIELD VERIFY FOR TIGHT FIT.

13. FOR FLOOR-MOUNTED FIXTURES, FLOOR FINISH TO RUN 2" PAST THE VISIBLE PERIMETER. UNDER THE CASEWORK.


14. FOR ADDITIONAL DRAWINGS SPECIFIC NOTES AND SHEET INFORMATION, REFER TO ID SHEETS.

GROUP B AND M ACCESSIBILITY REQUIREMENTS

- A. AUTOMATIC TELLER MACHINES, FARE MACHINES AND POINT-OF-SALE DEVICES**
1. Electronic information processing devices that accept or dispense cash in connection with a credit, deposit or convenience account shall comply with the requirements for Automatic Teller Machines (ATMs), § 11B-206.2.1.
2. Devices used for the purchase of goods or services that require a personal identification number (PIN), zip code or signature shall comply with the requirements for Point-of-Sale Devices (POS), §202, §11B-220.2.
3. All automatic teller machines, fare machines and point-of-sale devices shall display characters in a sans serif font. Characters shall be at least 3/16 inch high based on the uppercase letter "T". Characters shall contrast with their background with either light characters on a dark background or dark characters on a light background. §11B-220.2, §11B-707.7.2
4. Walk-up automatic teller machines, fare machines and point-of-sale devices shall comply with all requirements of Sections 11B-305 Clear Floor or Ground Space and 11B-309 Operable Parts. Each operable part shall be able to be differentiated by sound or touch, without activation, unless a clear or correct key is provided. § 11B-220.11B-707.
5. Where two or more walk-up point-of-sale devices are installed for use with a specific type of motor fuel, at least two for that fuel type that comply with all requirements of Sections 11B-305 Clear Floor or Ground Space and 11B-309 Operable Parts. Fuel types include, but are not limited to, gasoline, diesel, compressed natural gas, methanol, ethanol or electricity. §11B-220.2
6. Drive-up only automatic teller machines, fare machines and point-of-sale devices shall be operable with one hand without requiring touch, grasping, pinching, or twisting of the wrist and use no more than 5.0 pounds to activate operable parts. Each operable part shall be able to be differentiated by sound or touch, without activation, unless a clear or correct key is provided. §11B-707.3
7. Point-of-sale devices when provided at check stands and sales and service counters and at automatic teller machines shall provide the opportunity for the same degree of privacy of input and output available to all individuals. §11B-707.4, §11B-707.5.2
8. Where bins are provided for envelopes, waste paper, or other purposes to serve automatic teller and fare machines, at least one of each type shall comply with the requirements for clear floor space, height and operable parts in Section 11B-811. §11B-220.1
9. Automatic teller and fare machines shall be speech enabled. Speech shall be delivered through a mechanism that is readily available to all users, including but not limited to, an industry standard connector or a telephone handset. Speech shall be recorded or digitized human, or synthesized. §11B-707.5
10. For automatic teller and fare machines, operating instructions and orientation, viable transaction prompts, user input verification, error messages, and all displayed information for full use shall be accessible to and independently available by individuals with visual impairments. § 11B-707.5
11. Speech on automatic teller and fare machines shall be capable of being repeated or interrupted. Speech output for any single function may be automatically interrupted when a transaction is selected. Volume control shall be provided for the speech function. §11B-707.5.2
12. Speech output devices on automatic teller and fare machines that provide receipts shall provide audible and/or visual information, error messages, and all other information on the printed receipt necessary to complete or verify the transaction unless otherwise exempted. §11B-707.5.2
13. Speech output devices on automatic teller and fare machines that provide receipts shall not require the following to be audible: machine location, date and time of transaction, account number, number, and the machine identifier, information on printed receipts that duplicates information on screens and printed copies of bank statements and checks. §11B-707.5.2
14. Automatic teller and fare machines shall provide at least one tactilely discernible input control for each function. Where provided, key surfaces not on active areas of display screens, shall be raised above surrounding surfaces. Where multiple keys are the only method of input, each shall be tactilely discernible from surrounding surfaces and adjacent keys. §11B-707.6.1
15. Numeric keys on automatic teller and fare machines shall be arranged in a 12-key ascending or descending telephone keypad layout. The numeric first key shall be tactilely distinct from the other keys. §11B-707.6.2
16. Function keys on automatic teller and fare machines shall contrast visually from background surfaces. Characters and symbols on key surfaces shall contrast visually from their keycaps. Visual contrast shall be with light on dark or dark on light except for tactile symbols. §11B-707.6.3.1
- A. PLAY AREAS**
1. Play areas shall provide accessible routes in accordance with 11B-206.2.17 Play Areas. Accessible routes serving play areas shall comply with Division 4 except as modified by 11B-1009.2.
2. For ground level and elevated play components, at least one accessible route shall be provided within the play area. The accessible route shall connect ground level play components required to comply with 11B-240.2.1 Ground Level Play Components and elevated play components required to comply with 11B-240.2.2 Elevated Play Components, including entry and exit points of the play components. §11B-206.2.17.1
3. For soft-contained play structures, where three or fewer entry points are provided for soft contained play structures, at least one entry point shall be on an accessible route. Where four or more entry points are provided for soft contained play structures, at least two entry points shall be on an accessible route. §11B-206.2.17.2
- B. RECREATIONAL BOATING FACILITIES**
1. Provide accessible routes to recreational boating facilities, including gangways and floating piers. §11B-1003.2
2. Provide clear pier space 60 inches wide minimum and at least as long as the boat sits. Each 10 foot maximum of linear pier edge serving boat sits shall contain at least one continuous clear opening 60 inches wide minimum. §11B-1003.3.1 (See exceptions)
3. Provide clear pier space 60 inches wide minimum and at least as long as the full length of the boarding pier at boat launch ramps. Every 10 foot maximum of linear pier edge shall contain at least one continuous clear opening 60 inches wide minimum. §11B-1003.3.2 (See exceptions)
- C. EXERCISE MACHINES AND EQUIPMENT**
1. Provide a clear floor space complying with 11B-305 Clear Floor or Ground Surfaces positioned for transfer or for use by an individual seated in a wheelchair. §11B-1004.1
- D. SAUNAS AND STEAM ROOMS**
1. Where provided, saunas and steam rooms shall comply with Section 11B-612, §11B-241.1 (See exception)
2. Where saunas or steam rooms are clustered at a single location, no more than 5 percent of the saunas and steam rooms, but no fewer than one, of each type in each cluster shall be required to comply with Section 11B-612, §11B-241.1 (See exception)
3. Bench. Where seating is provided in saunas and steam rooms, at least one bench shall comply with Section 11B-903. Door shall not swing into the clear floor space required by Section 11B-903.2 §11B-612.2
4. A readily removable bench shall be permitted to obstruct the turning space required by Section 11B-612.3 and the clear floor or ground space required by Section 11B-903.2 §11B-612.2 (See exception)
5. A turning space complying with Section 11B-304 shall be provided within saunas and steam rooms §11B-612.3
- E. SWIMMING POOLS, WADING POOLS, AND SPAS**
1. Provide at least two accessible means of entry for the swimming pool. Accessible means of entry shall be swimming pool lifts, sloped entries, transfer walls, or pool stairs. At least one accessible means of entry shall be provided for each swimming pool lift or sloped entry. §11B-242.2, §11B-1009.2, §11B-1009.3
2. Telephones with a volume control shall be identified by a pictogram of a telephone handset with radiating sound waves on a square field as shown in Figure 11B-703.2.6
3. Where a swimming pool has less than 300 linear feet of swimming pool, no more than one accessible means of entry shall be required to provide the accessible means of entry is a swimming pool lift or sloped entry. §11B-242.2 exception 1, §11B-1009.2, §11B-1009.3
4. Provide at least one accessible means of entry for the wading pool. Accessible means of entry shall comply with 11B-1009.3 Sloped Entries. §11B-242.3, §11B-1009.3
5. Provide at least one accessible means of entry for the pool. Accessible means of entry shall be swimming 11B-1009.2 Pool Lifts, 11B-1009.4 Transfer Walls, or 11B-1009.5 Transfer Systems. §11B-242.4
6. Where saunas are provided in a cluster, no more than 5 percent, but no fewer than one, in each cluster shall be required to provide an accessible means of entry. §11B-242.4 exception
7. Pool lifts shall be located where the water level is 36 inches minimum and 48 inches maximum. §11B-1009.2.1
8. On the side of the seat opposite the water, provide a clear deck space parallel with the seat. The space shall be 36 inches wide minimum and shall extend forward 48 inches minimum from a line located 12 inches behind the seat edge of the pool. Pool stairs shall have a slope not steeper than 1:48 (2.083%). §11B-1009.2.3
9. Where saunas or steam rooms are clustered at a single location, no more than 5 percent of the saunas and steam rooms, but no fewer than one, of each type in each cluster shall be required to provide an accessible means of entry. §11B-242.4 exception
10. Pool lifts shall be located where the water level is 36 inches minimum and 48 inches maximum. §11B-1009.2.1
11. In the raised position, the centerline of the pool lift seat shall be located on the deck to the pool. The pool lift shall be no more than 16 inches minimum from the edge of the pool. §11B-1009.2.2
12. Pool stairs shall be located where the water level is 36 inches minimum and 48 inches maximum. §11B-1009.2.1
13. Pool stairs shall be located where the water level is 36 inches minimum and 48 inches maximum. §11B-1009.2.1
229. Pool stairs shall be located where the water level is

OVERALL FLOOR PLAN


Number: 2018-602
Check Number: Permit Number

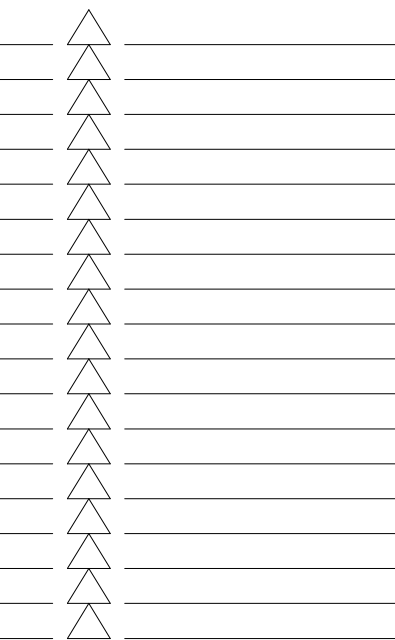

H E E T

M

D-1.0

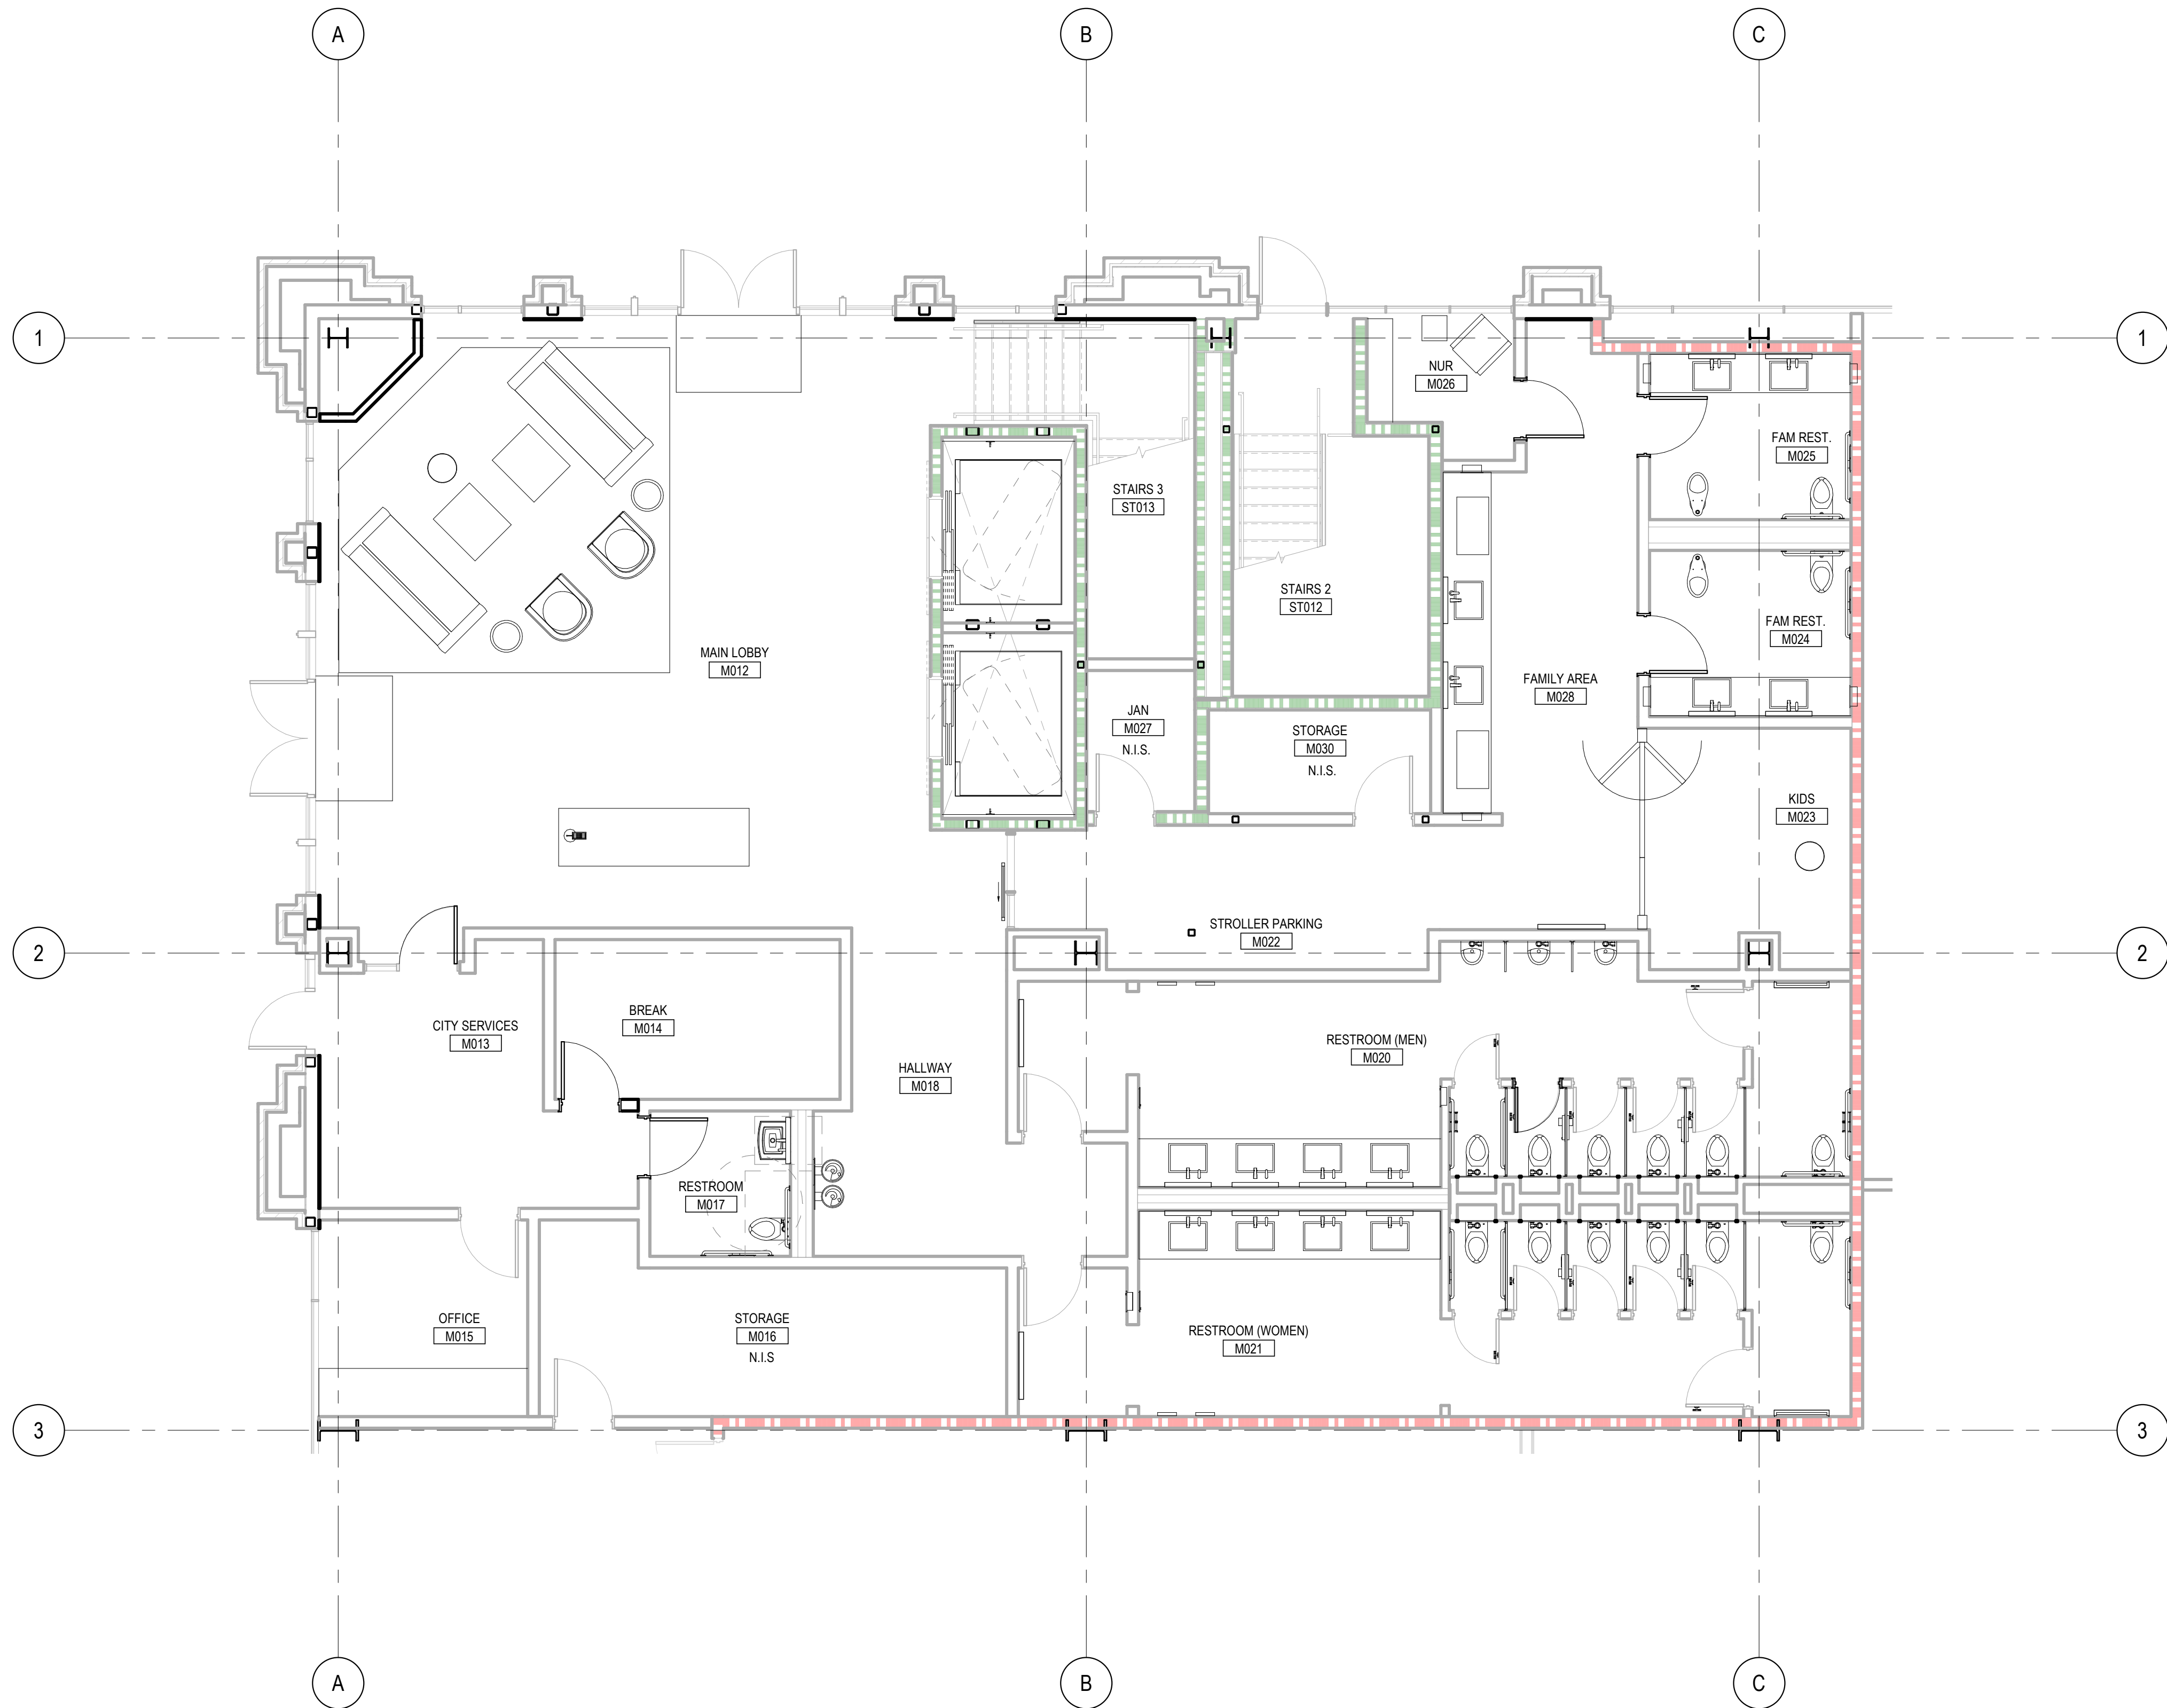


Project
North

OVERALL FLOOR PLAN

Scale:

$3/16" = 1'-0"$

1

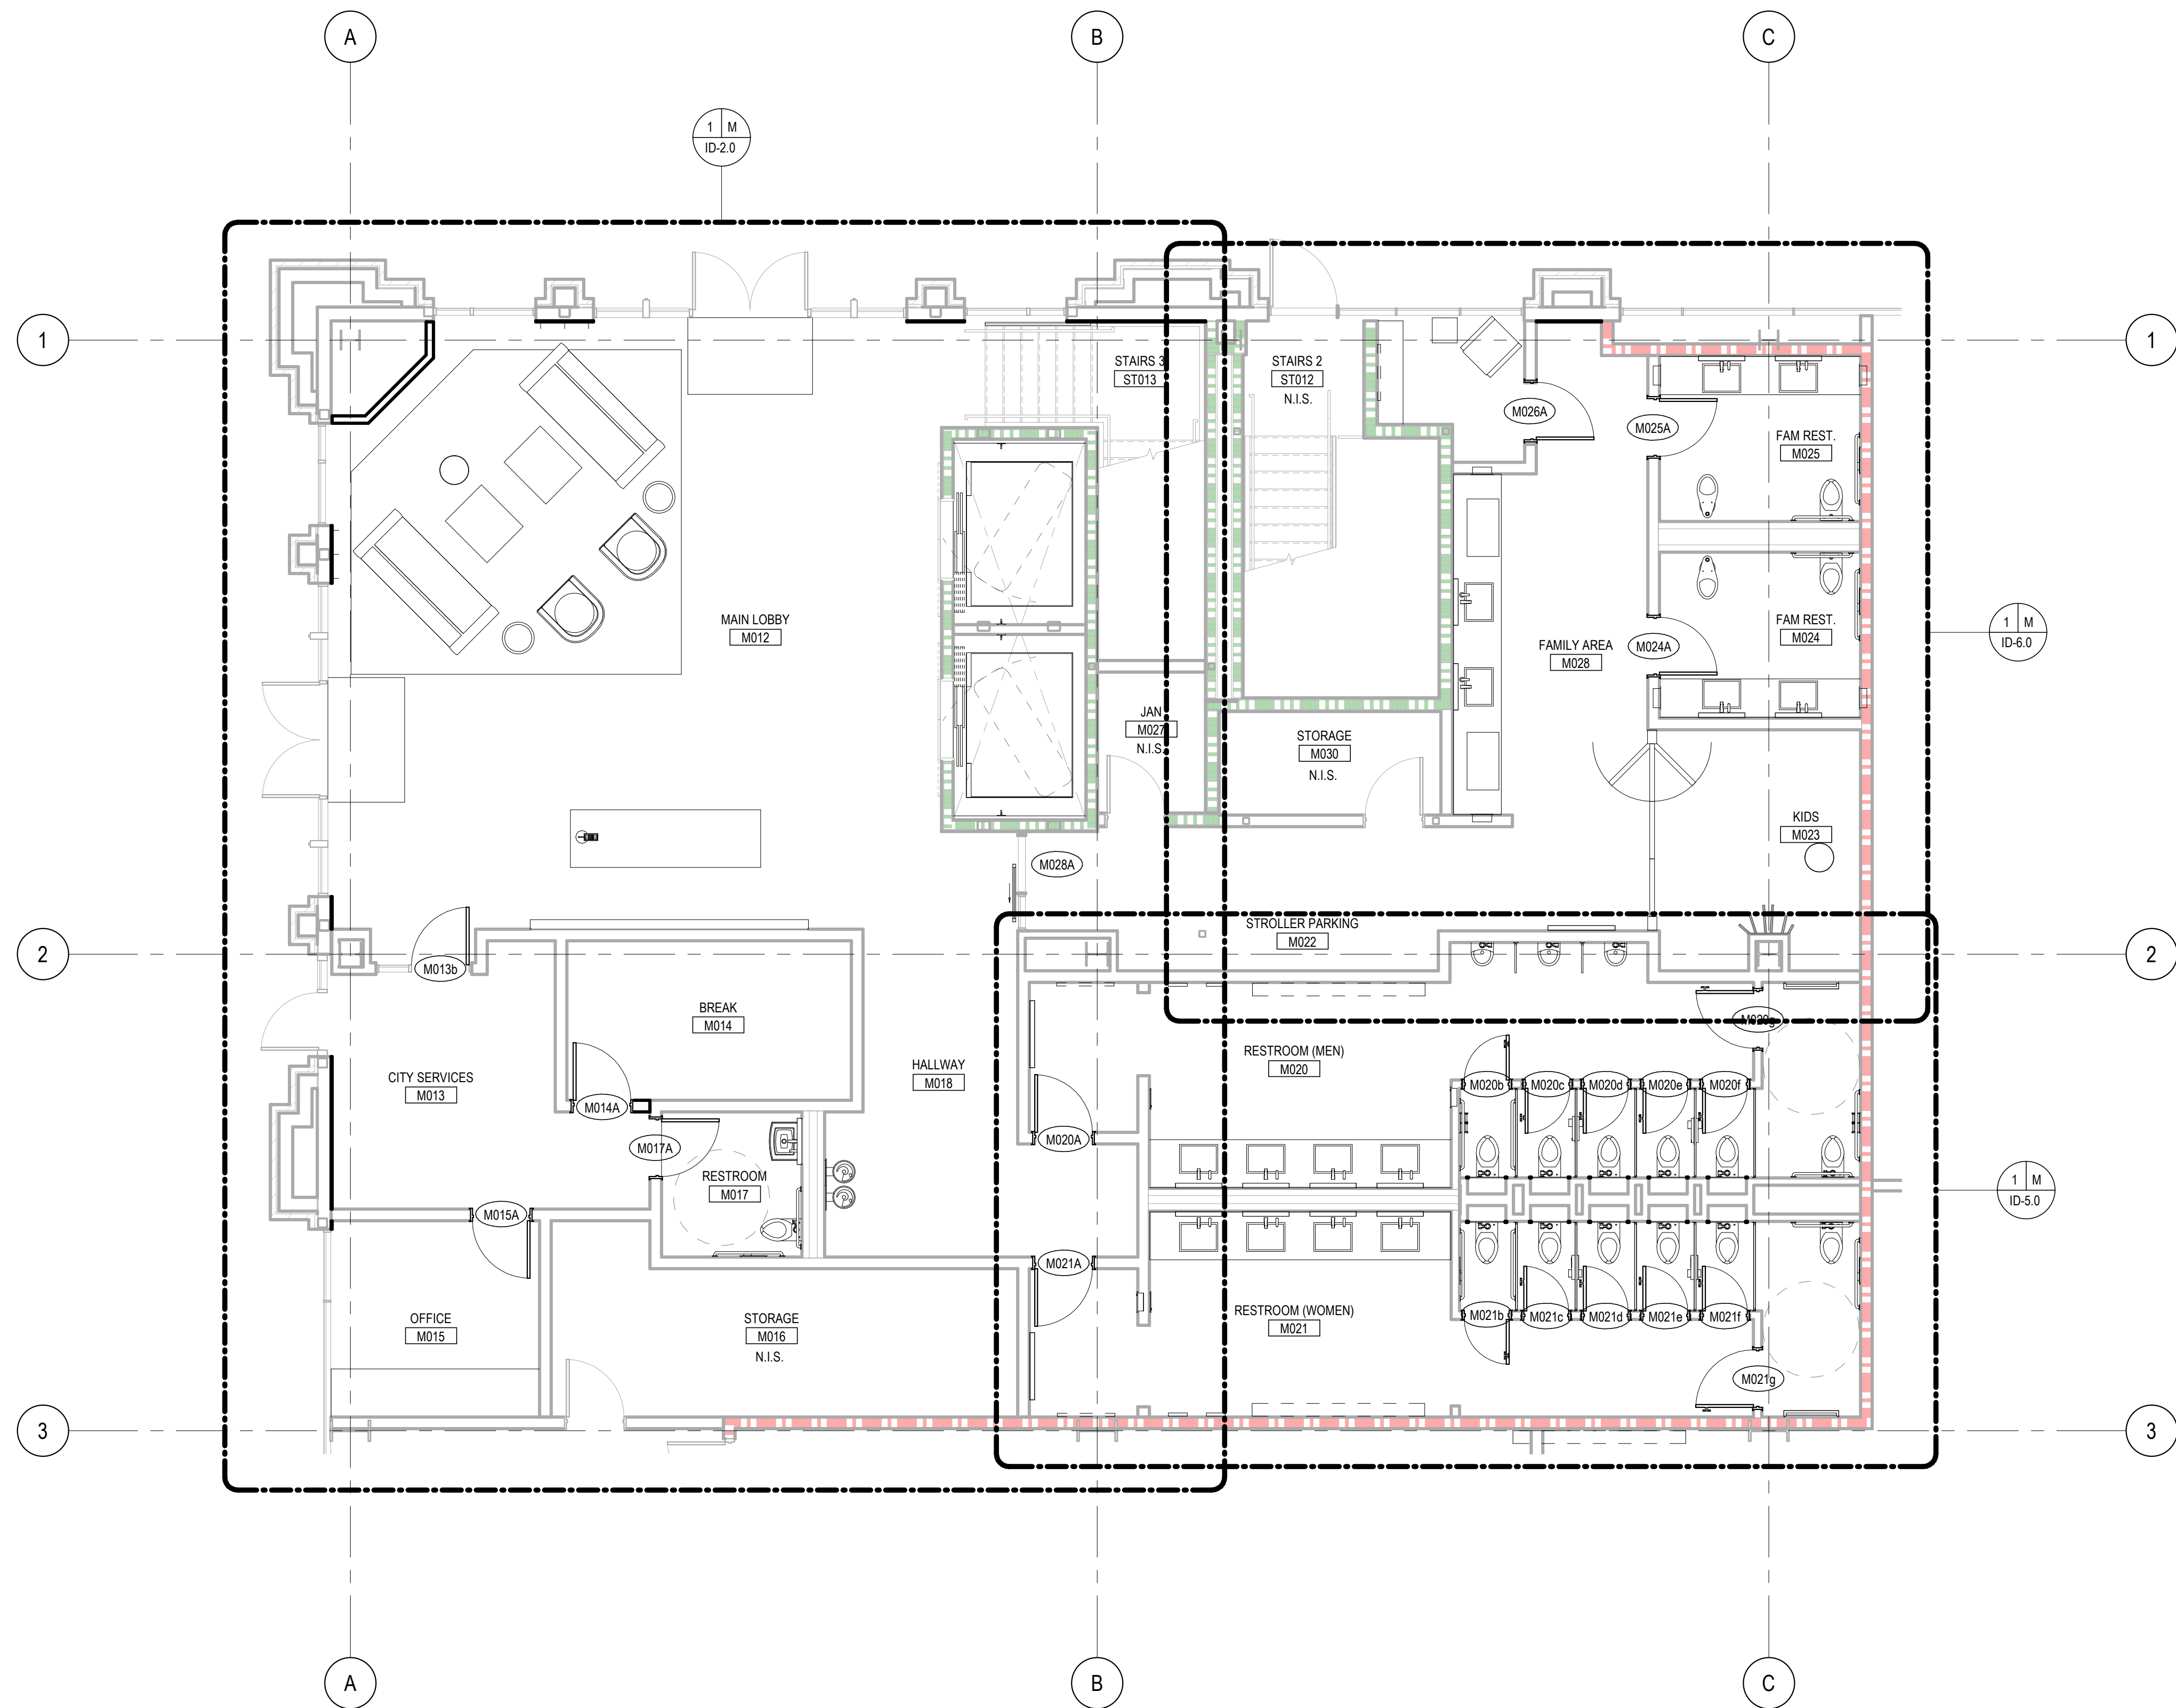

KEYNOTES

Project
North


A circular symbol with a vertical line through the center, indicating North.

Scale:

$3/16" = 1'-0"$

OVERALL FURNISHING KEY PLAN

1

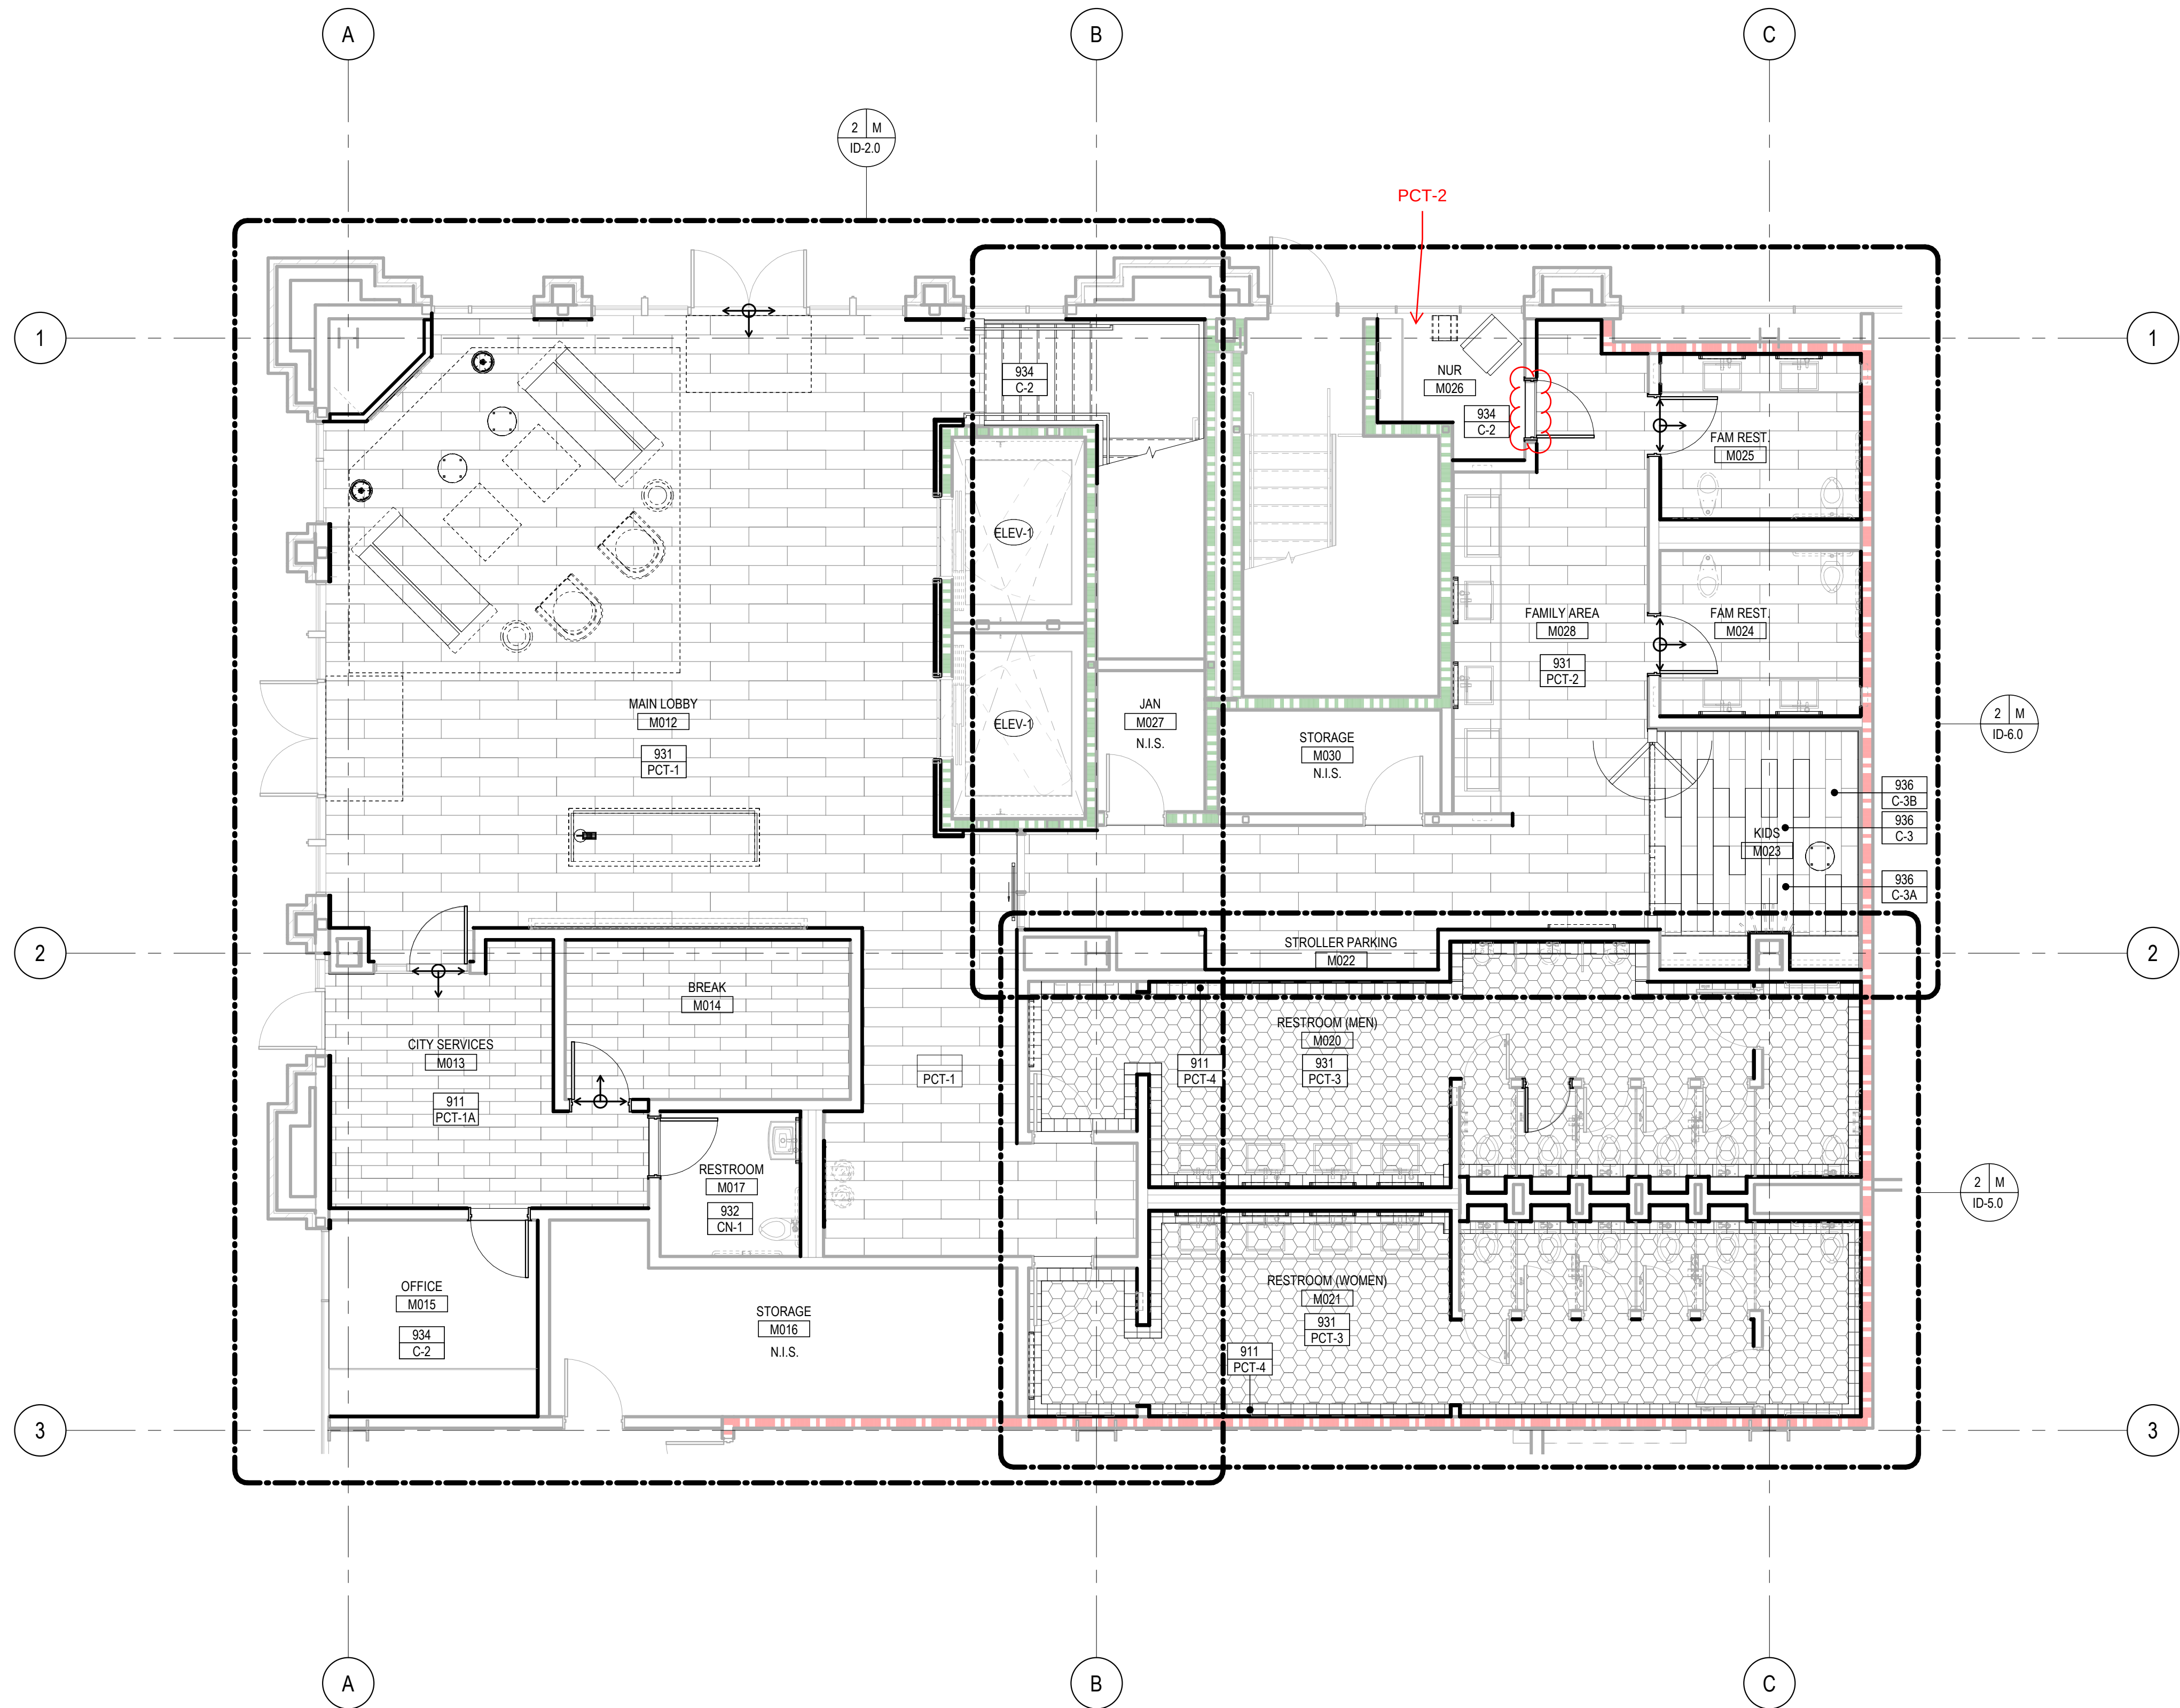

OVERALL FLOOR FINISH KEY PLAN

Scale:
3/16" = 1'-0"



1


KEYNOTES

- 911 PORCELAIN TILE
931 FLOOR TILE
932 STAINED AND SEALED CONCRETE
934 CARPET
936 CARPET TILE


FINISH PLAN SYMBOL LEGEND

- NON-RATED WALLS (SHELL SCOPE)
1 HR FIRE RATED WALLS (SHELL SCOPE)
2 HR FIRE RATED WALLS (SHELL SCOPE)

FINISH START SYMBOL

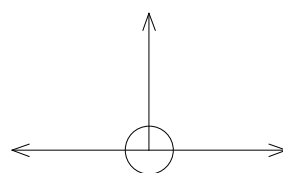


- ### KEYNOTE REFERENCE
KEYNOTE REFERENCE
XX-# COLOR & FINISH REFERENCE

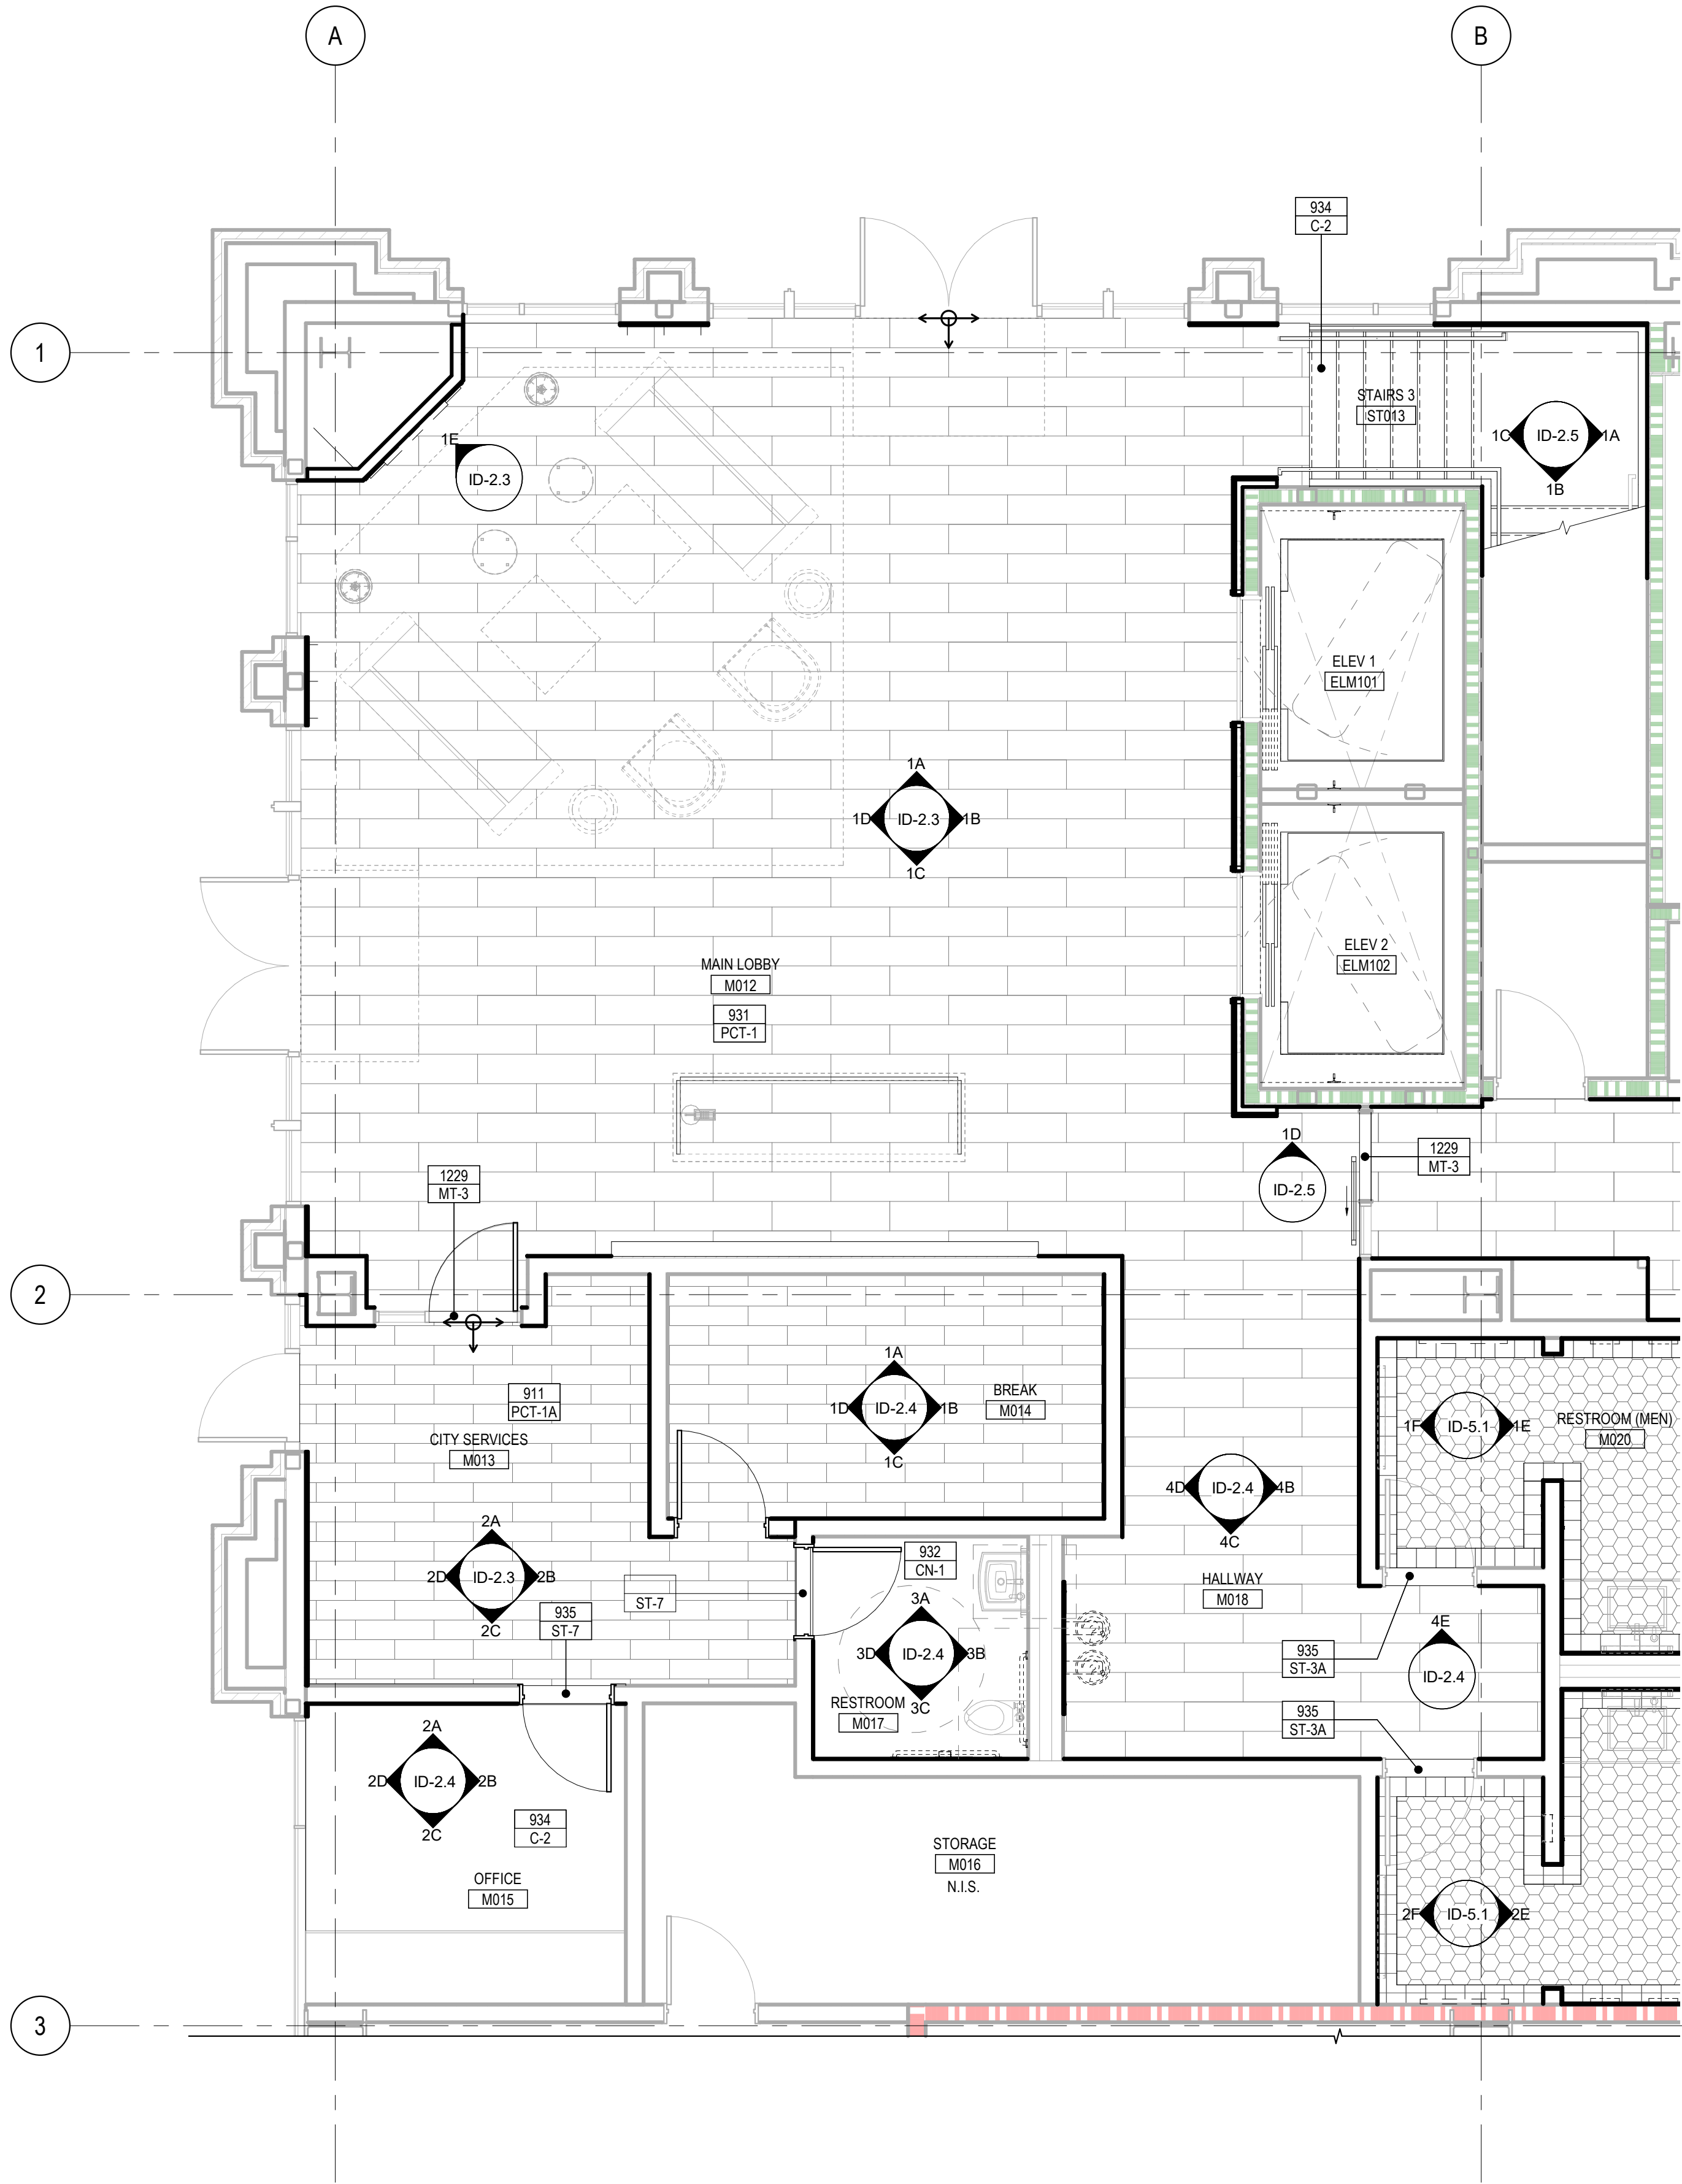

ENLARGED FLOOR FINISH PLAN - MAIN LOBBY, SERVICE, OFFICE & BREAK

Scale: 1/4" = 1'-0"

2

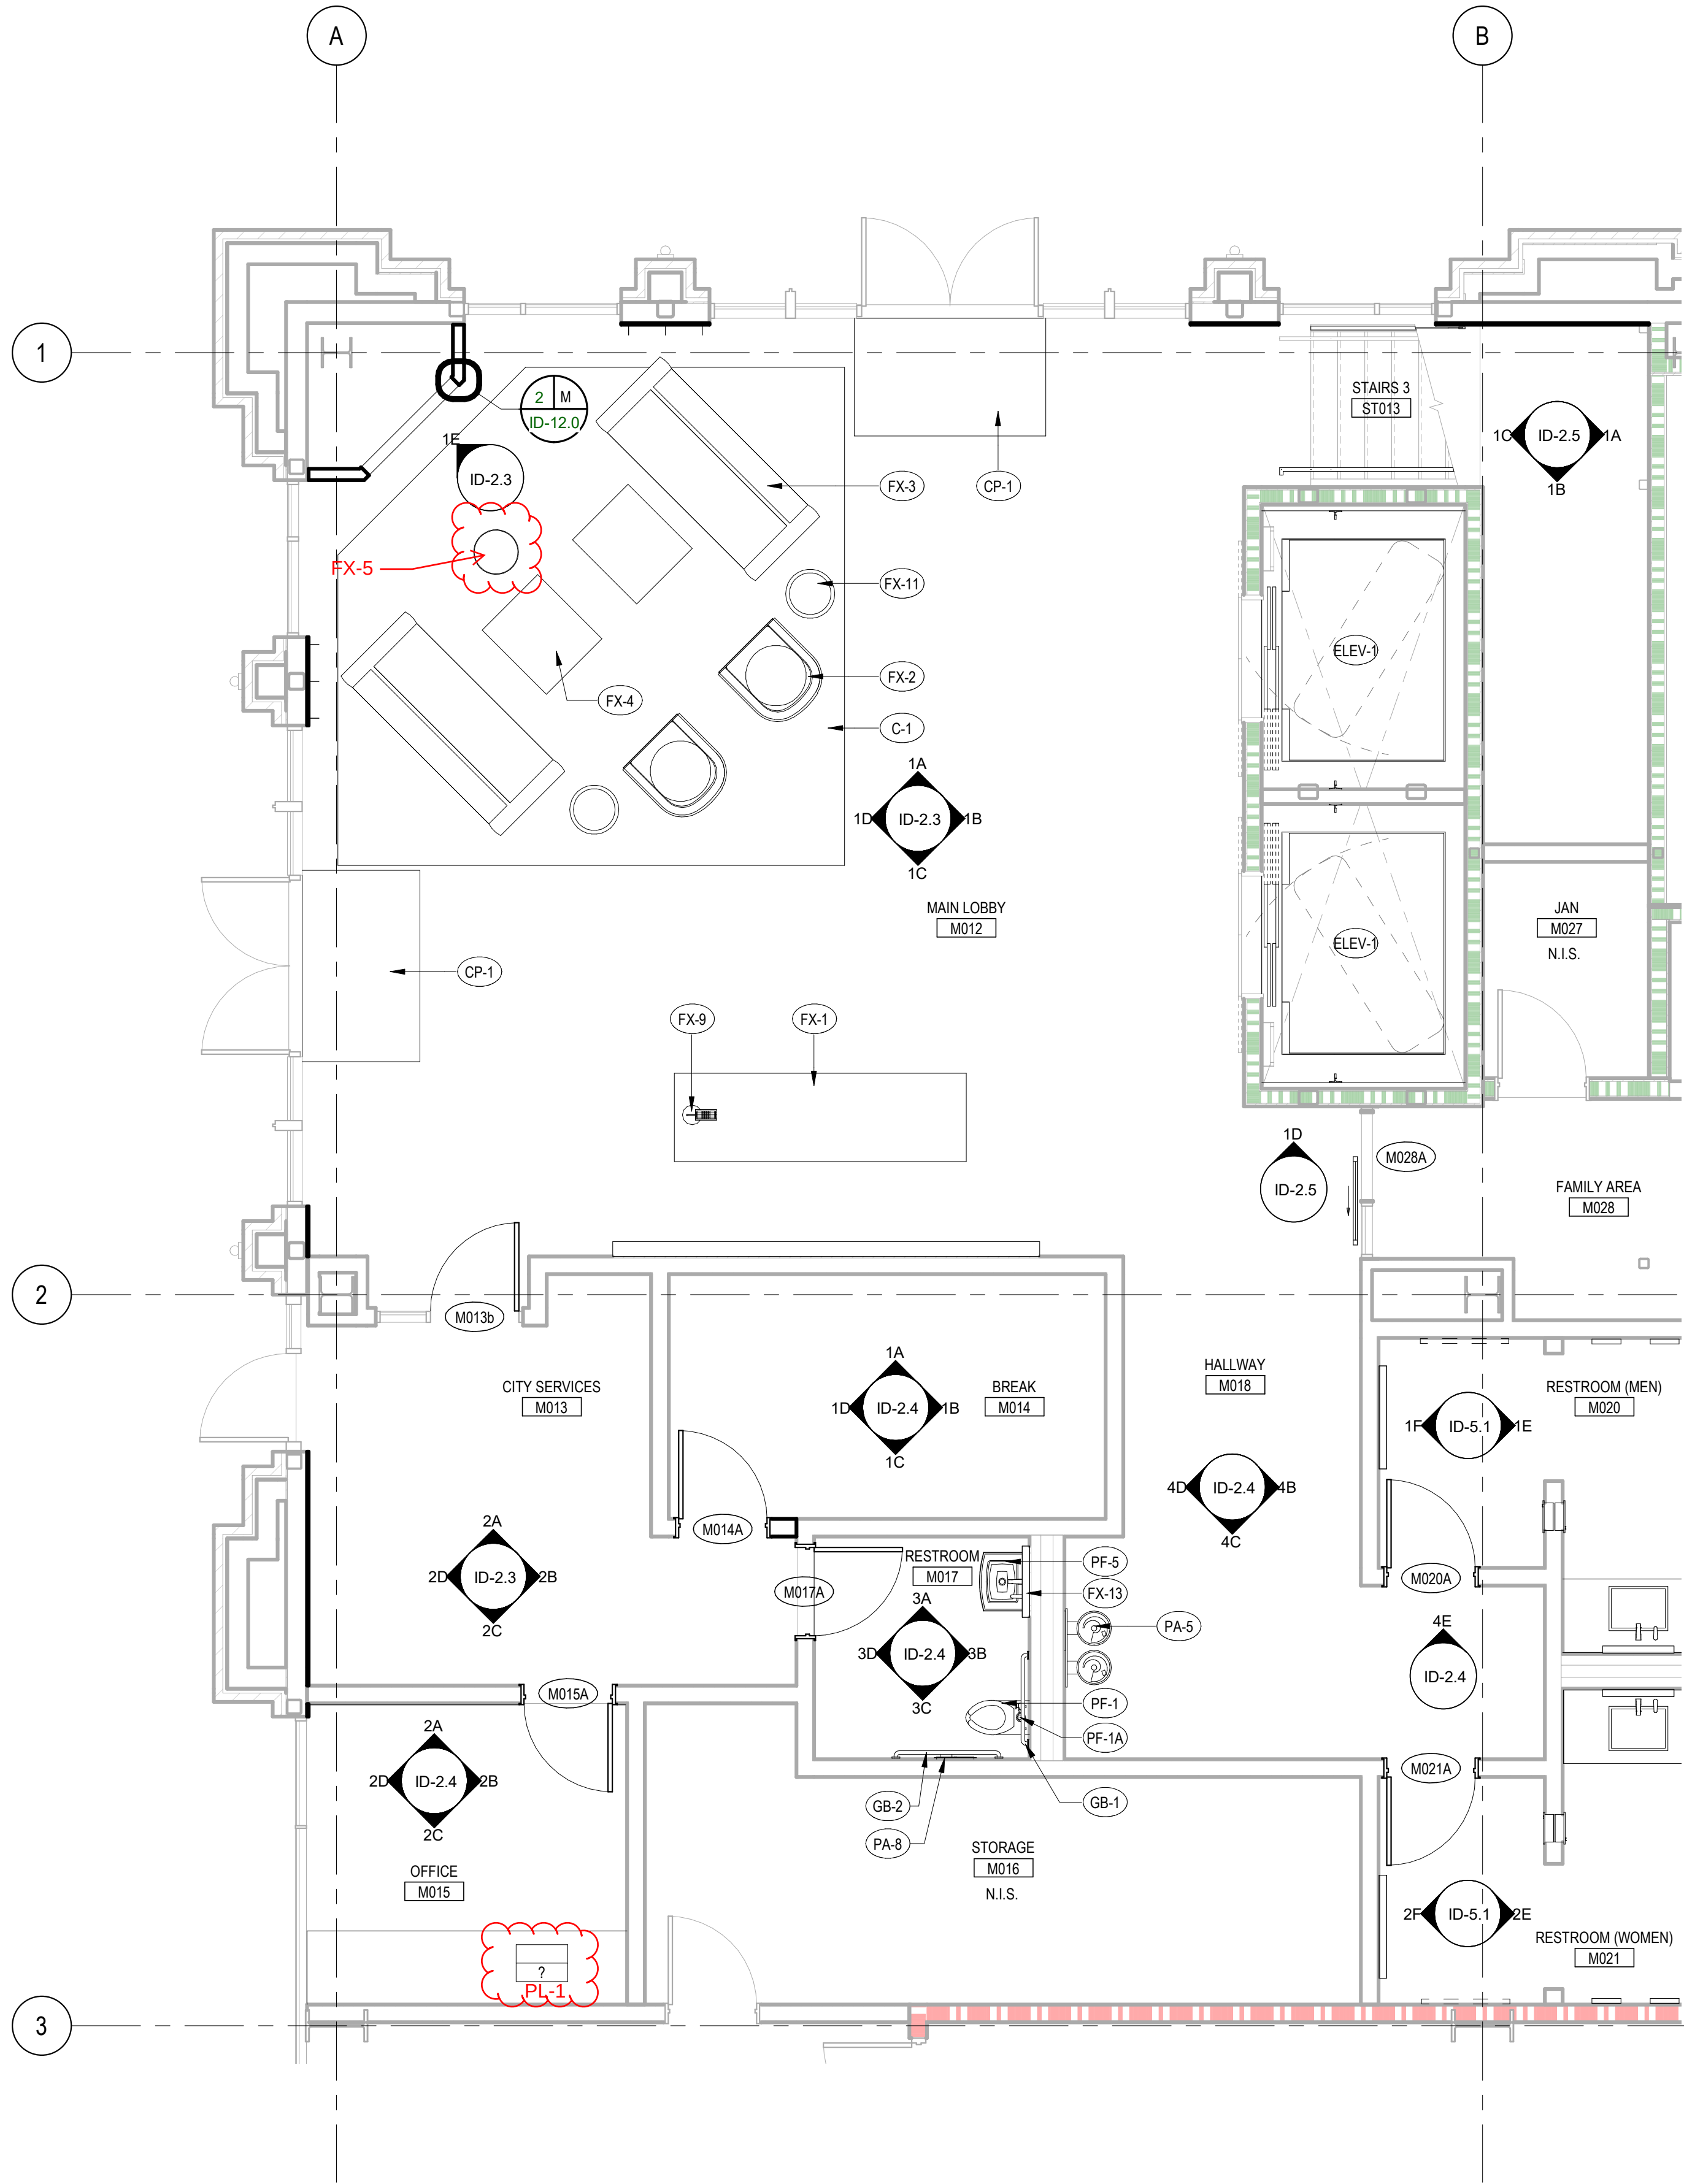

ENLARGED FURNISHING PLAN - MAIN LOBBY, SERVICE, OFFICE & BREAK

Scale: 1/4" = 1'-0"

1

GENERAL NOTES

1. REFER TO SHEETS ID-T3 TO ID-T7 FOR ADA ACCESSIBILITY REQUIREMENTS NOTES AND DETAILS.

KEYNOTES

- 911 PORCELAIN TILE
931 FLOOR TILE
932 STAINED AND SEALED CONCRETE
934 CARPET
935 STONE THRESHOLD
1229 METAL THRESHOLD

FINISH PLAN SYMBOL LEGEND


- NON-RATED WALLS (SHELL SCOPE)
1 HR FIRE RATED WALLS (SHELL SCOPE)
2 HR FIRE RATED WALLS (SHELL SCOPE)

FINISH START SYMBOL

- KEYNOTE REFERENCE
KEYNOTE REFERENCE
COLOR & FINISH REFERENCE

FIXTURE & FURNISHING SYMBOL LEGEND


- FIXTURE AND FURNISHING REFERENCE

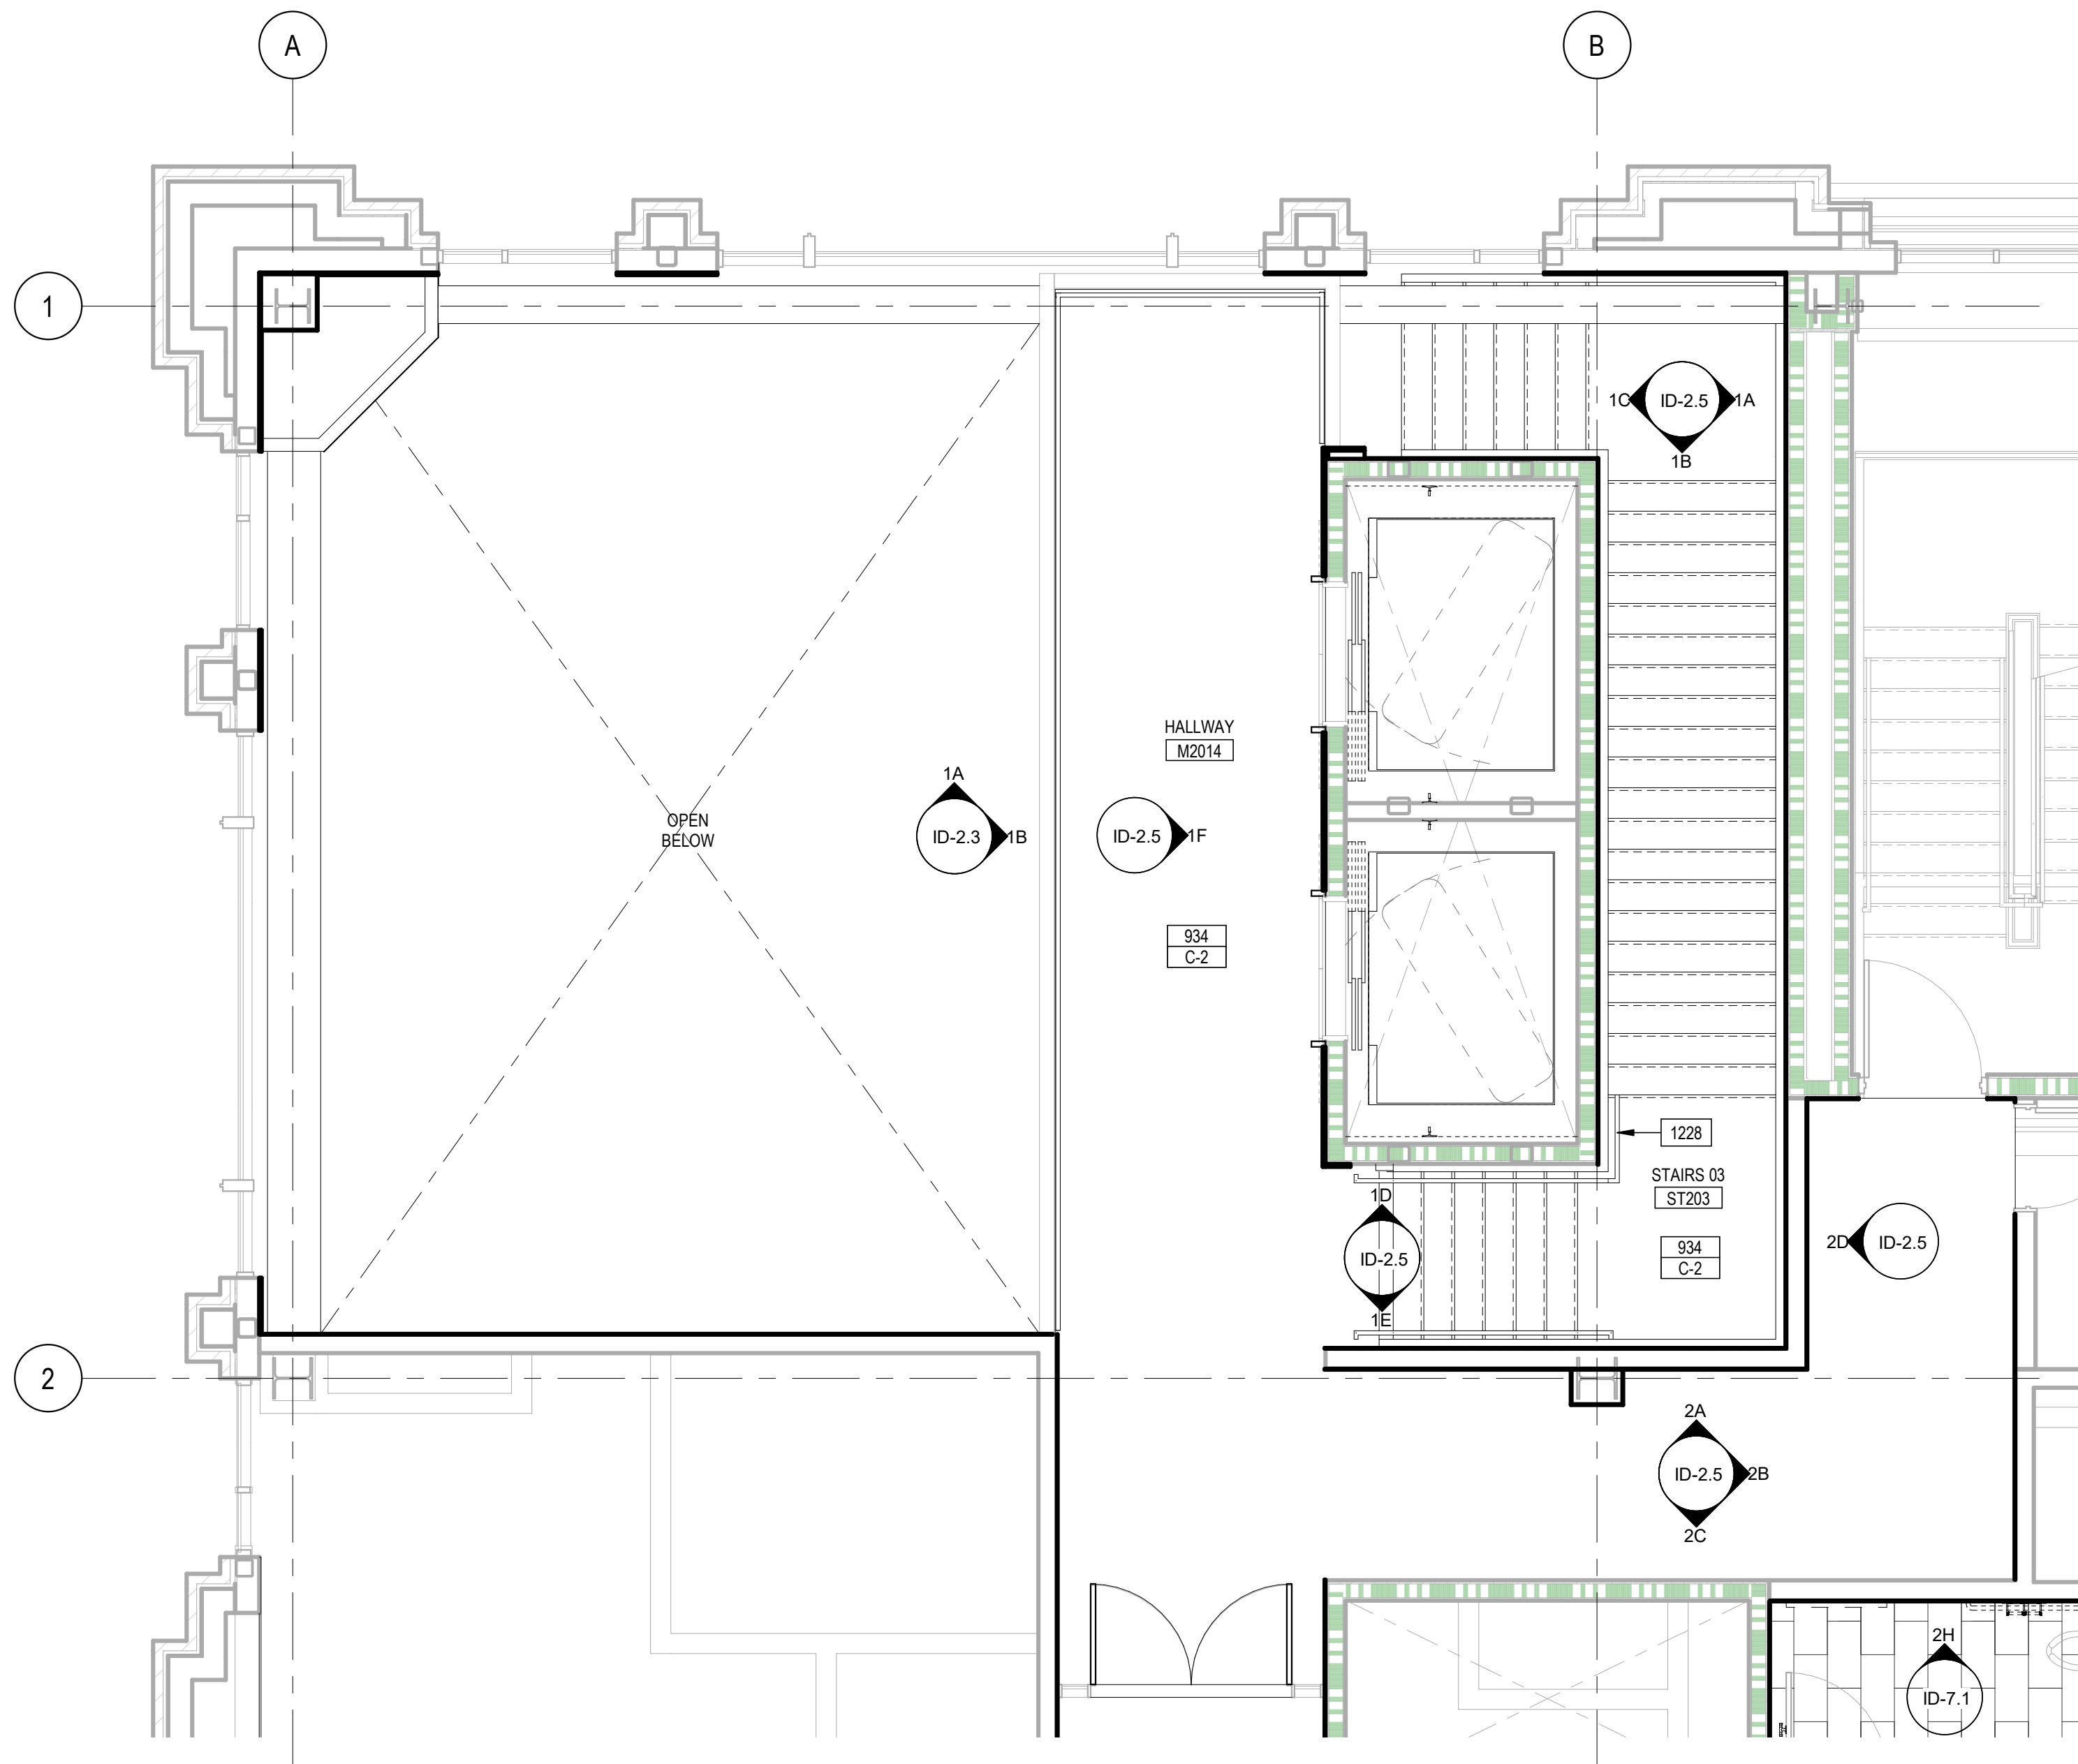

STAIR AND HALLWAY FINISH PLAN - LEVEL 2

Scale:
1/4" = 1'-0"

2

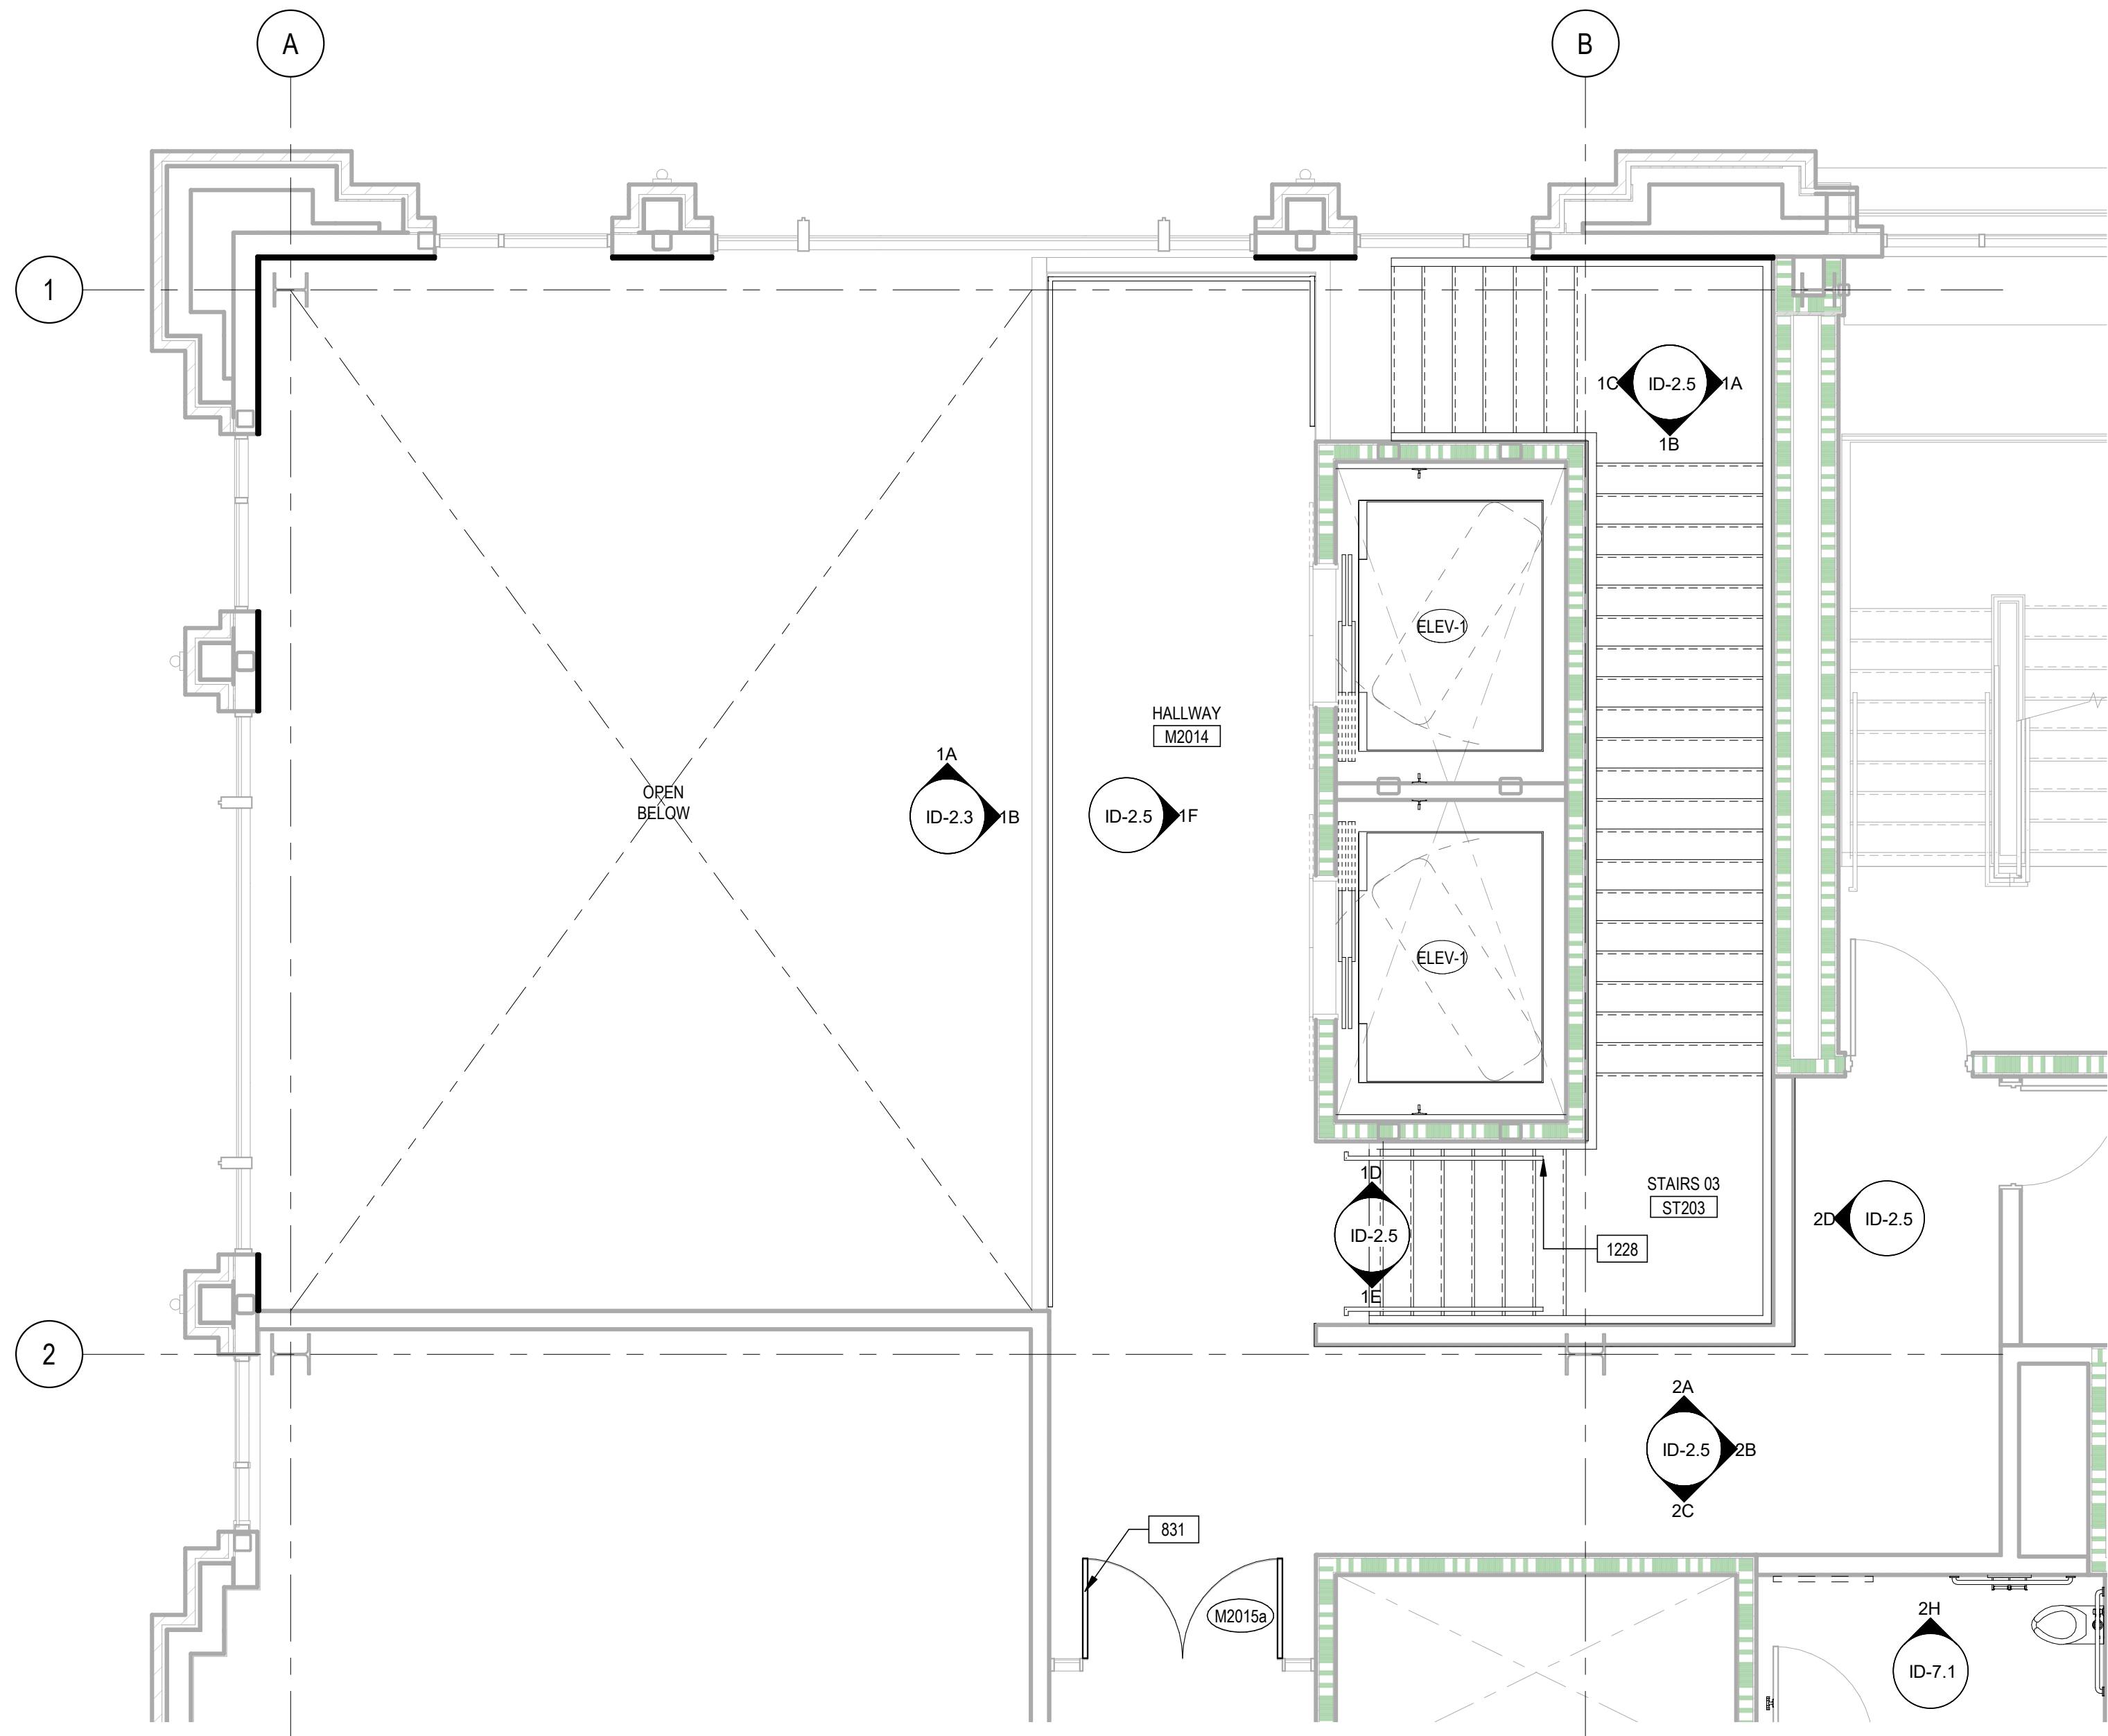

STAIR AND HALLWAY FURNISHING PLAN - LEVEL 2

Scale:
1/4" = 1'-0"

1

GENERAL NOTES

1. REFER TO SHEETS ID-T3 TO ID-T7 FOR ADA ACCESSIBILITY REQUIREMENTS NOTES AND DETAILS.

KEYNOTES

831 INTERIOR ACCESS DOOR AND DOOR PER PLAN AND DOOR SCHEDULE
934 CARPET
1228 1 1/2" DIA. HANDRAIL WITH BRACKETS

FINISH PLAN SYMBOL LEGEND

NON-RATED WALLS (SHELL SCOPE)
1 HR FIRE RATED WALLS (SHELL SCOPE)
2 HR FIRE RATED WALLS (SHELL SCOPE)

FINISH START SYMBOL

KEYNOTE REFERENCE
KEYNOTE REFERENCE
COLOR & FINISH REFERENCE

FIXTURE & FURNISHING SYMBOL LEGEND

FIXTURE AND FURNISHING REFERENCE

**PHASE II BUILDING M -
INTERIOR PACKAGE**

W 13400 S & Mountain View Corridor
Riverton, Utah 84065


LOBBY-RELATED BEING PLAN

Number: 2018-602
Deck Number: Permit Number

H E E T

L


D-2.2

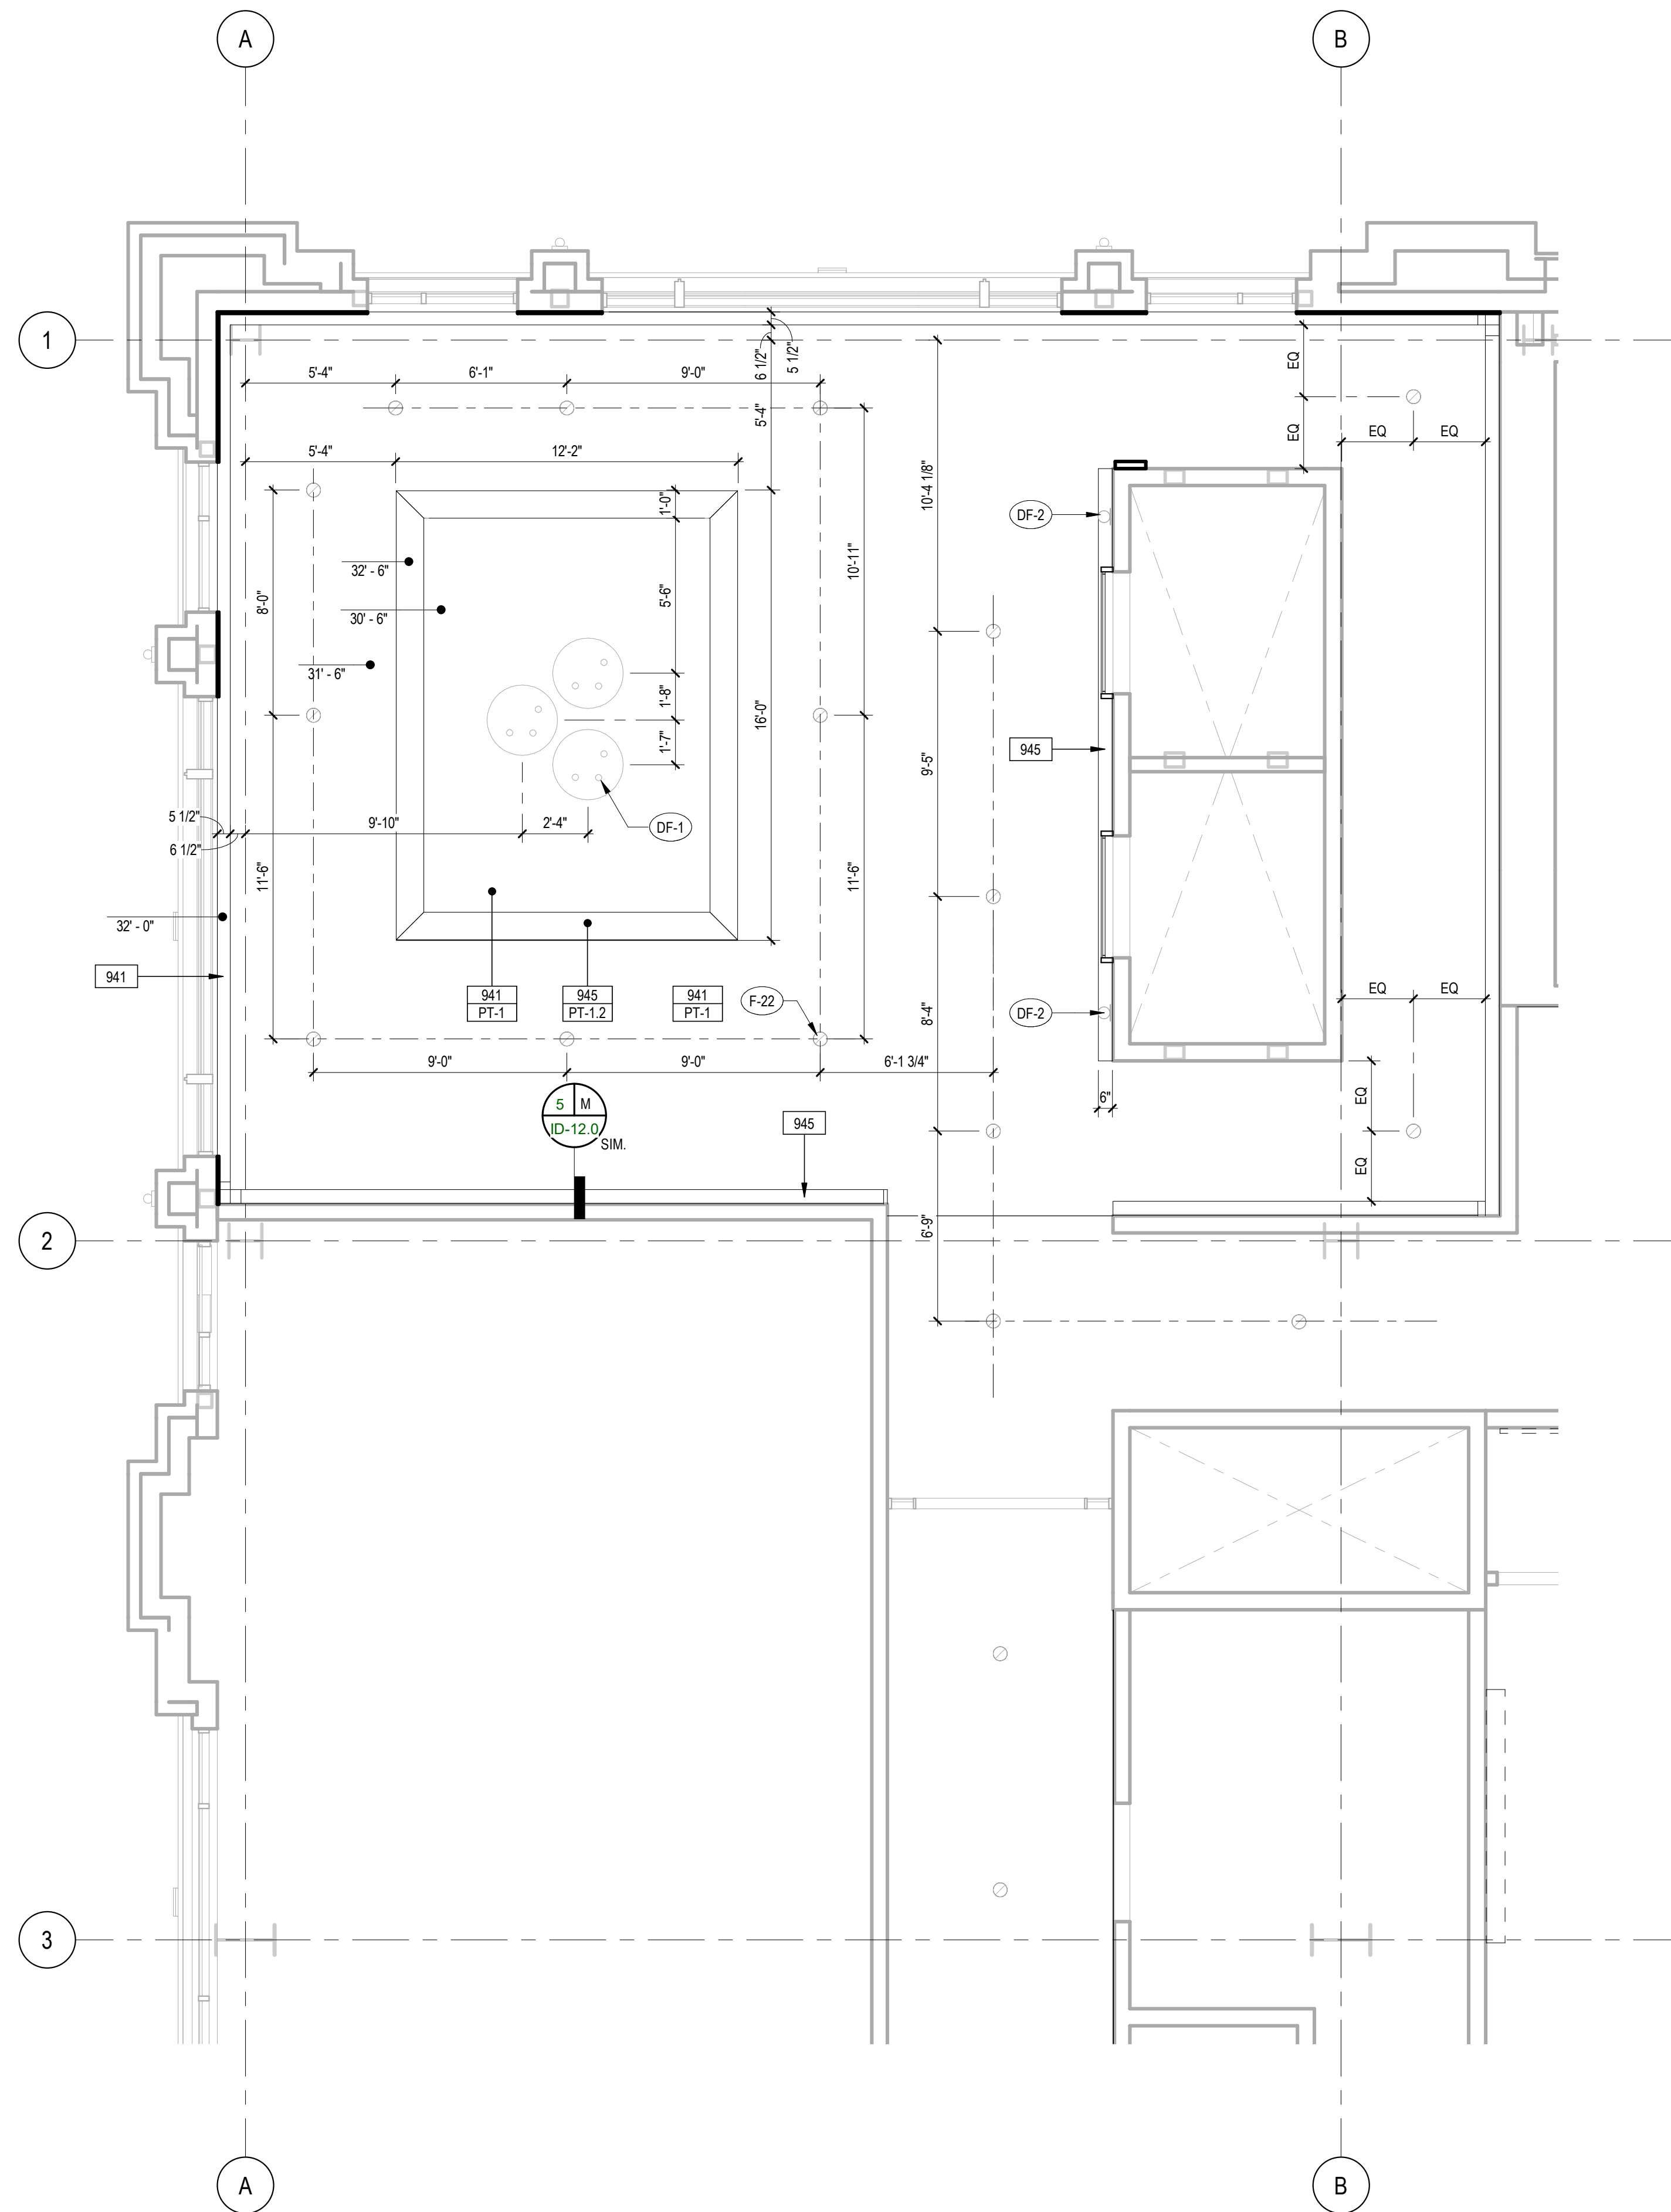

ENLARGED REFLECTED CEILING PLAN - MAIN LOBBY L2

Scale:
1/4" = 1'-0"

2

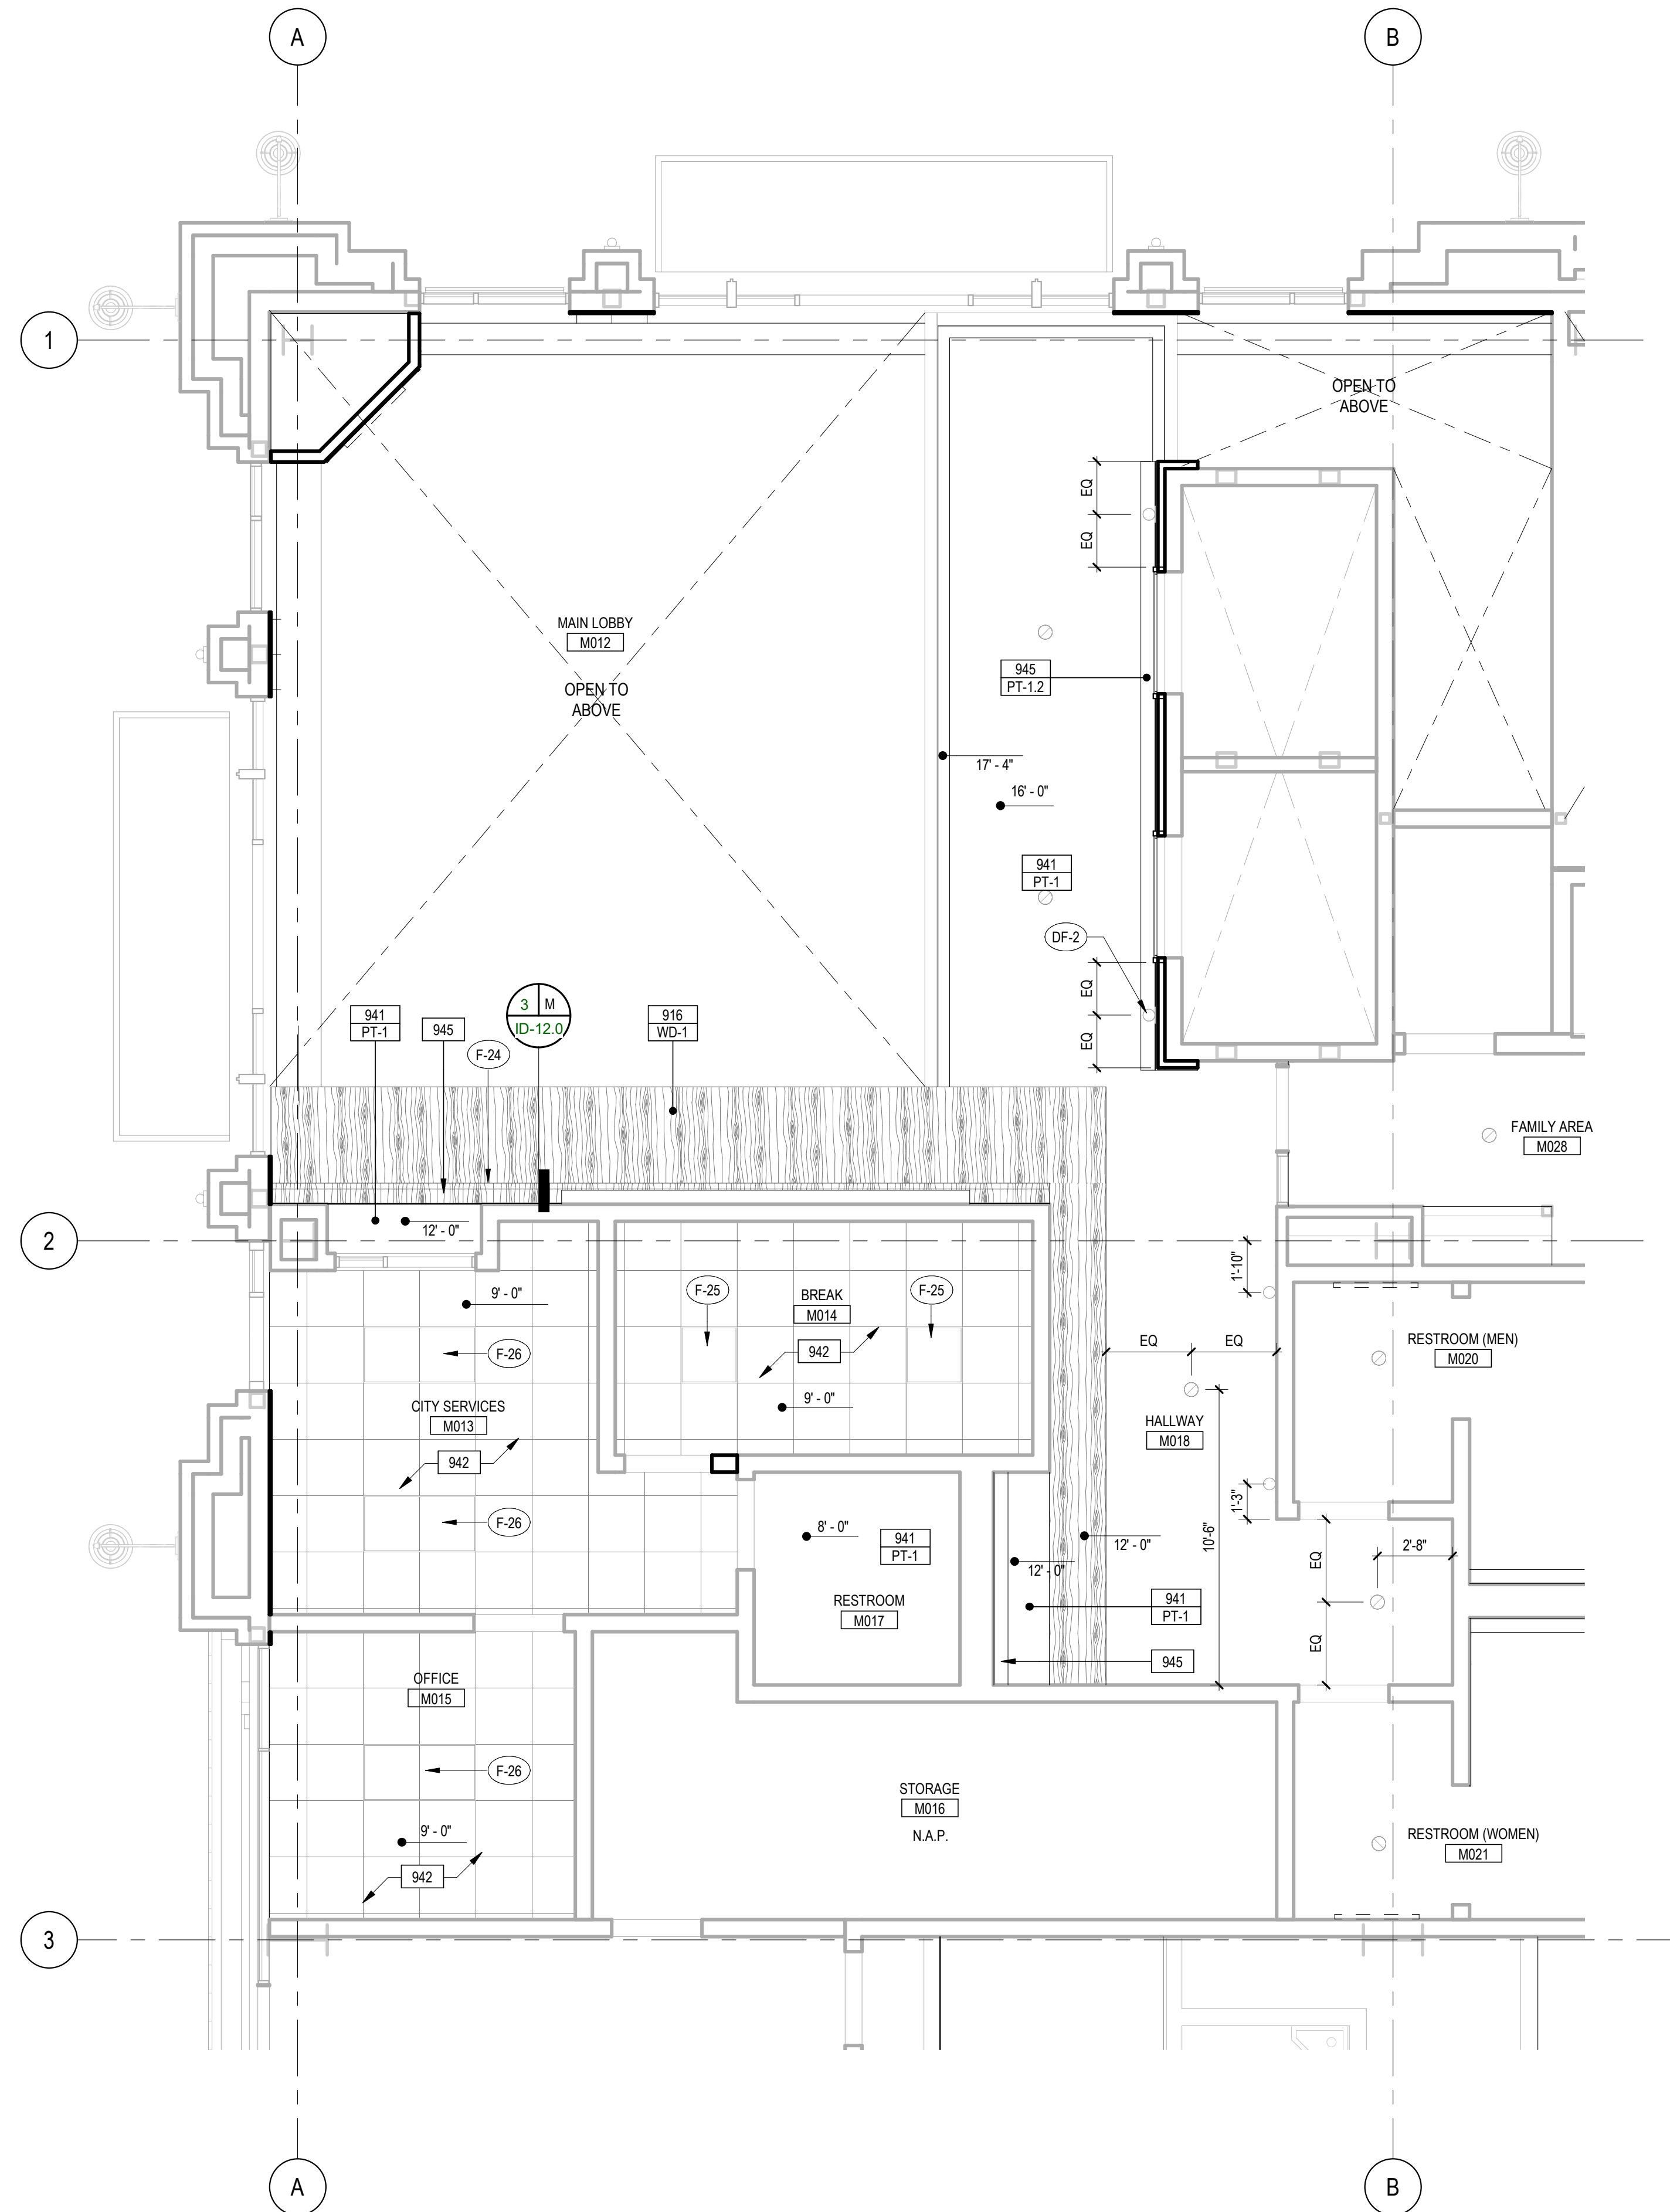

ENLARGED REFLECTED CEILING PLAN - MAIN LOBBY, SERVICE, OFFICE & BREAK


Scale:
1/4" = 1'-0"

1

KEYNOTES


- 916 WOOD FINISH
941 PAINTED CEILING
942 ACOUSTICAL CEILING TILE
945 CEILING LIGHT COVE. PAINT TO MATCH ADJ. SURFACE OR OTHERWISE
INDICATED

RCP SYMBOL LEGEND

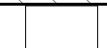
-
-  ELECTRICAL J-BOX, SEE ELECTRICAL PLANS
 COVE LIGHTING
 WALL MOUNTED SCONCE LIGHT FIXTURE
 WALL MOUNTED SCONCE LIGHT FIXTURE
 RECESSED LIGHT FIXTURE

 ← KEYNOTE
 ← COLOR AND FINISH


1	← KEYNOTE
A	← COLOR AND FINISH

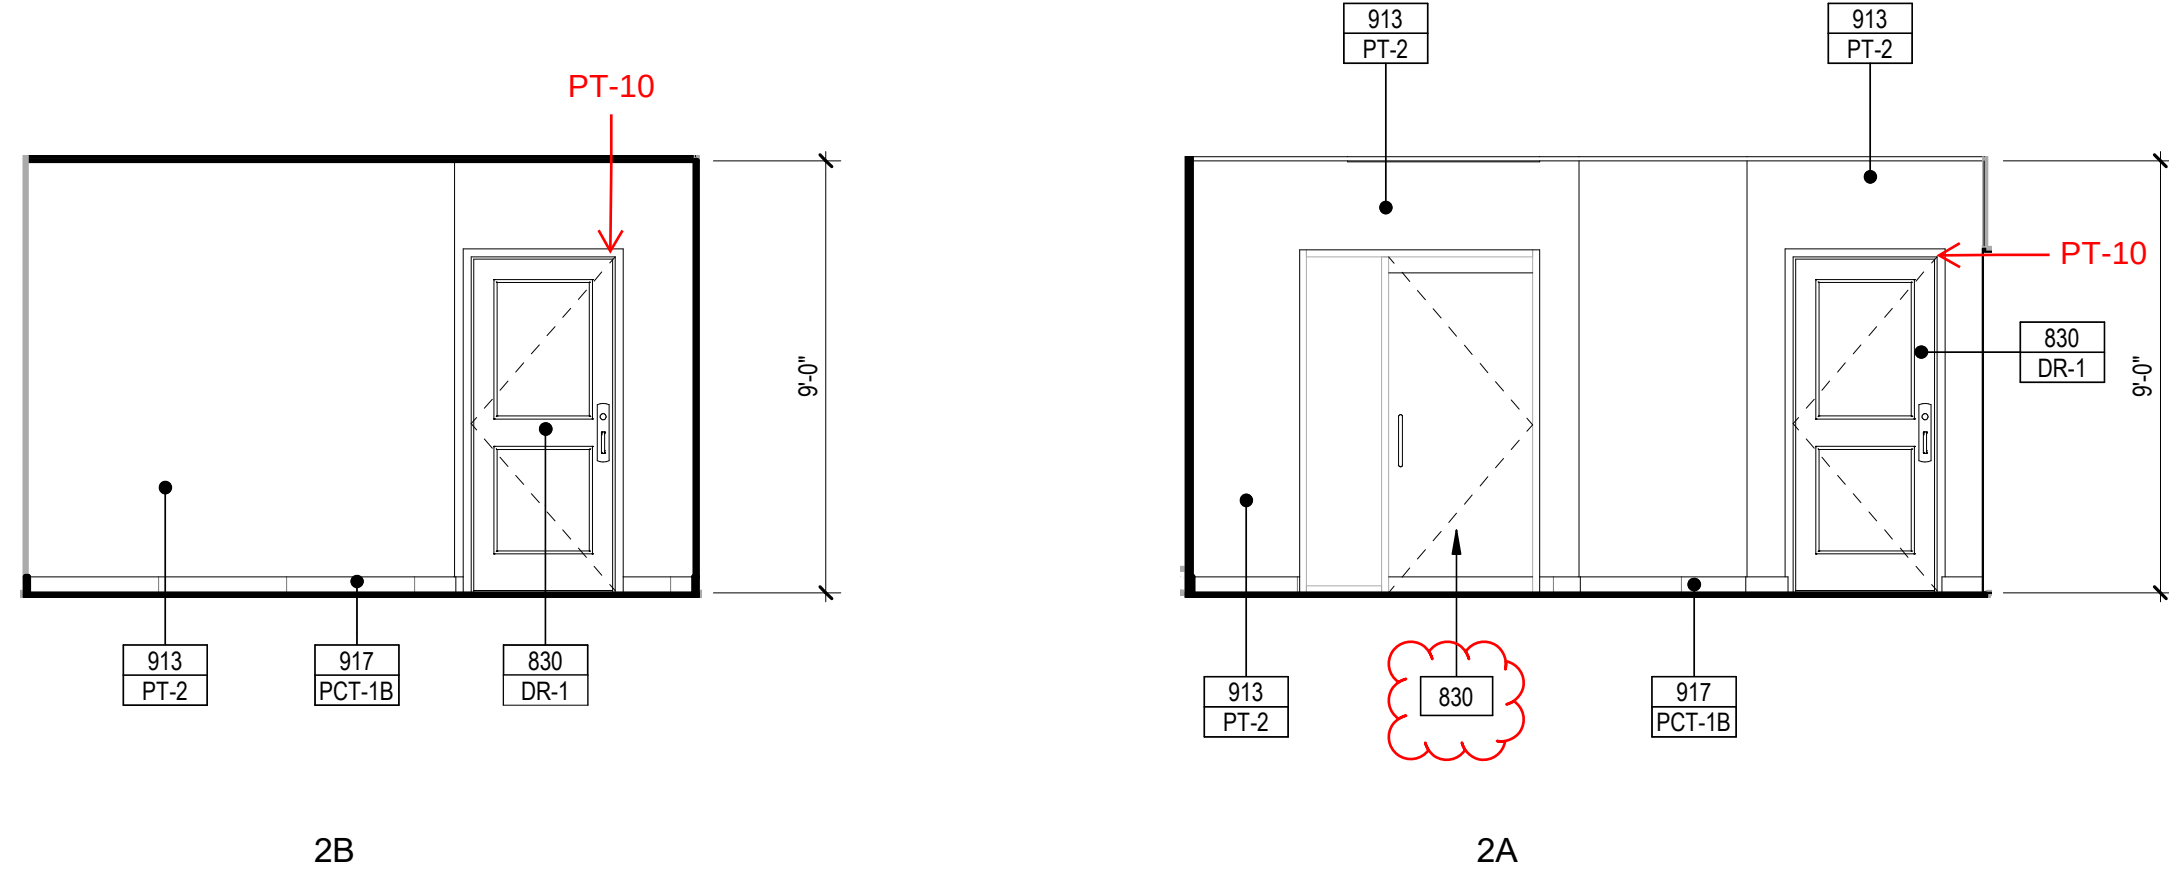

CITY SERVICES M013 - INTERIOR ELEVATIONS	Scale: 1/4"	2
---	----------------	----------

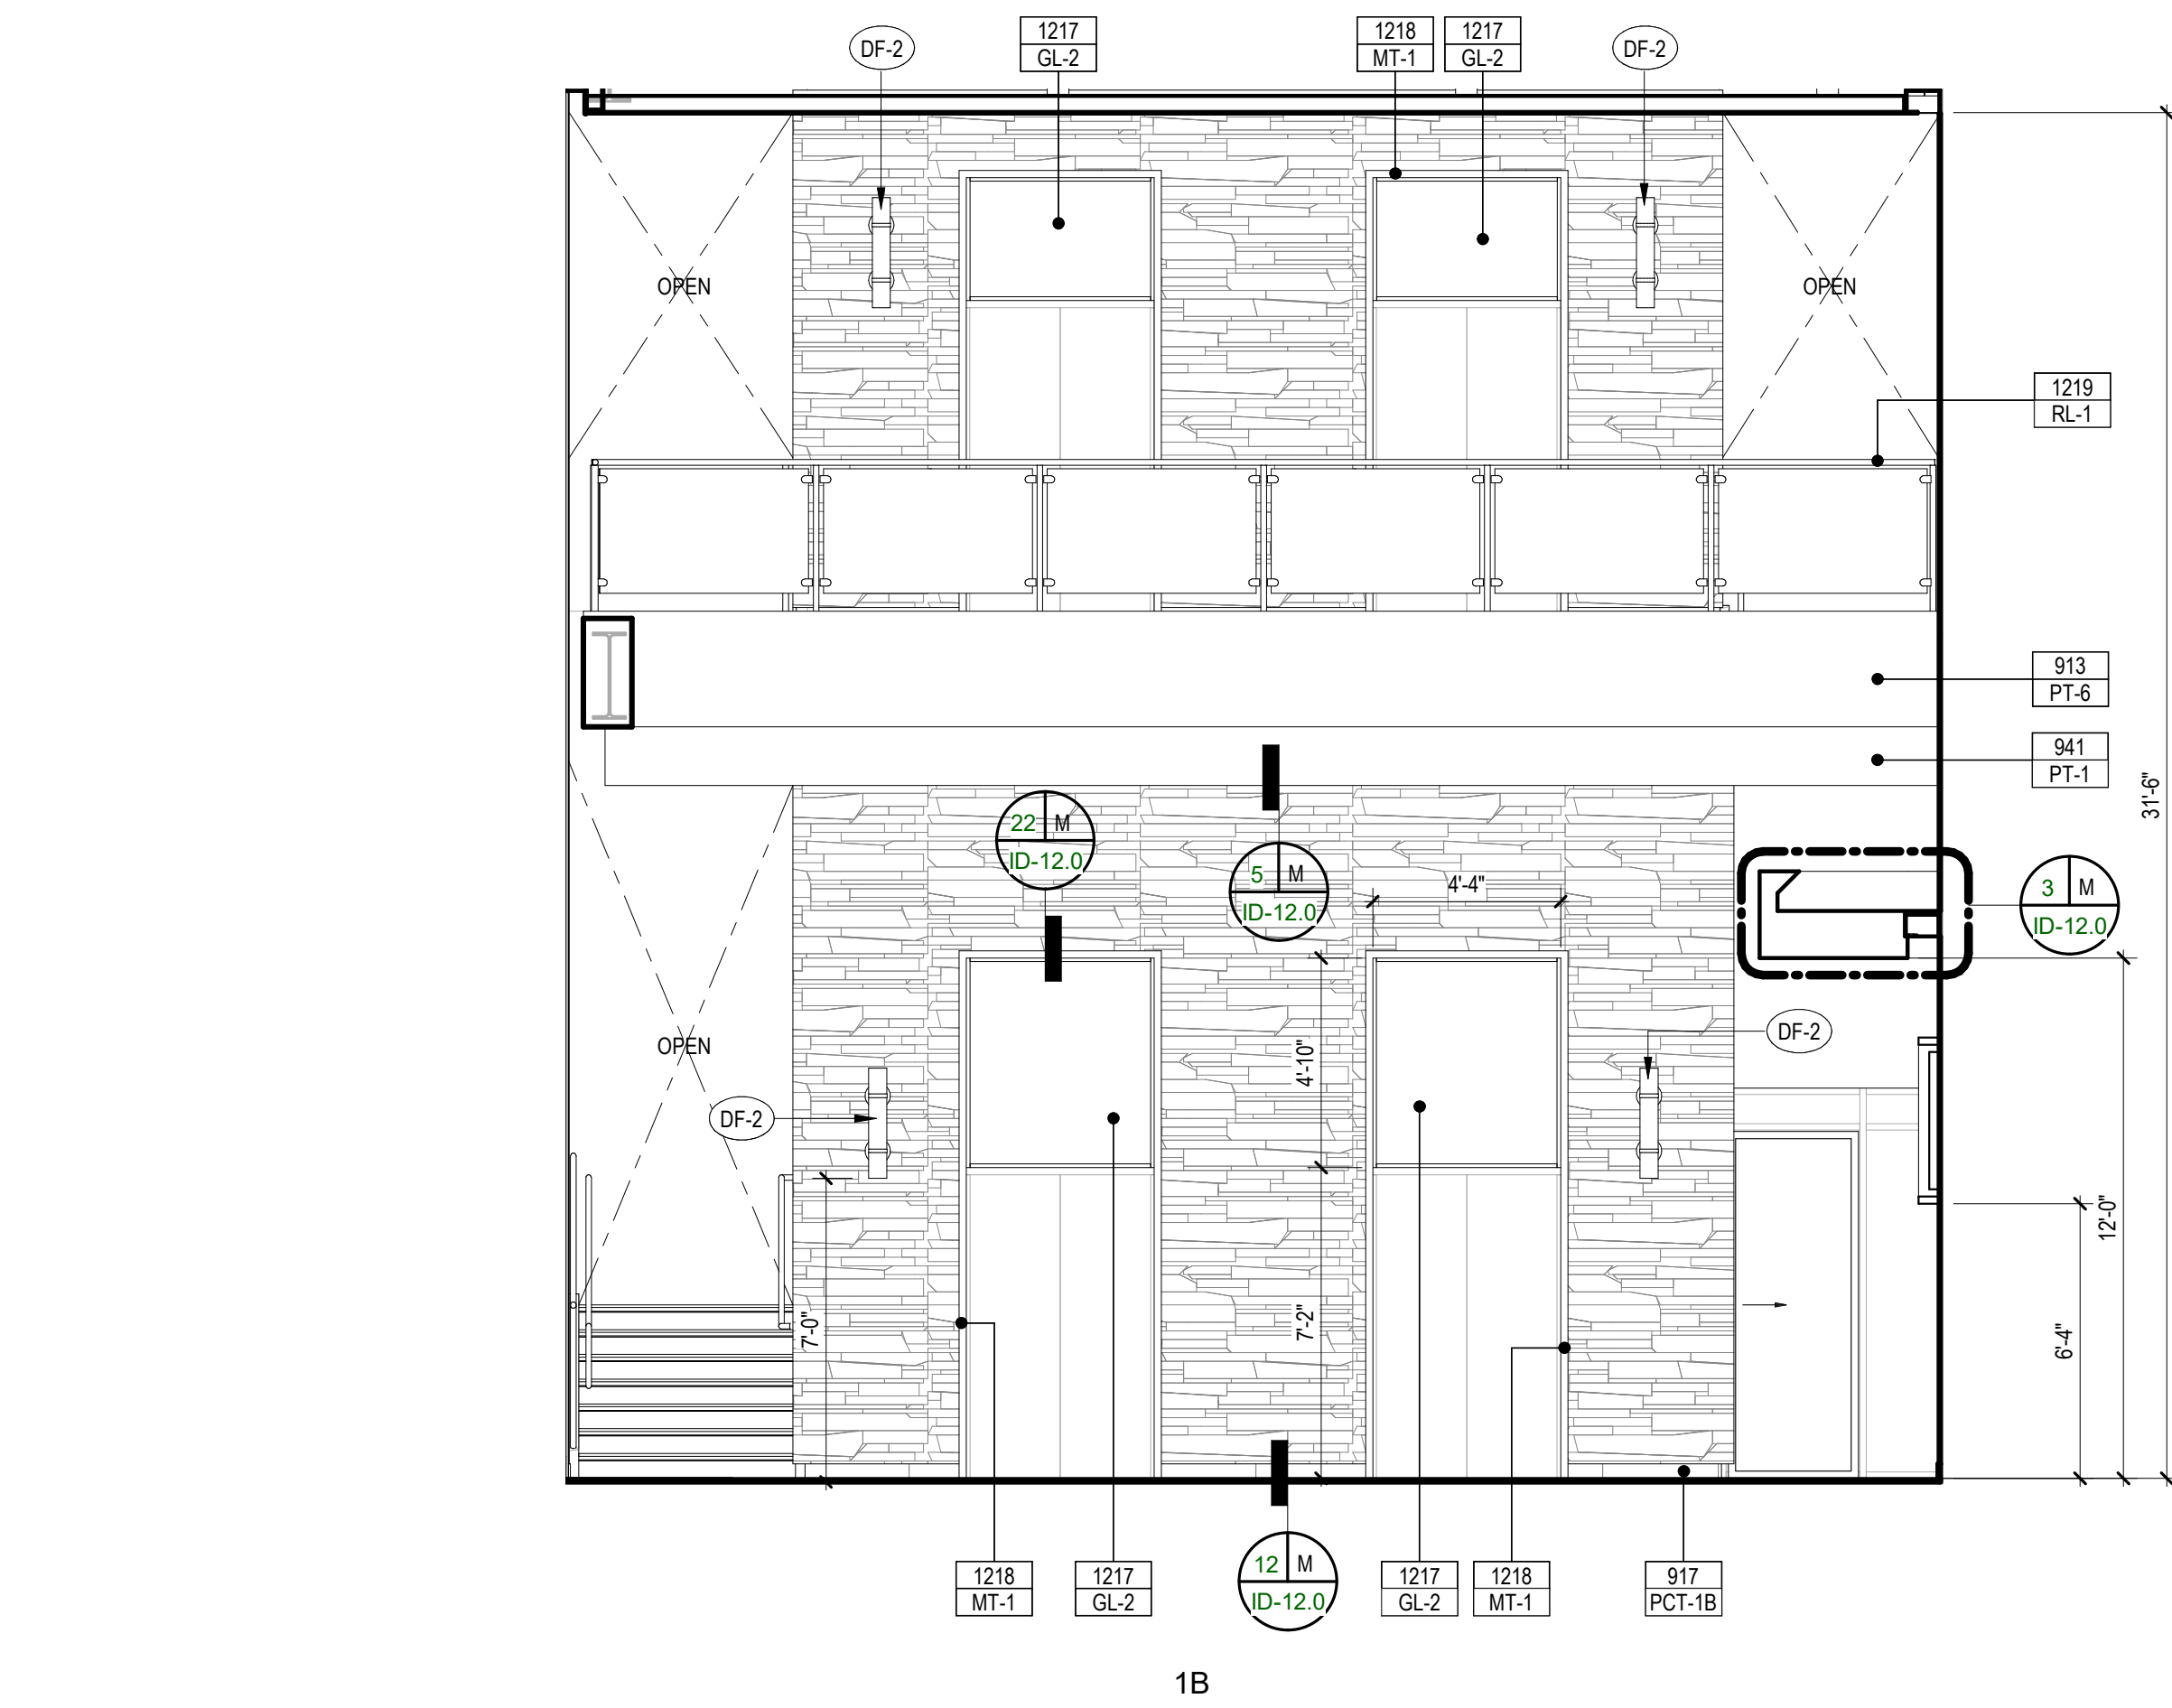

1B

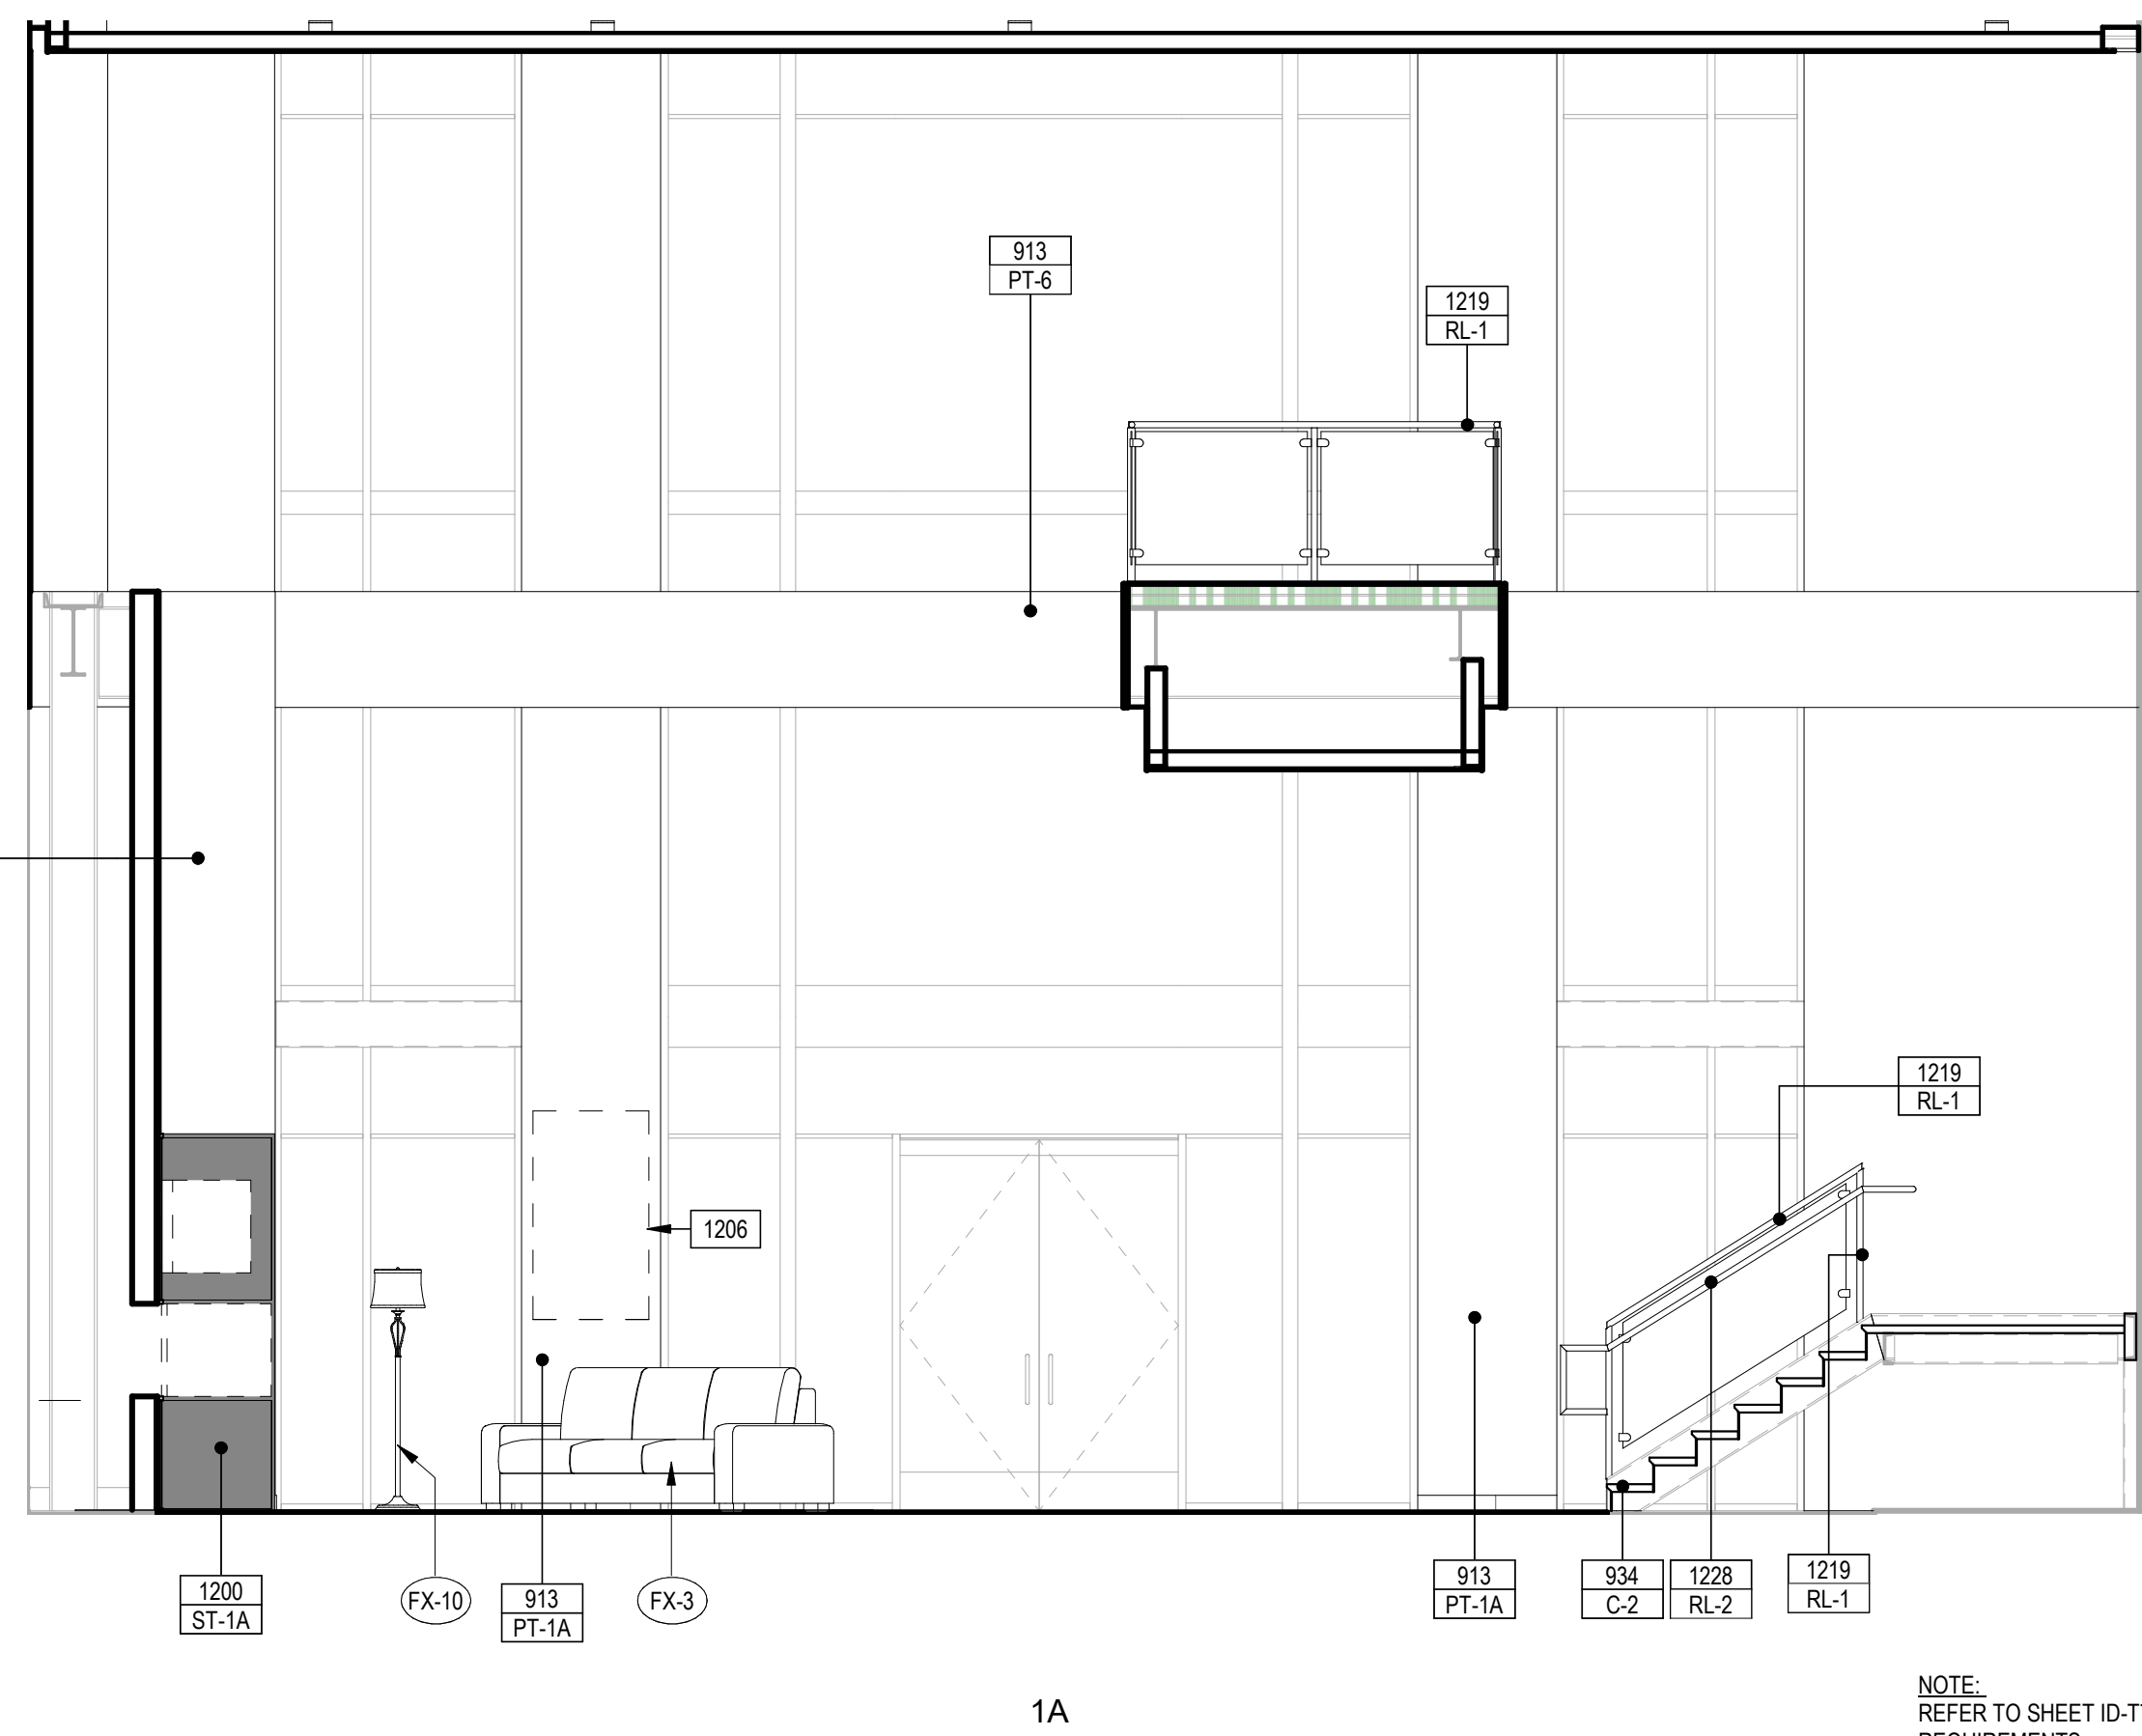


MAIN LOBBY M012 - INTERIOR ELEVATIONS Scale: 1/4" **1**

	KEYNOTES
830	DOOR PER PLAN AND DOOR SCHEDULE
913	PAINT
914	WALLCOVERING
915	WALL DIGITAL GRAPHICS
916	WOOD FINISH
917	4" TILE WALL BASE
934	CARPET
941	PAINTED CEILING
1200	FIRE PLACE
1202	RECEPTION DESK
1206	WALL SIGN CONTRACTOR TO PROVIDE CONTINUOUS 2X BLOCKING IN WALL AND J-BOX
1217	DECORATIVE GLASS PANEL
1218	METAL FRAME
1219	42" HIGH GLASS RAILING SYSTEM
1225	TV SCREEN
1228	1 1/2" DIA. HANDRAIL WITH BRACKETS

ELEVATION SYMBOL LEGEND


 ← KEYNOTE REFERENCE
 ← KEYNOTE REFERENCE
 ← COLOR & FINISH REFERENCE
 ← FIXTURE AND FURNISHING REFERENCE

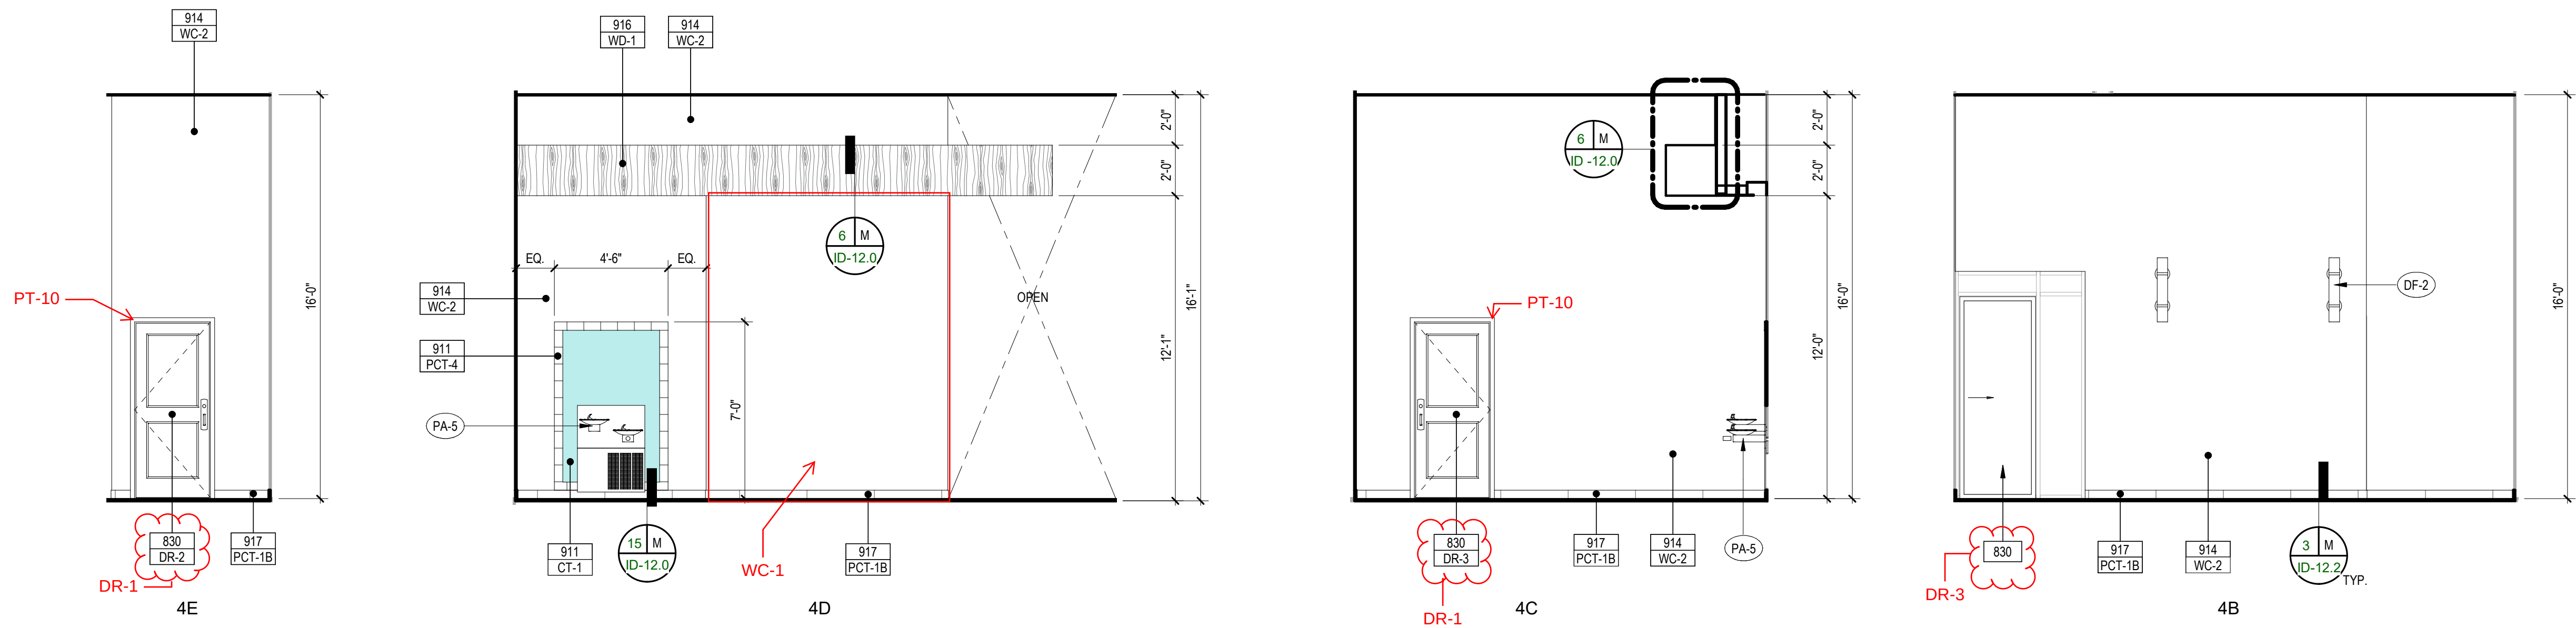

HALLWAY M018 - INTERIOR ELEVATIONS

Scale: 1/4" = 1'-0"


4

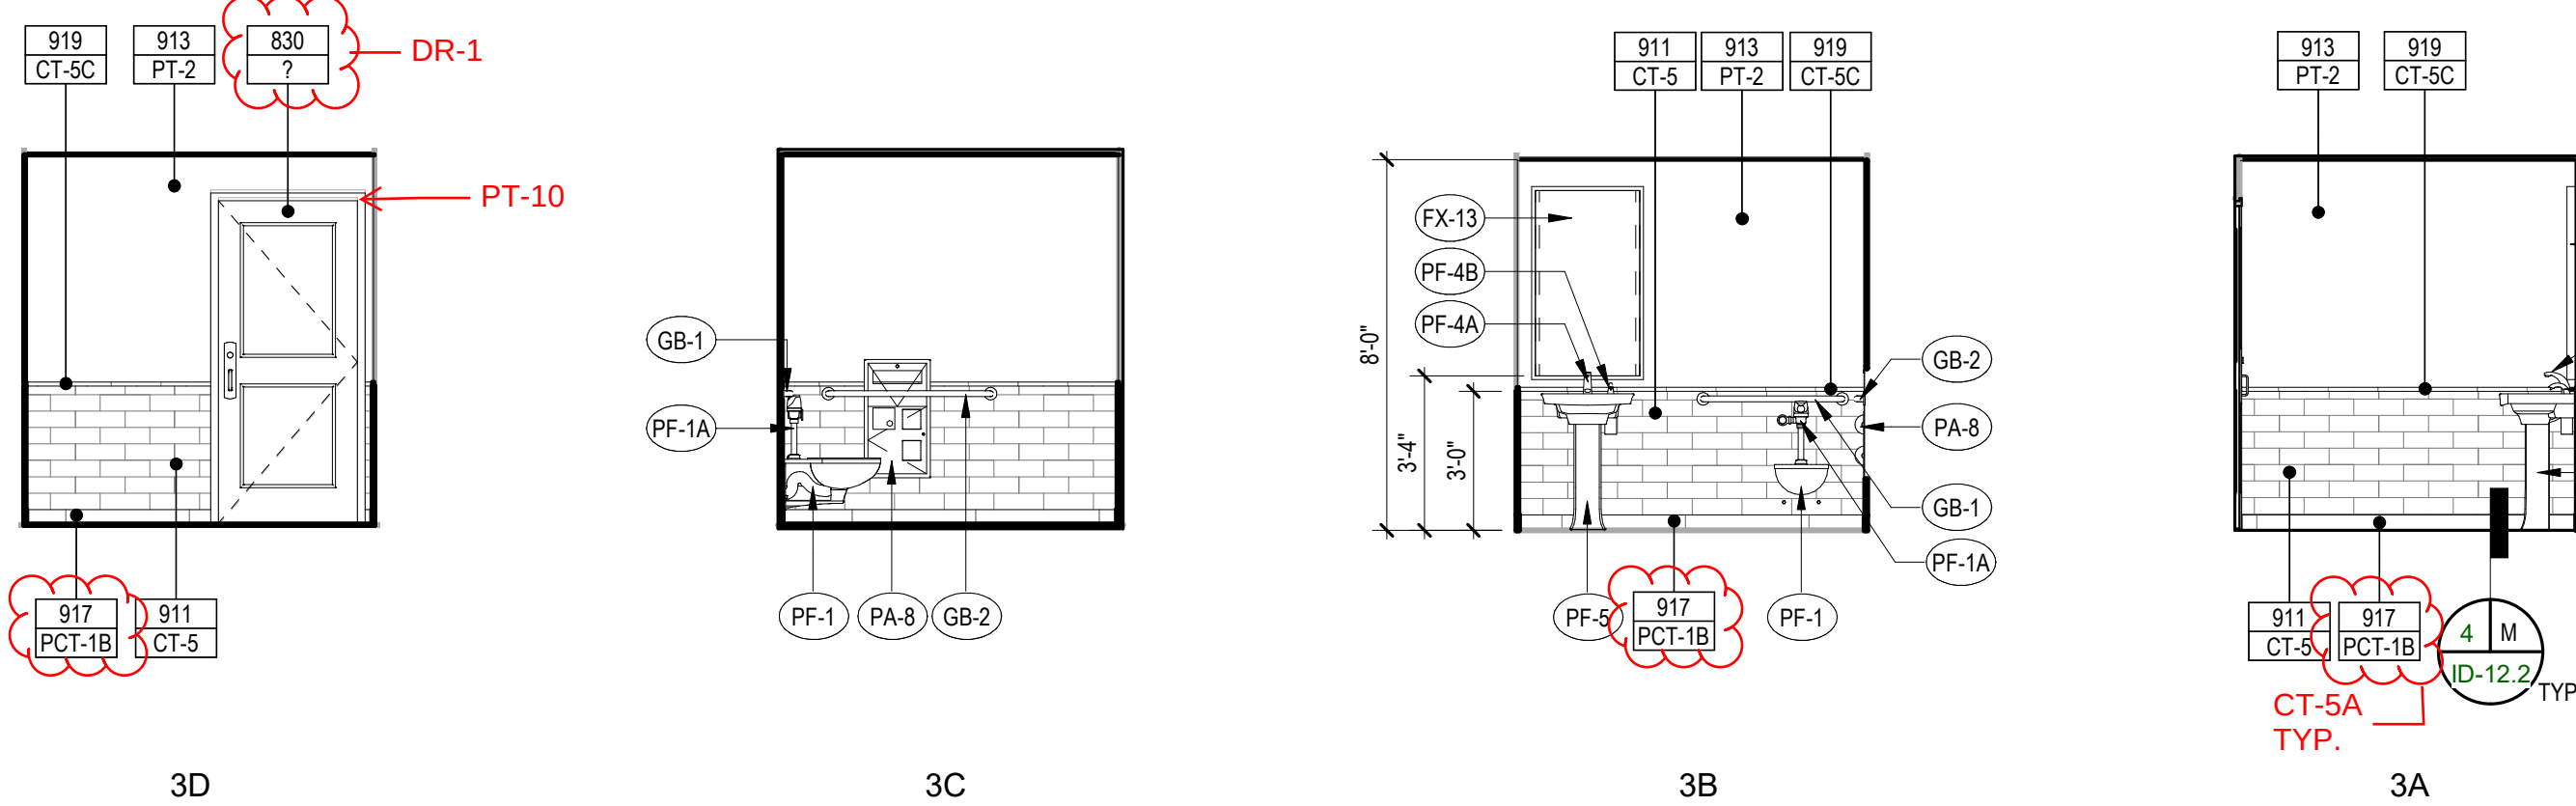

RESTROOM M017 - INTERIOR ELEVATIONS

Scale: 1/4" = 1'-0"


3

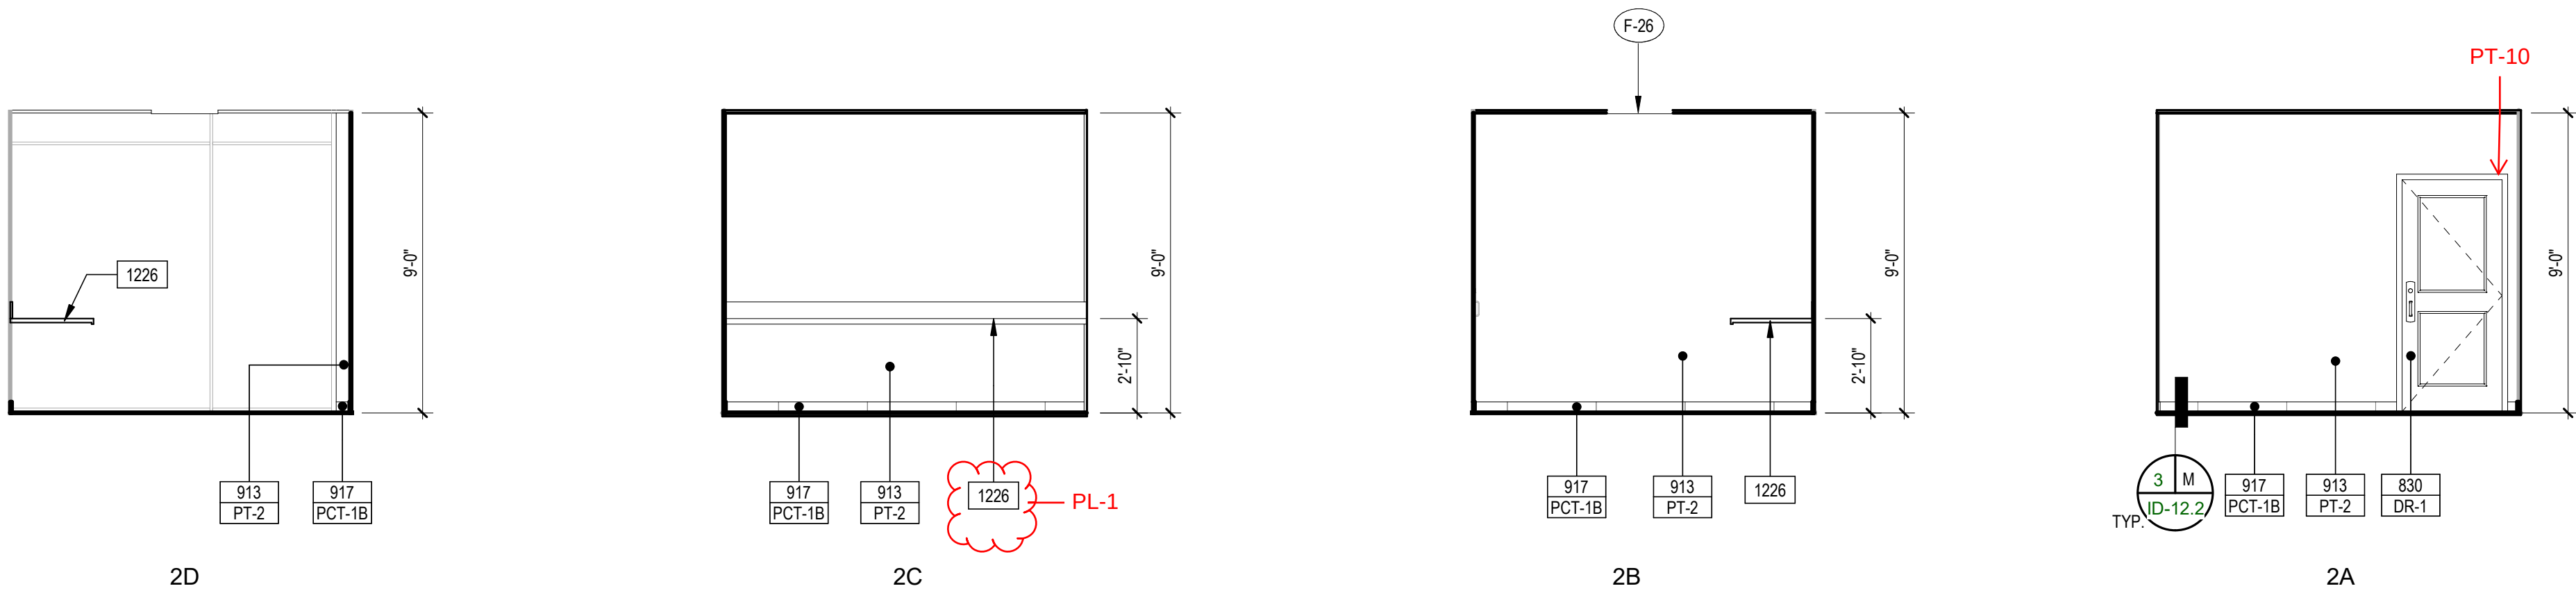

OFFICE M015 - INTERIOR ELEVATIONS

Scale: 1/4" = 1'-0"

2

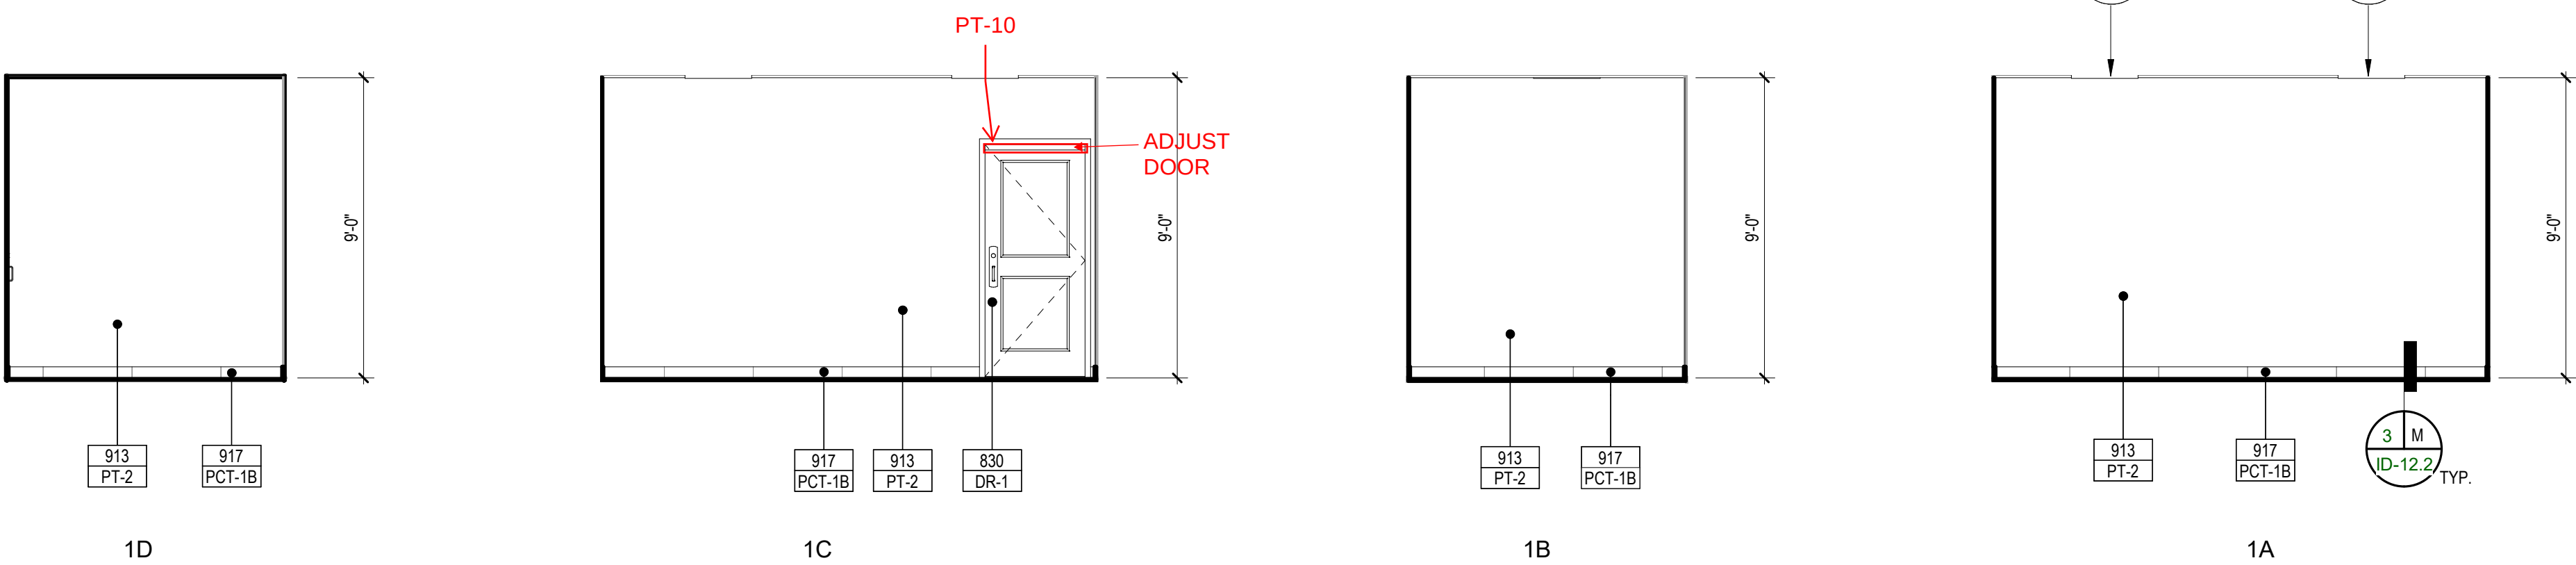

BREAK M014 - INTERIOR ELEVATIONS

Scale: 1/4" = 1'-0"





1

KEYNOTES

- 830 DOOR PER PLAN AND DOOR SCHEDULE
911 PORCELAIN TILE
913 PAINT
914 WALLCOVERING
916 WOOD FINISH
917 4" TILE WALL BASE
919 TILE TRIM
1226 CASEWORK

ELEVATION SYMBOL LEGEND







- ### KEYNOTE REFERENCE
KEYNOTE REFERENCE
XX-# COLOR & FINISH REFERENCE
FIXTURE AND FURNISHING REFERENCE

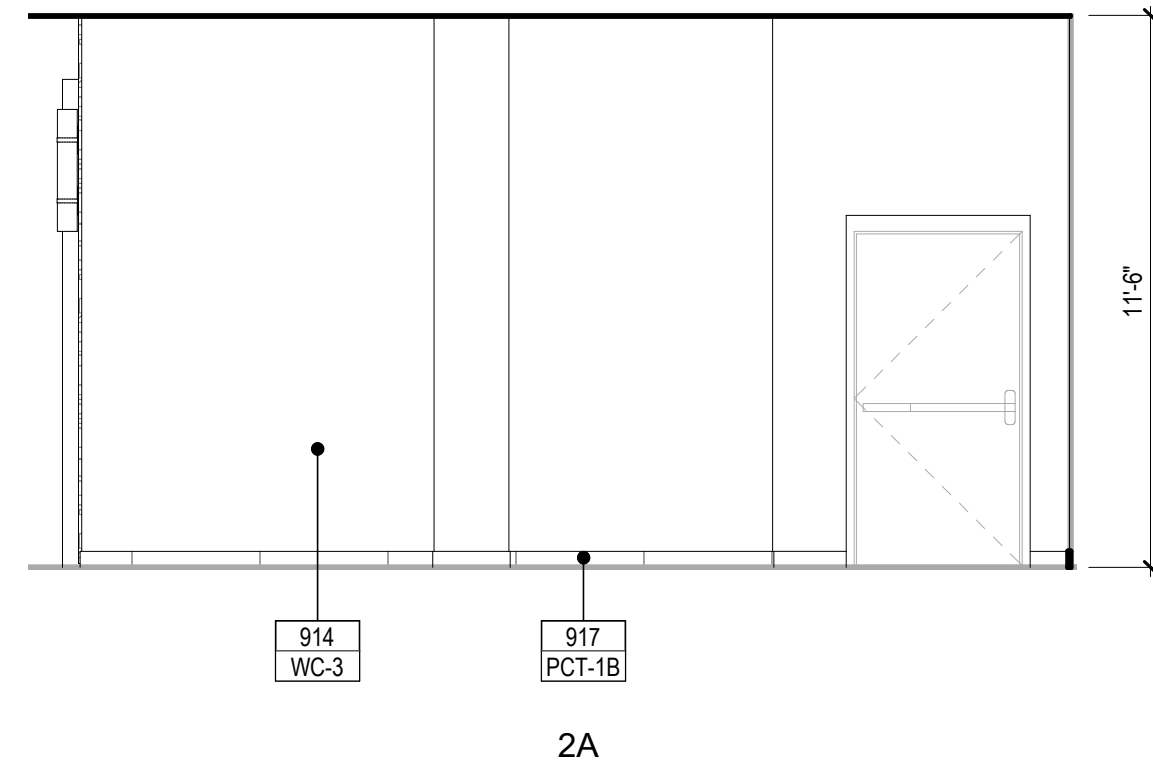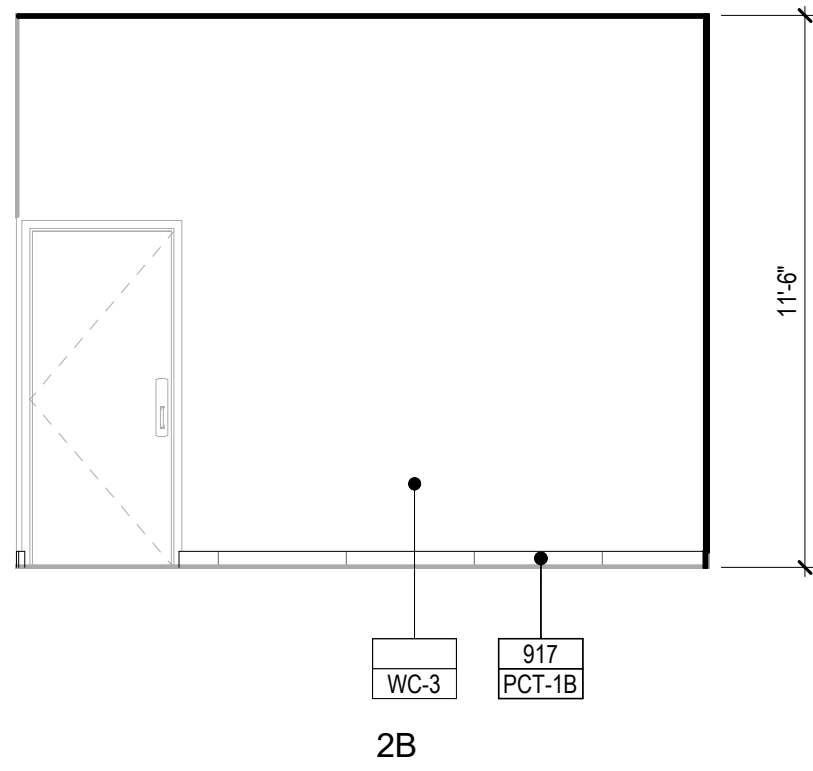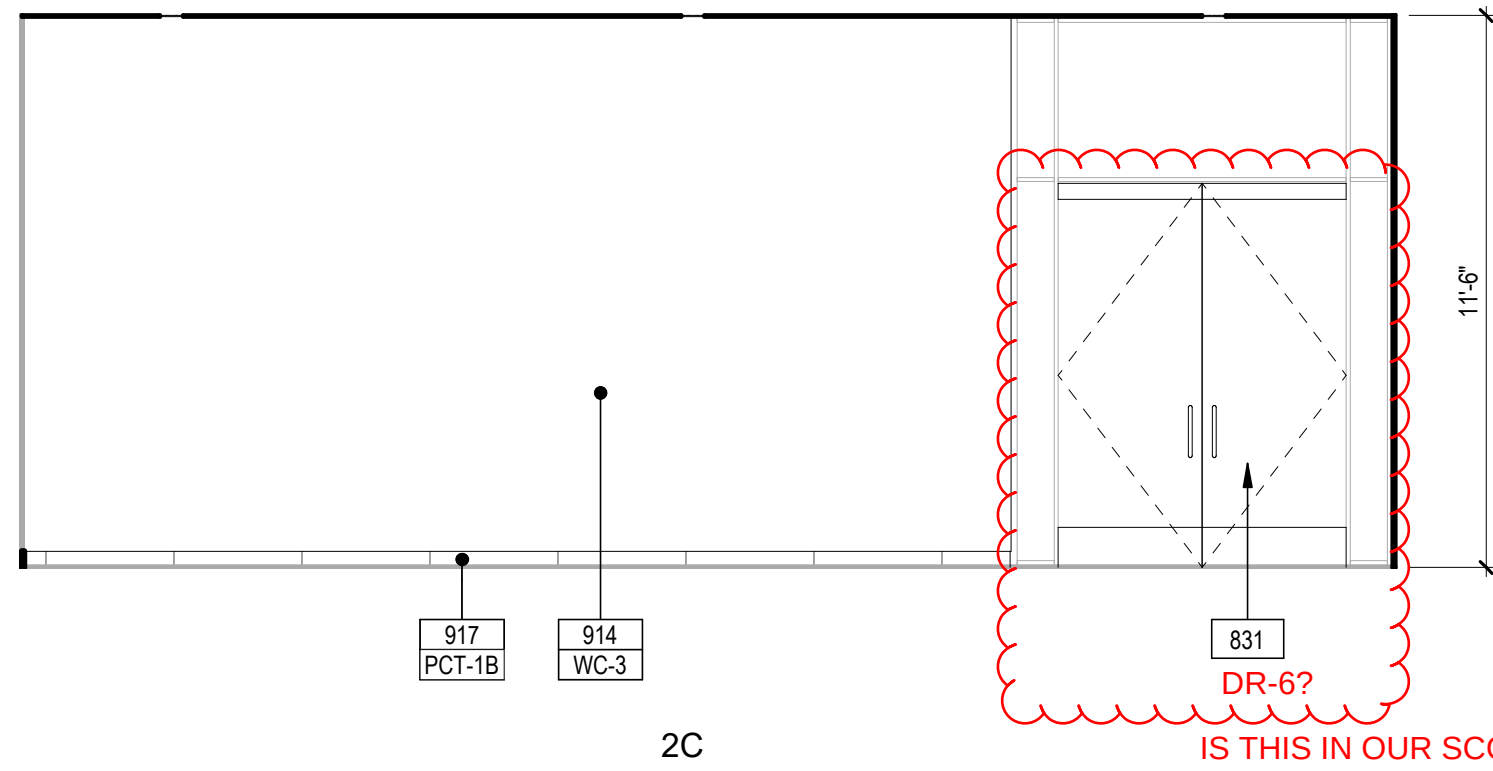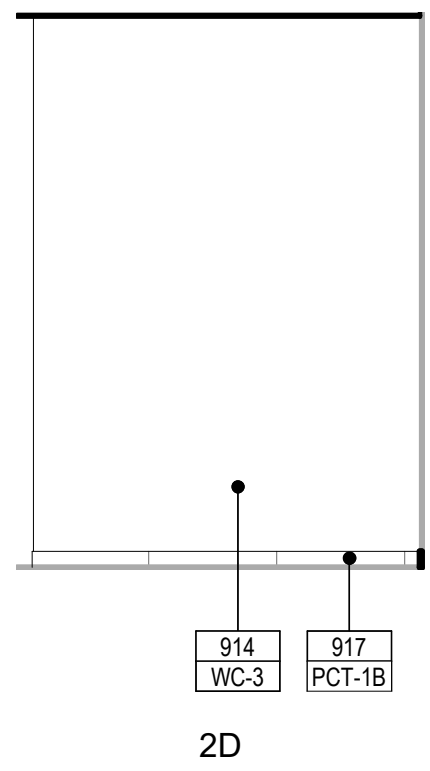

HALLWAY M2014 - INTERIOR ELEVATIONS

Scale:
1/4"

2

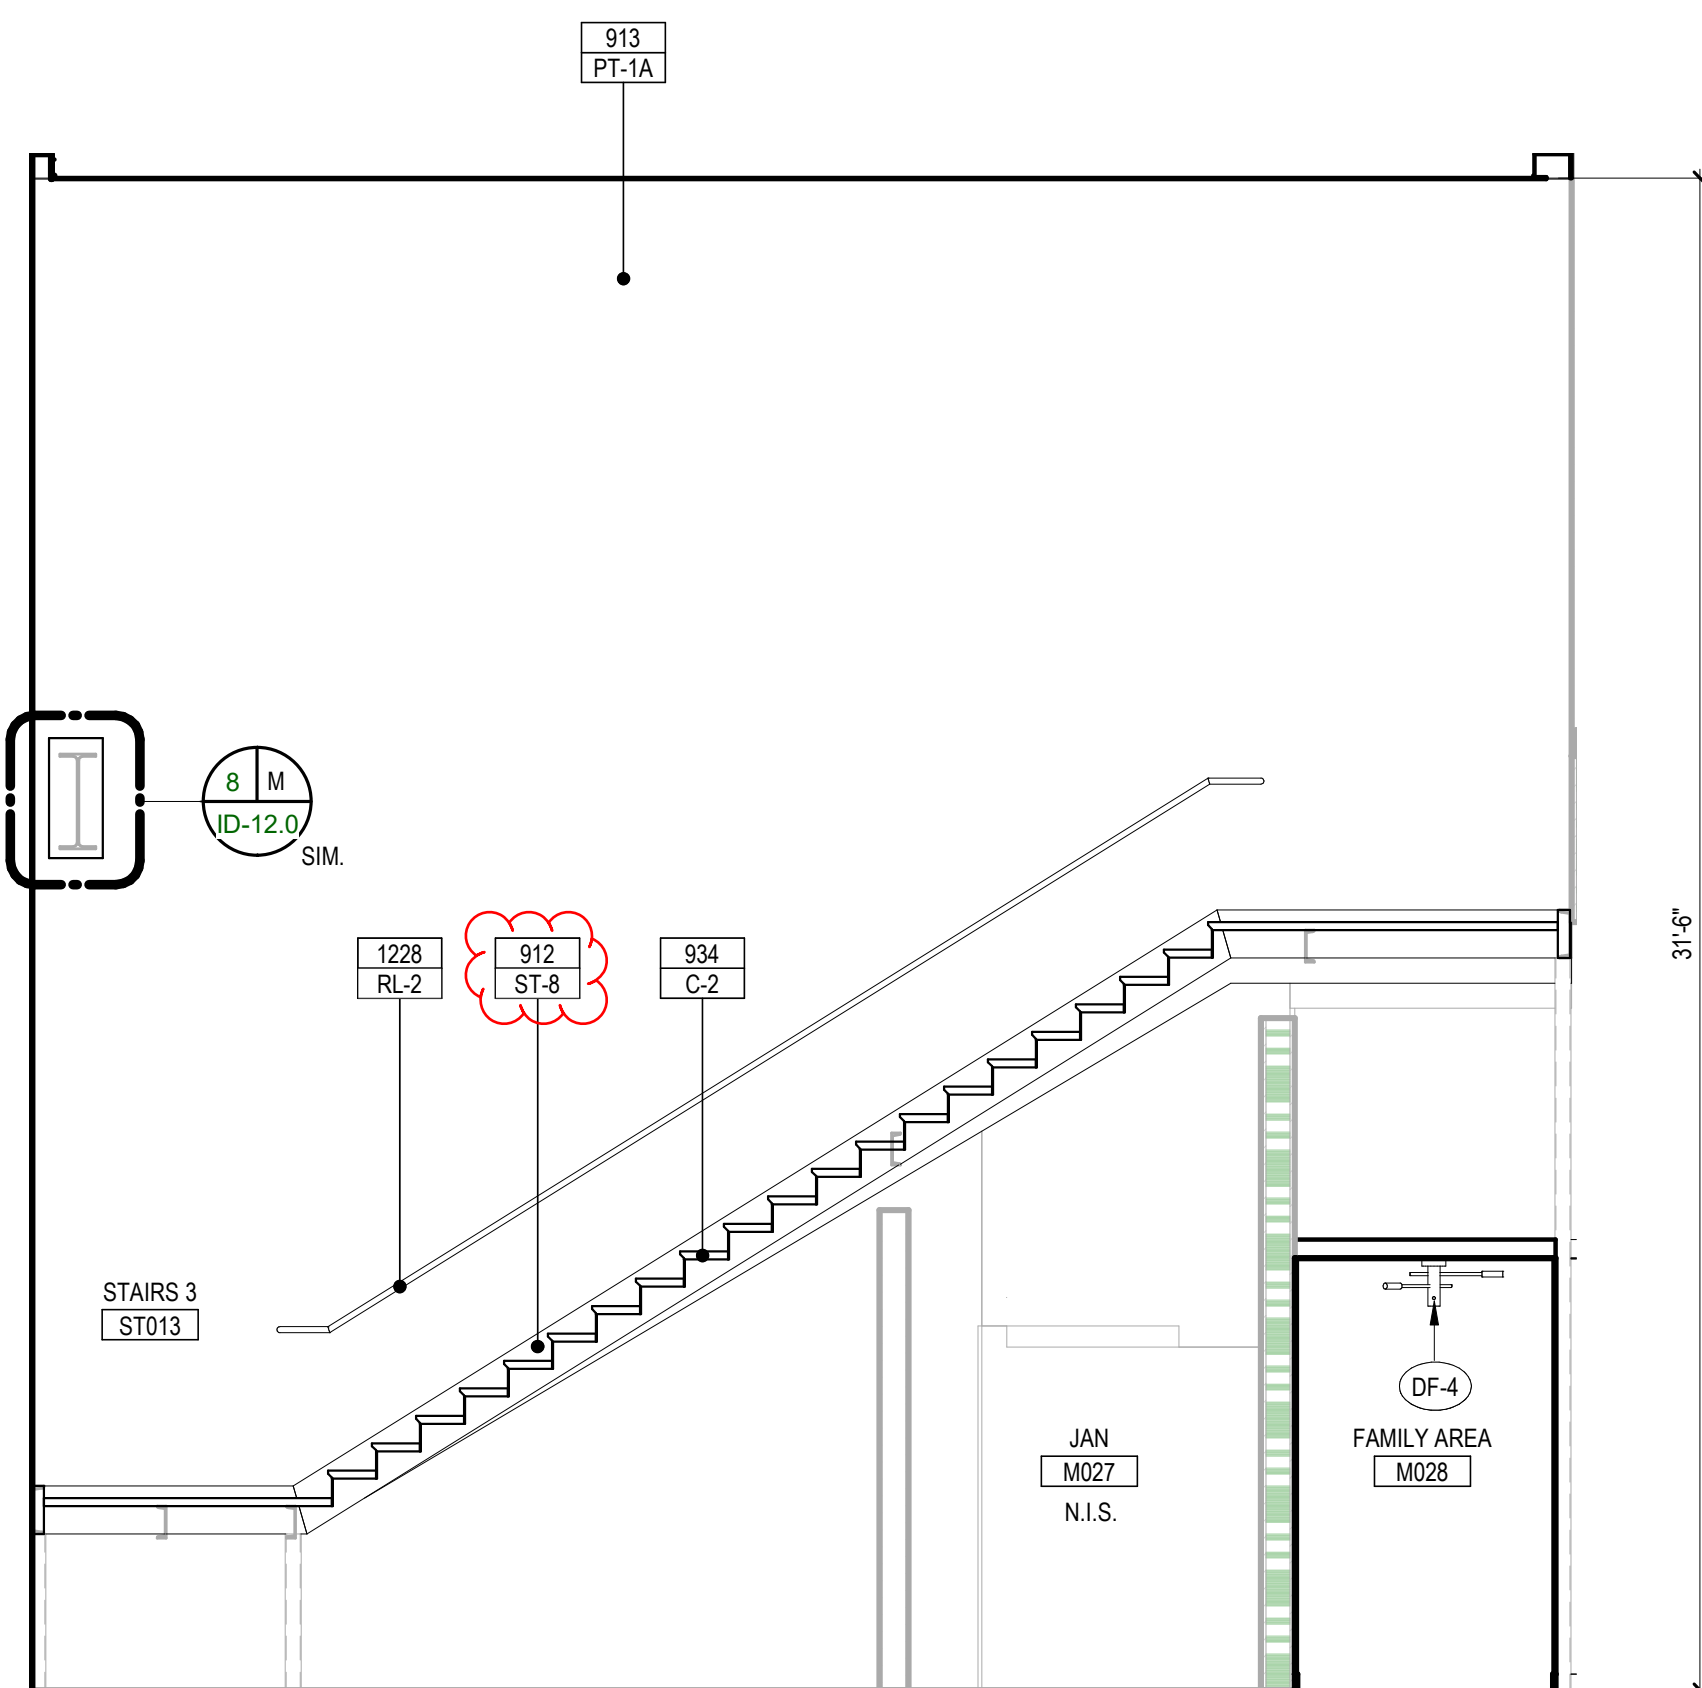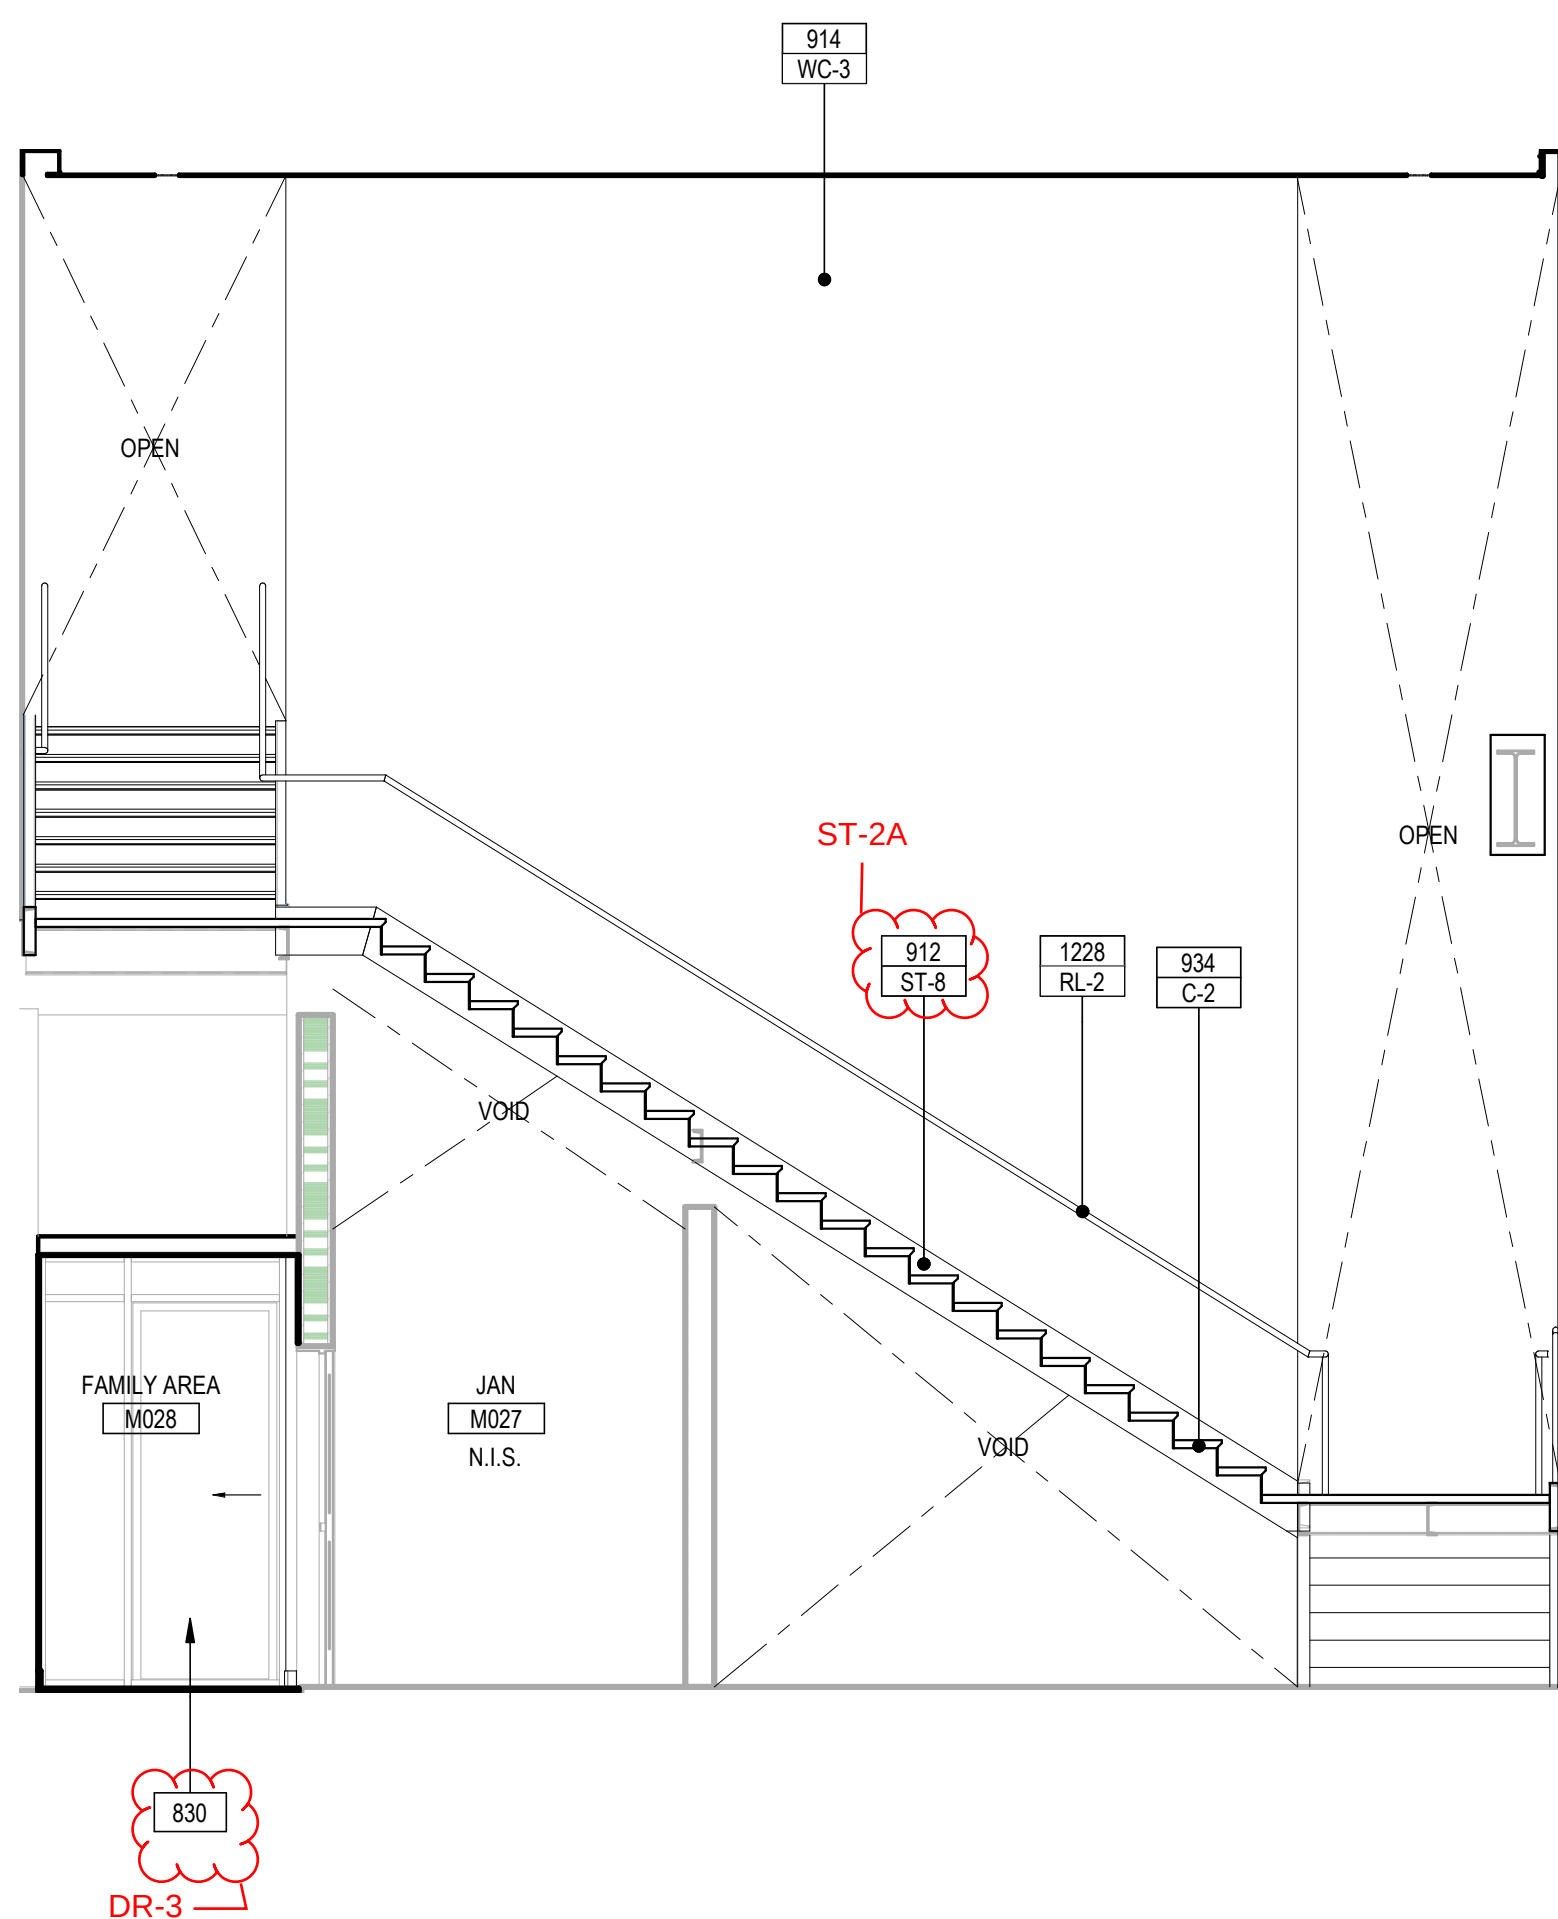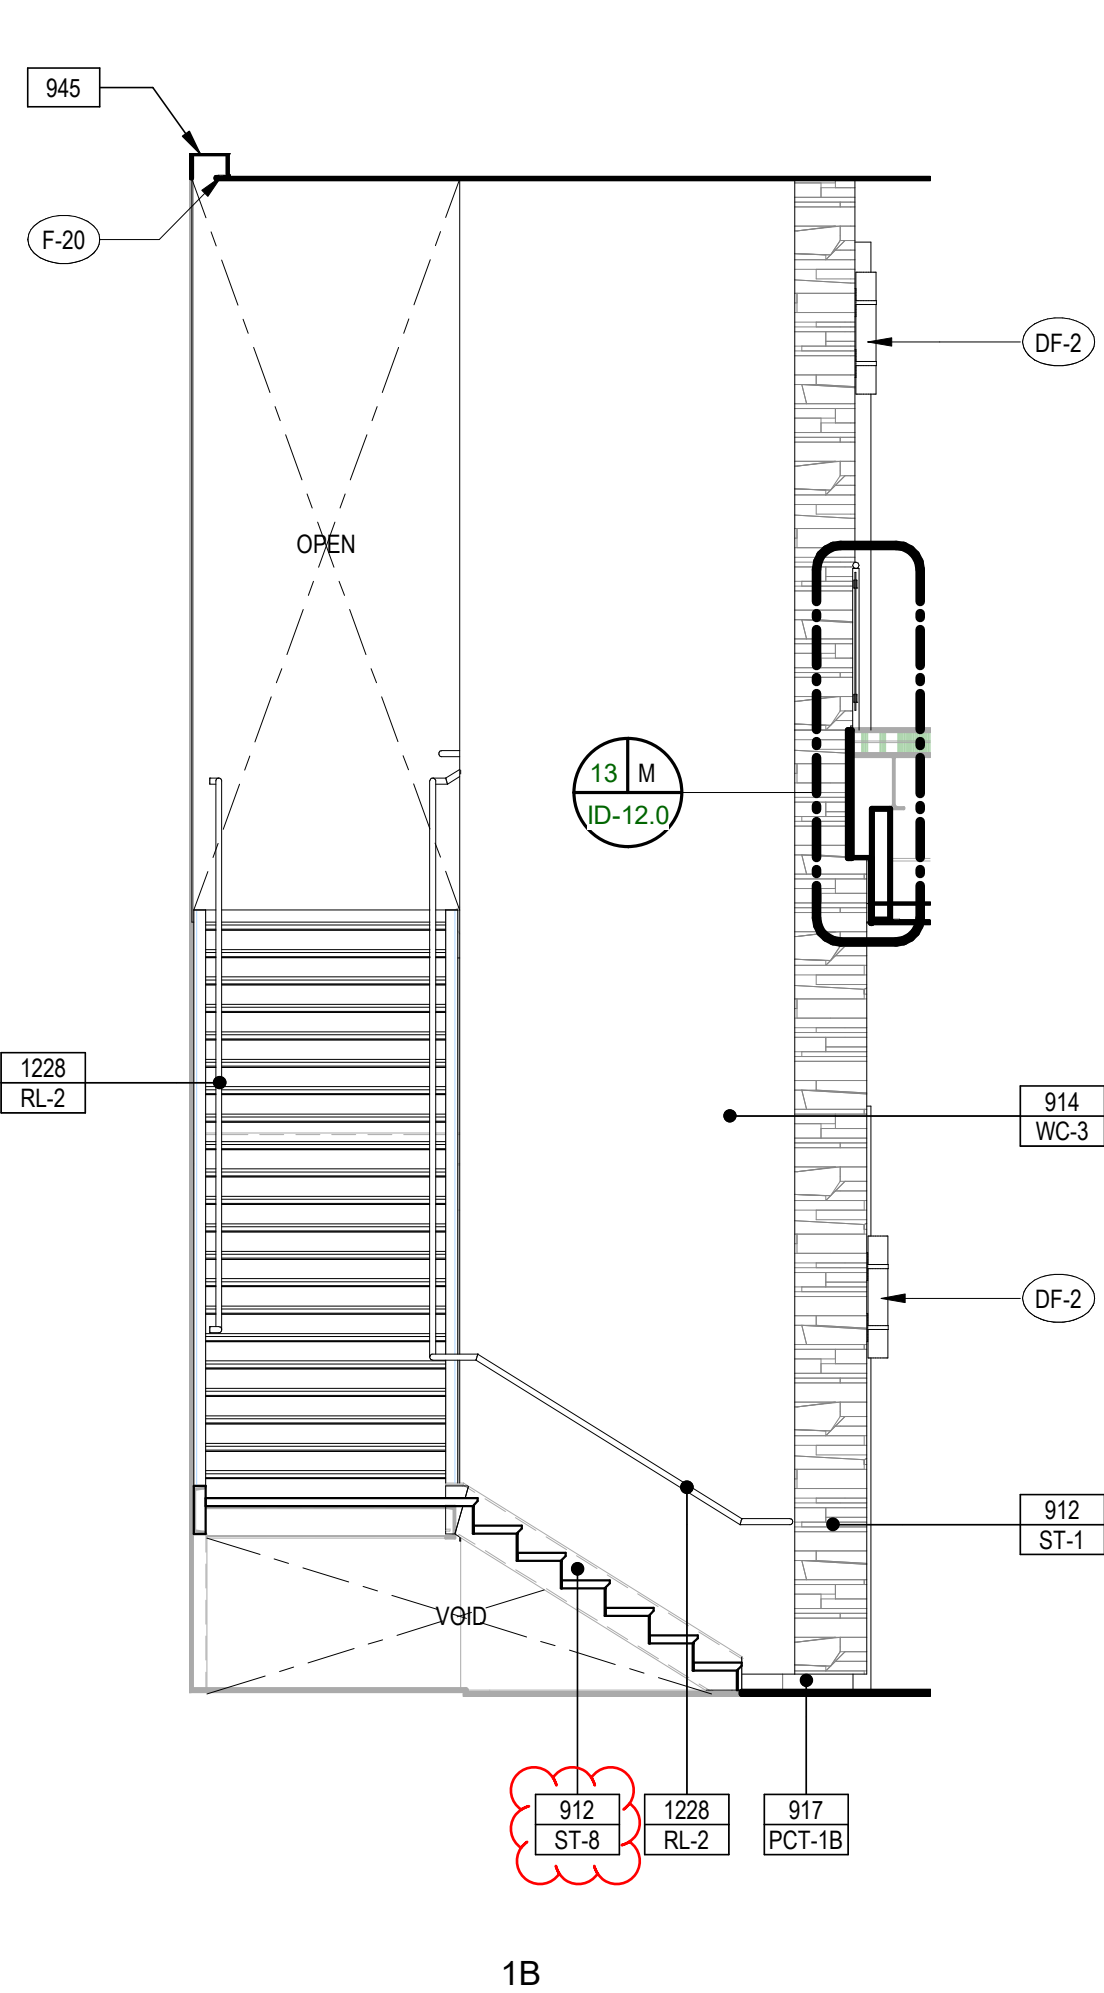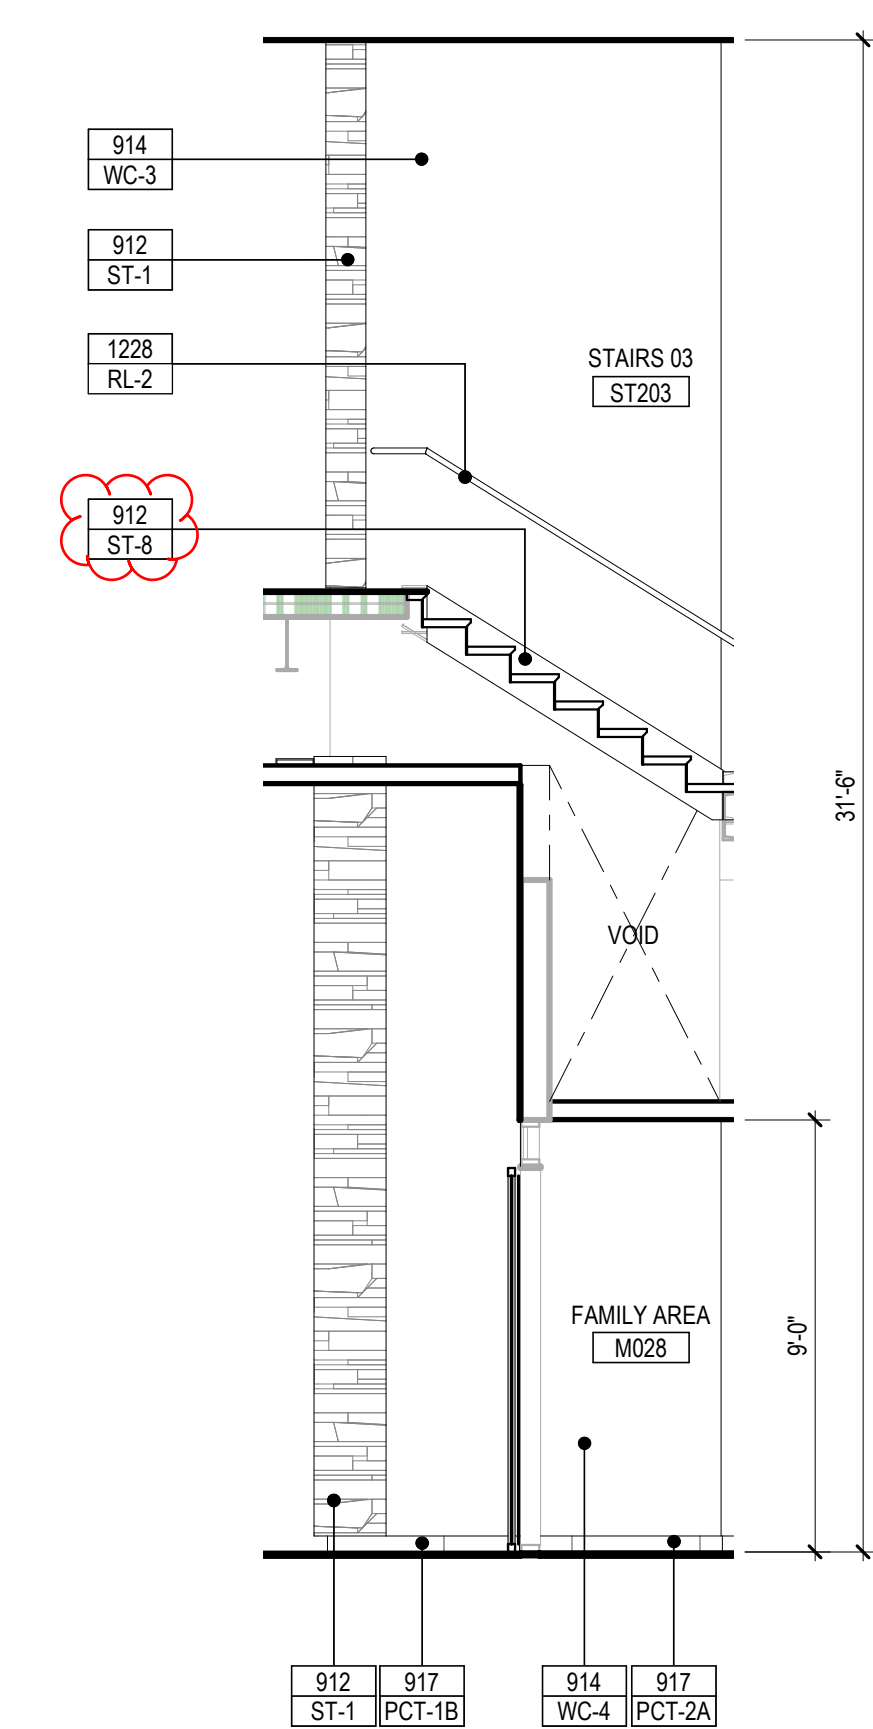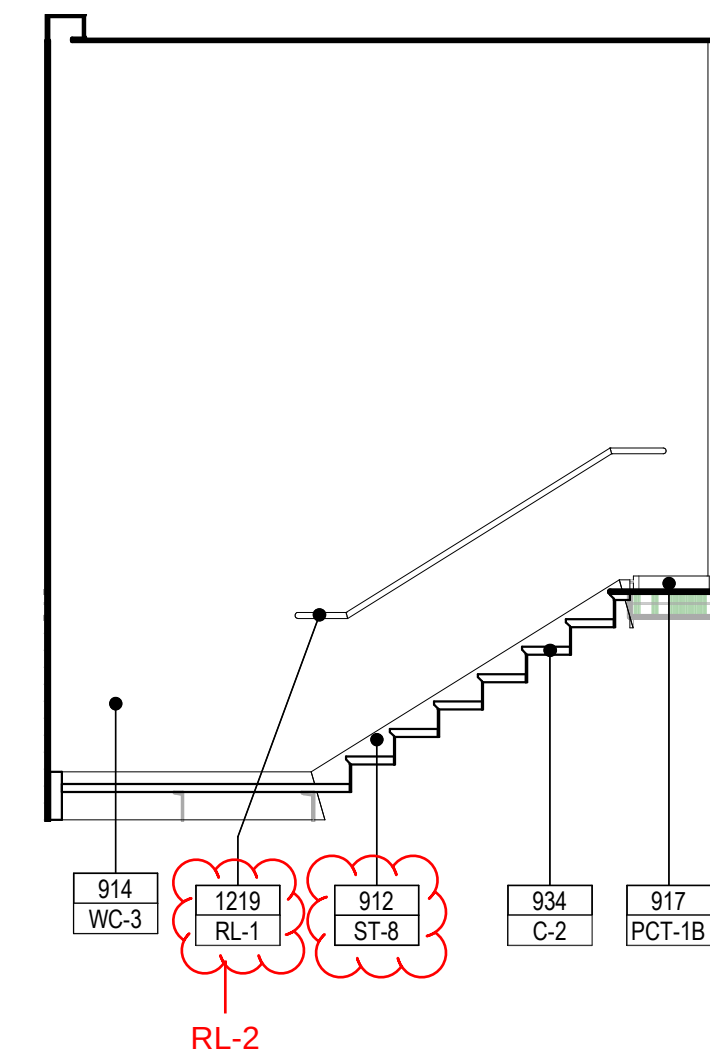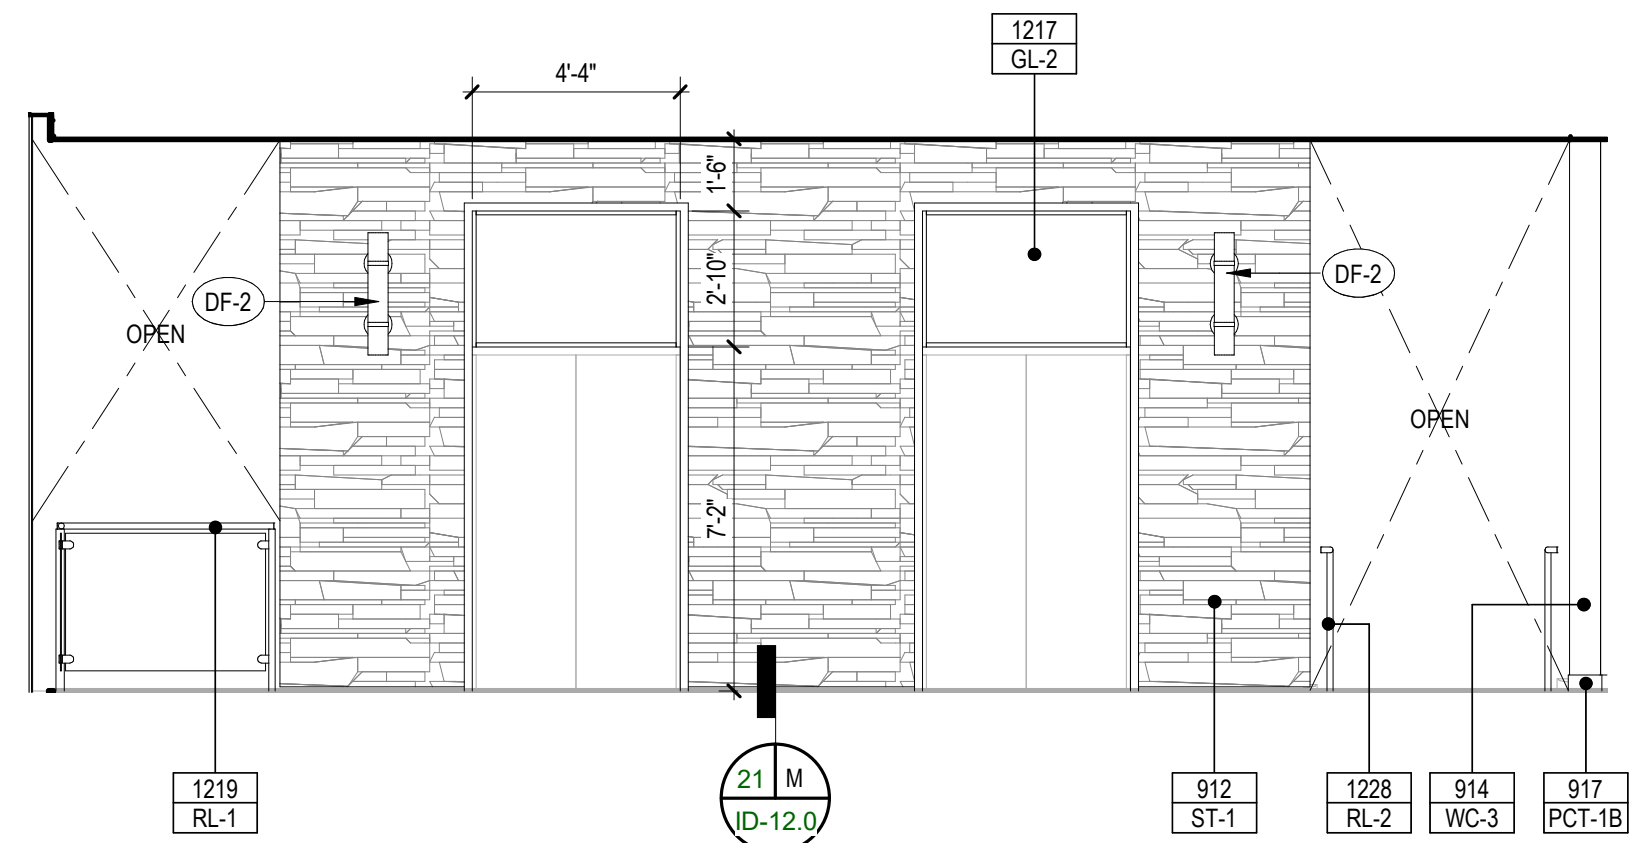

NOTE:
REFER TO SHEET ID-T7 FOR TYPICAL ELEVATOR
REQUIREMENTS.

STAIR ST013 - INTERIOR ELEVATIONS

Scale:
1/4"


1

KEYNOTES

- 830 DOOR PER PLAN AND DOOR SCHEDULE
831 INTERIOR ACCESS DOOR AND DOOR PER PLAN AND DOOR SCHEDULE
912 STONE
913 PAINT
914 WALLCOVERING
917 4" TILE WALL BASE
934 CARPET
945 CEILING LIGHT COVE. PAINT TO MATCH ADJ. SURFACE OR OTHERWISE INDICATED
1217 DECORATIVE GLASS PANEL
1219 42" HIGH GLASS RAILING SYSTEM
1228 1 1/2" DIA. HANDRAIL WITH BRACKETS

ELEVATION SYMBOL LEGEND


- ### KEYNOTE REFERENCE
KEYNOTE REFERENCE
XX-# COLOR & FINISH REFERENCE
FIXTURE AND FURNISHING REFERENCE

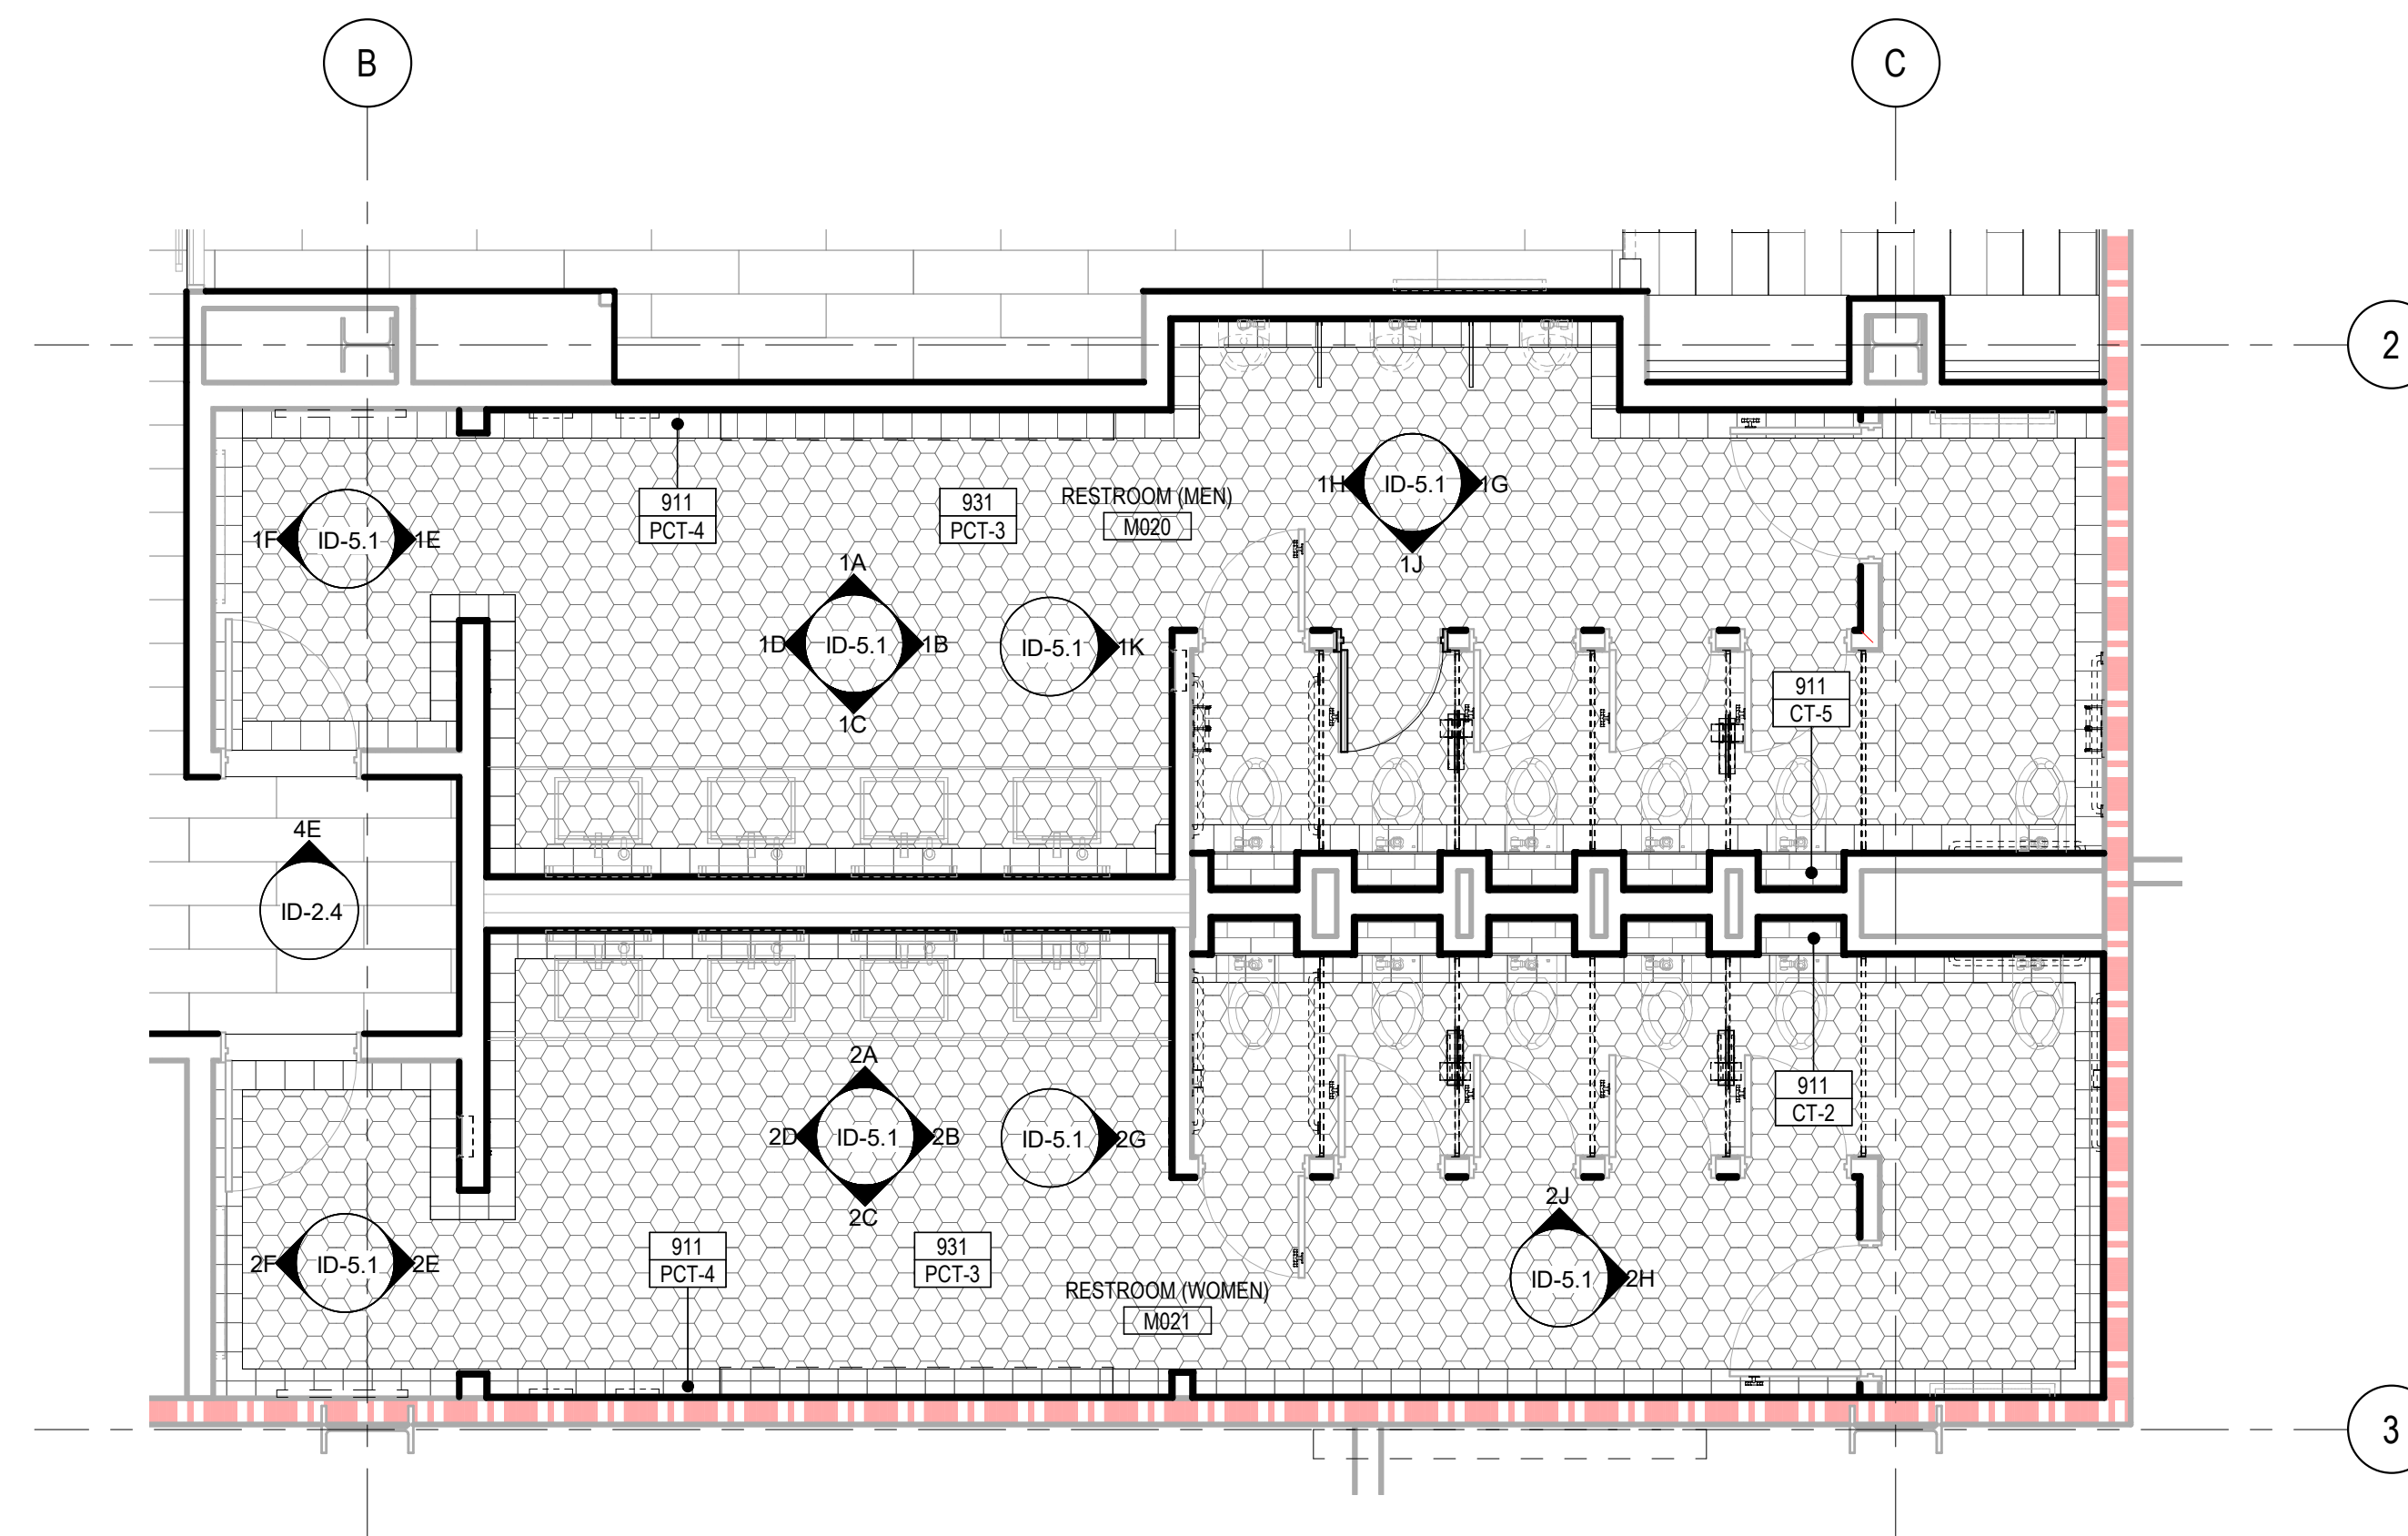

ENLARGED RESTROOM FINISH PLAN - LEVEL 1

Scale:
1/4" = 1'-0"


2

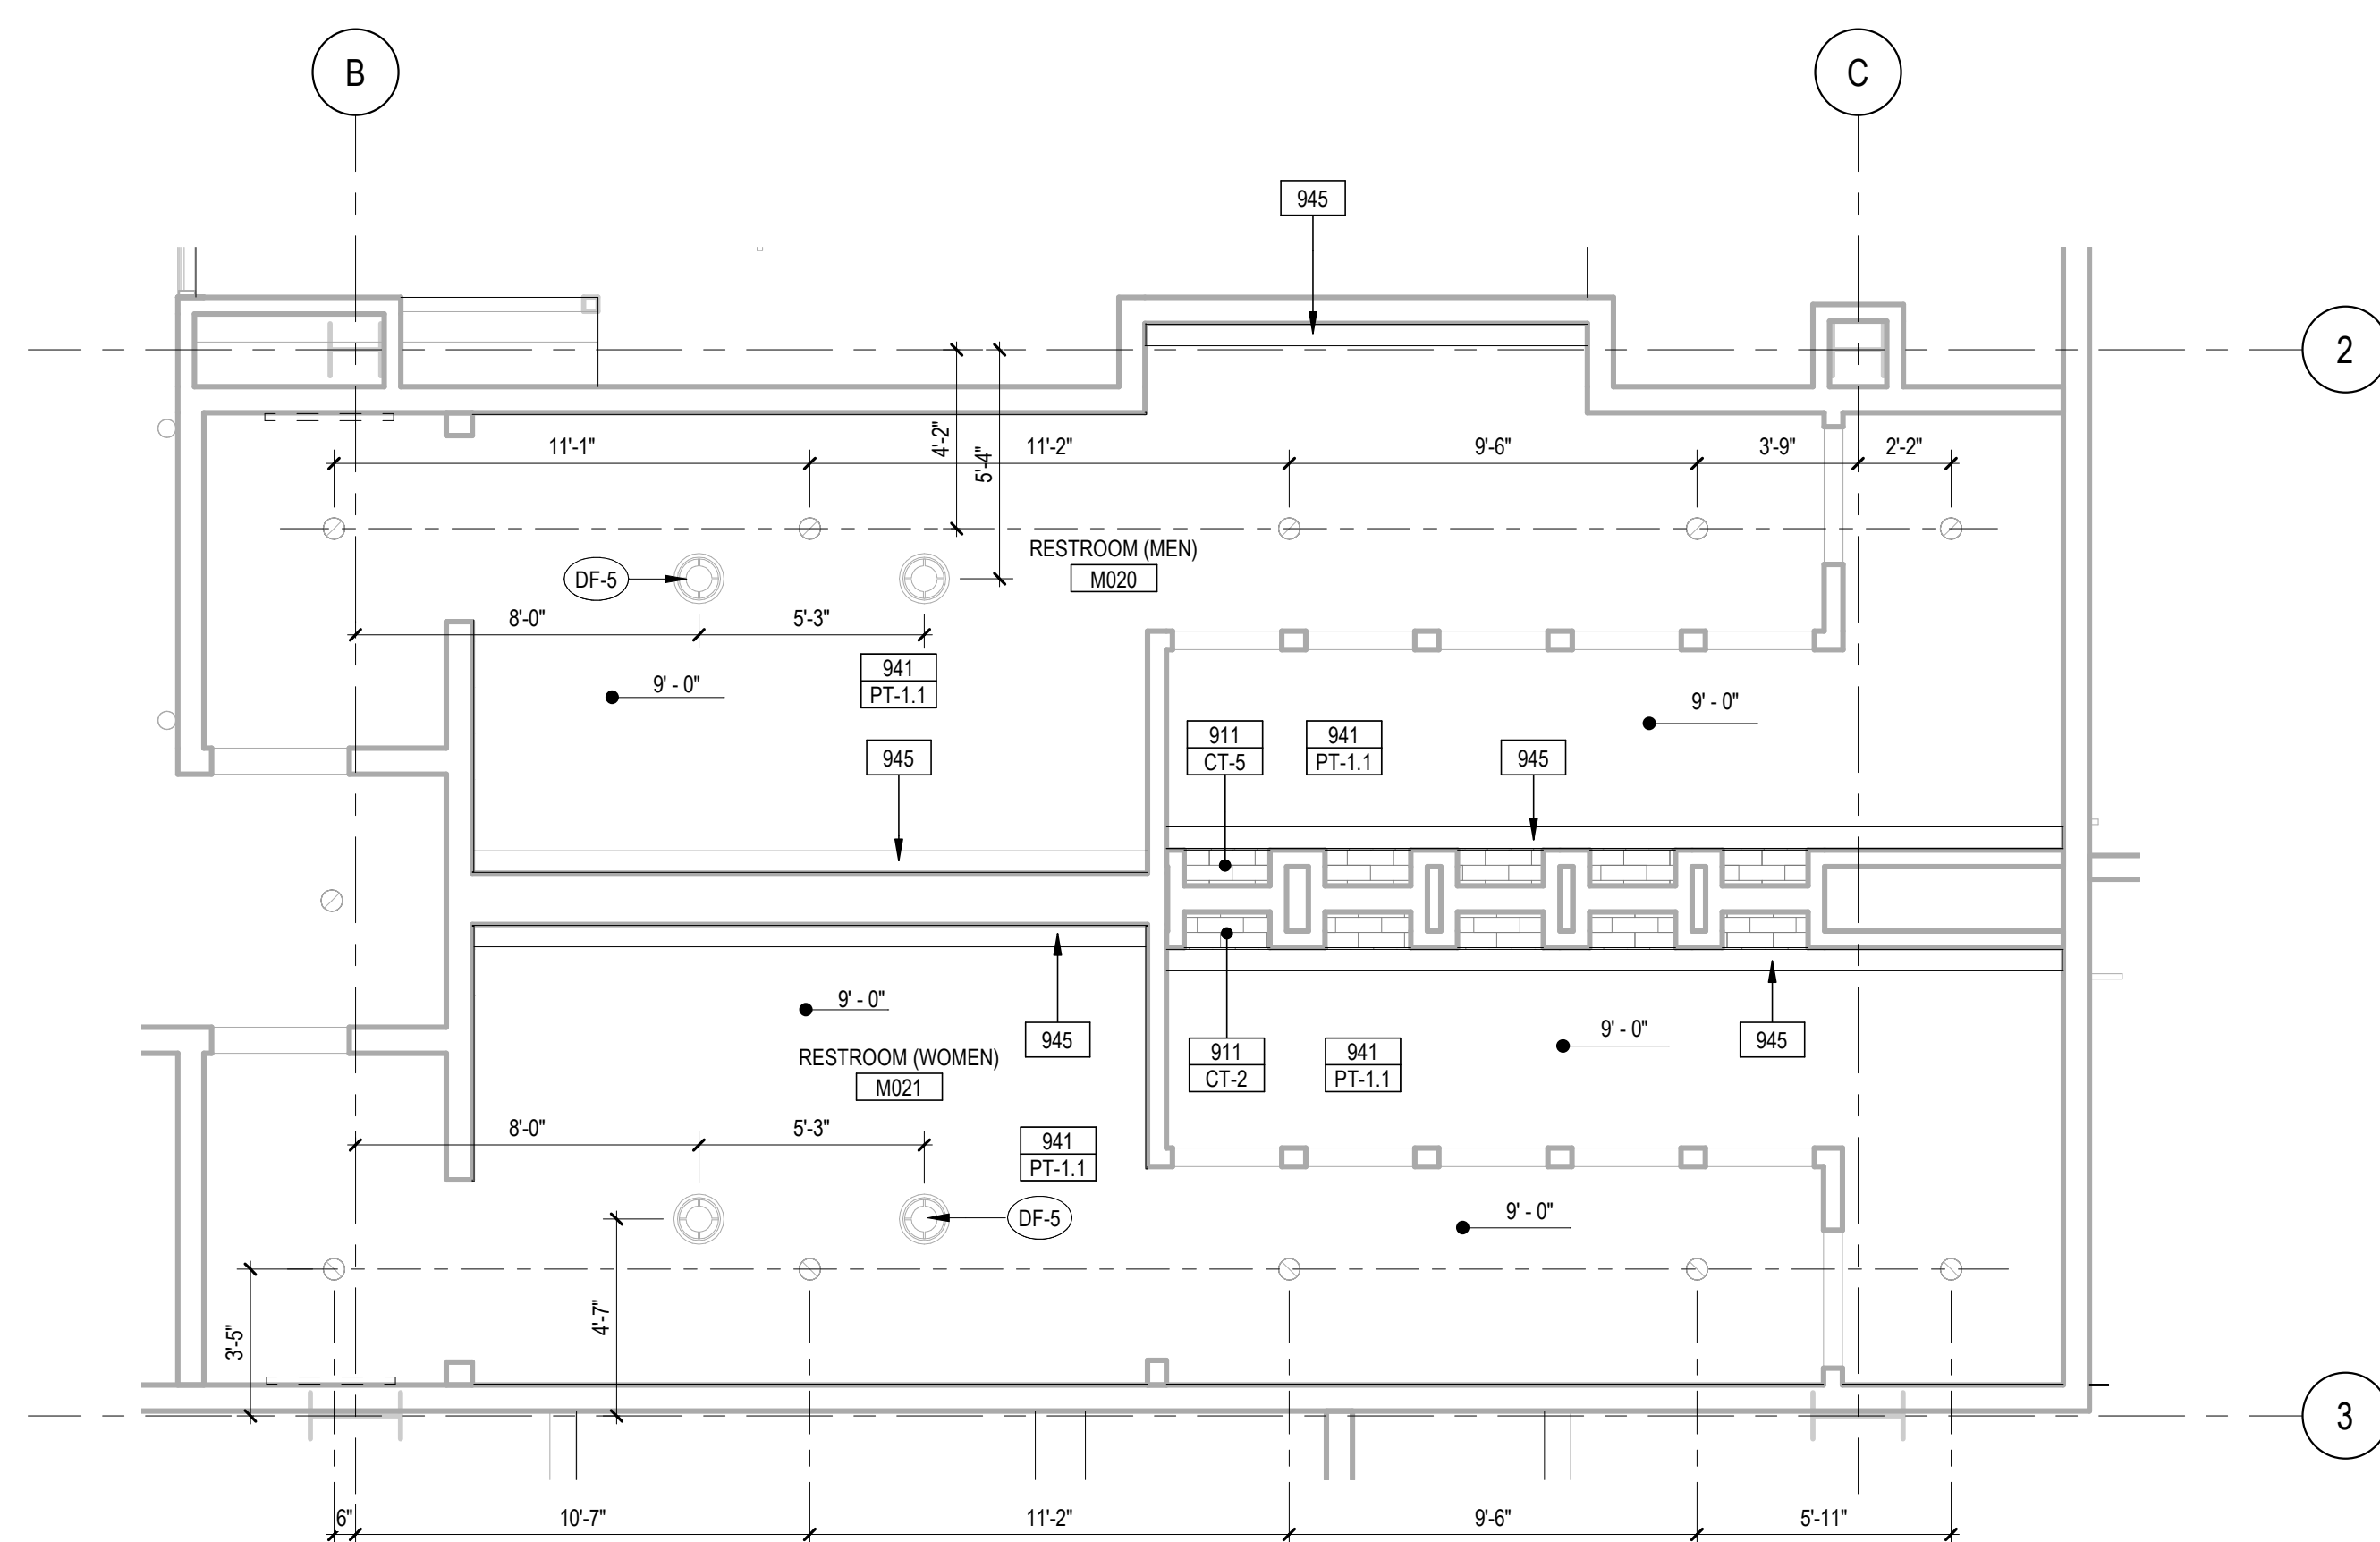

ENLARGED RESTROOM RCP - LEVEL 1

Scale:
1/4" = 1'-0"

3

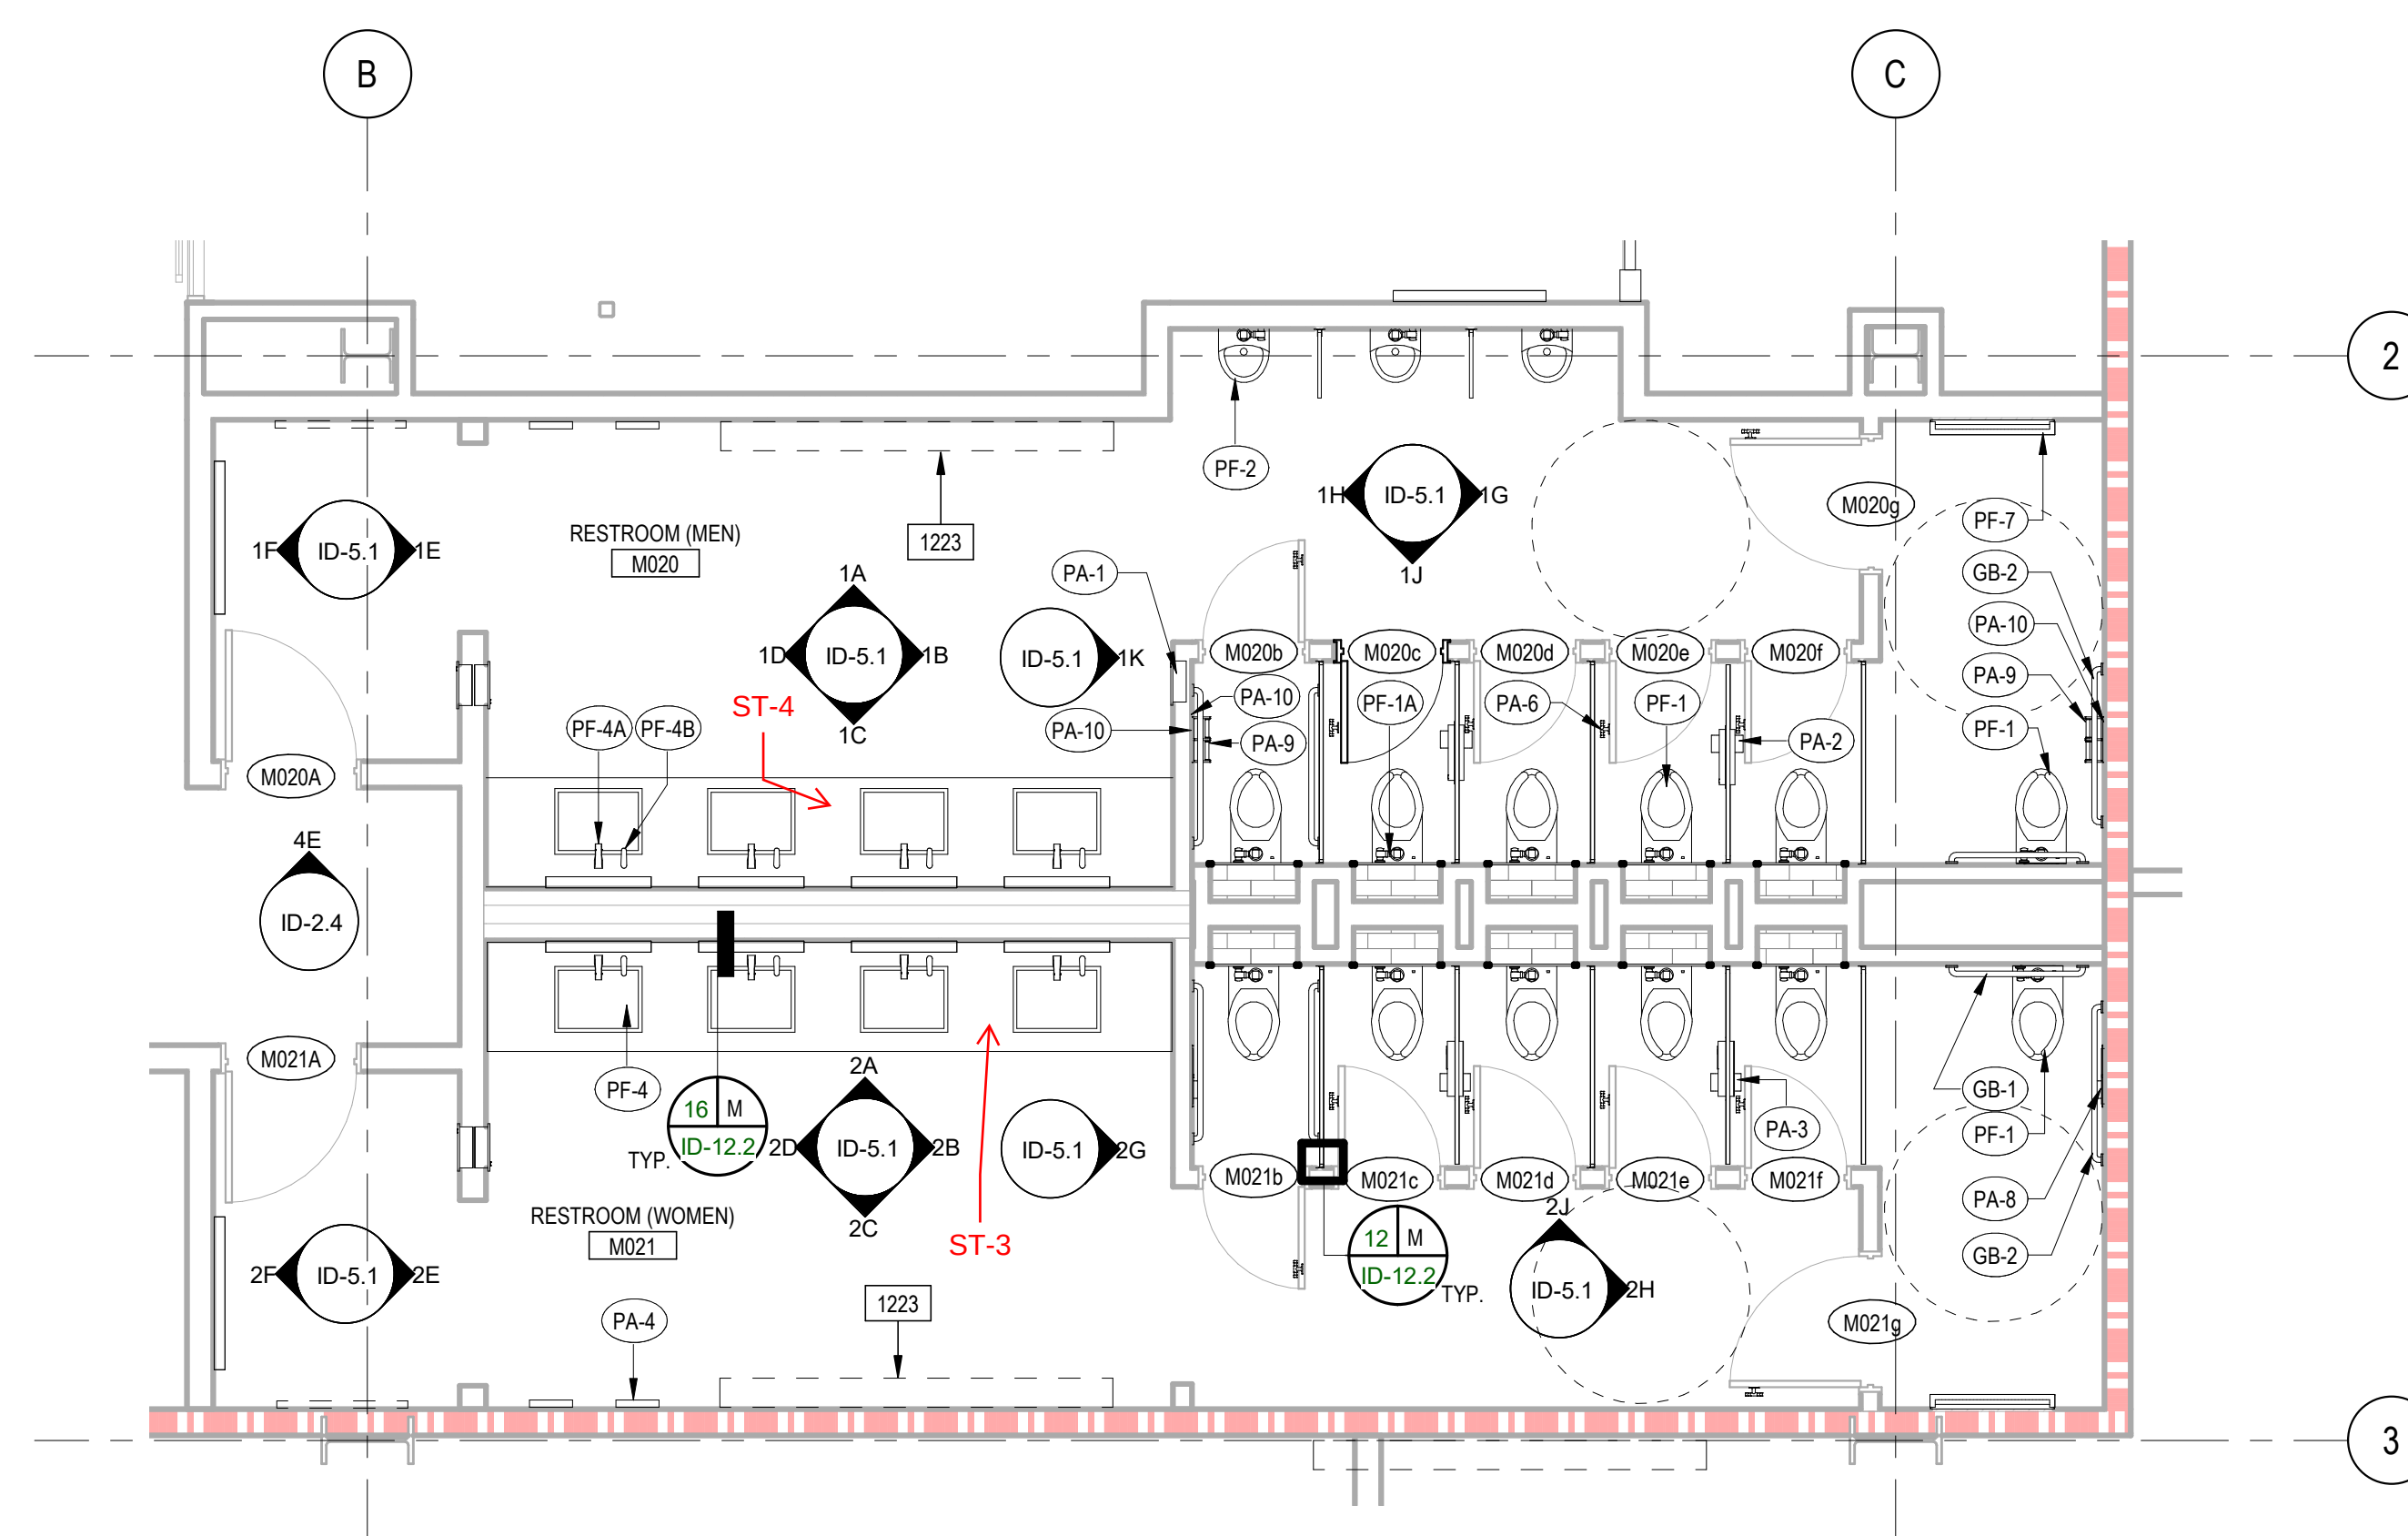

ENLARGED RESTROOM FURNISHING PLAN - LEVEL 1

Scale:
1/4" = 1'-0"

1

KEYNOTES

- 911 PORCELAIN TILE
931 FLOOR TILE
941 PAINTED CEILING
945 CEILING LIGHT COVE. PAINT TO MATCH ADJ. SURFACE OR OTHERWISE INDICATED
1223 AMENITY CABINET

RCP SYMBOL LEGEND



- 1 ELECTRICAL J-BOX, SEE ELECTRICAL PLANS
COVE LIGHTING
WALL MOUNTED SCONCE LIGHT FIXTURE
WALL MOUNTED SCONCE LIGHT FIXTURE
RECESSED LIGHT FIXTURE
1 KEYNOTE
A COLOR AND FINISH

FINISH PLAN SYMBOL LEGEND

- NON-RATED WALLS (SHELL SCOPE)
1 HR FIRE RATED WALLS (SHELL SCOPE)
2 HR FIRE RATED WALLS (SHELL SCOPE)
FINISH START SYMBOL
KEYNOTE REFERENCE
KEYNOTE REFERENCE
COLOR & FINISH REFERENCE

FIXTURE & FURNISHING SYMBOL LEGEND

- FIXTURE AND FURNISHING REFERENCE

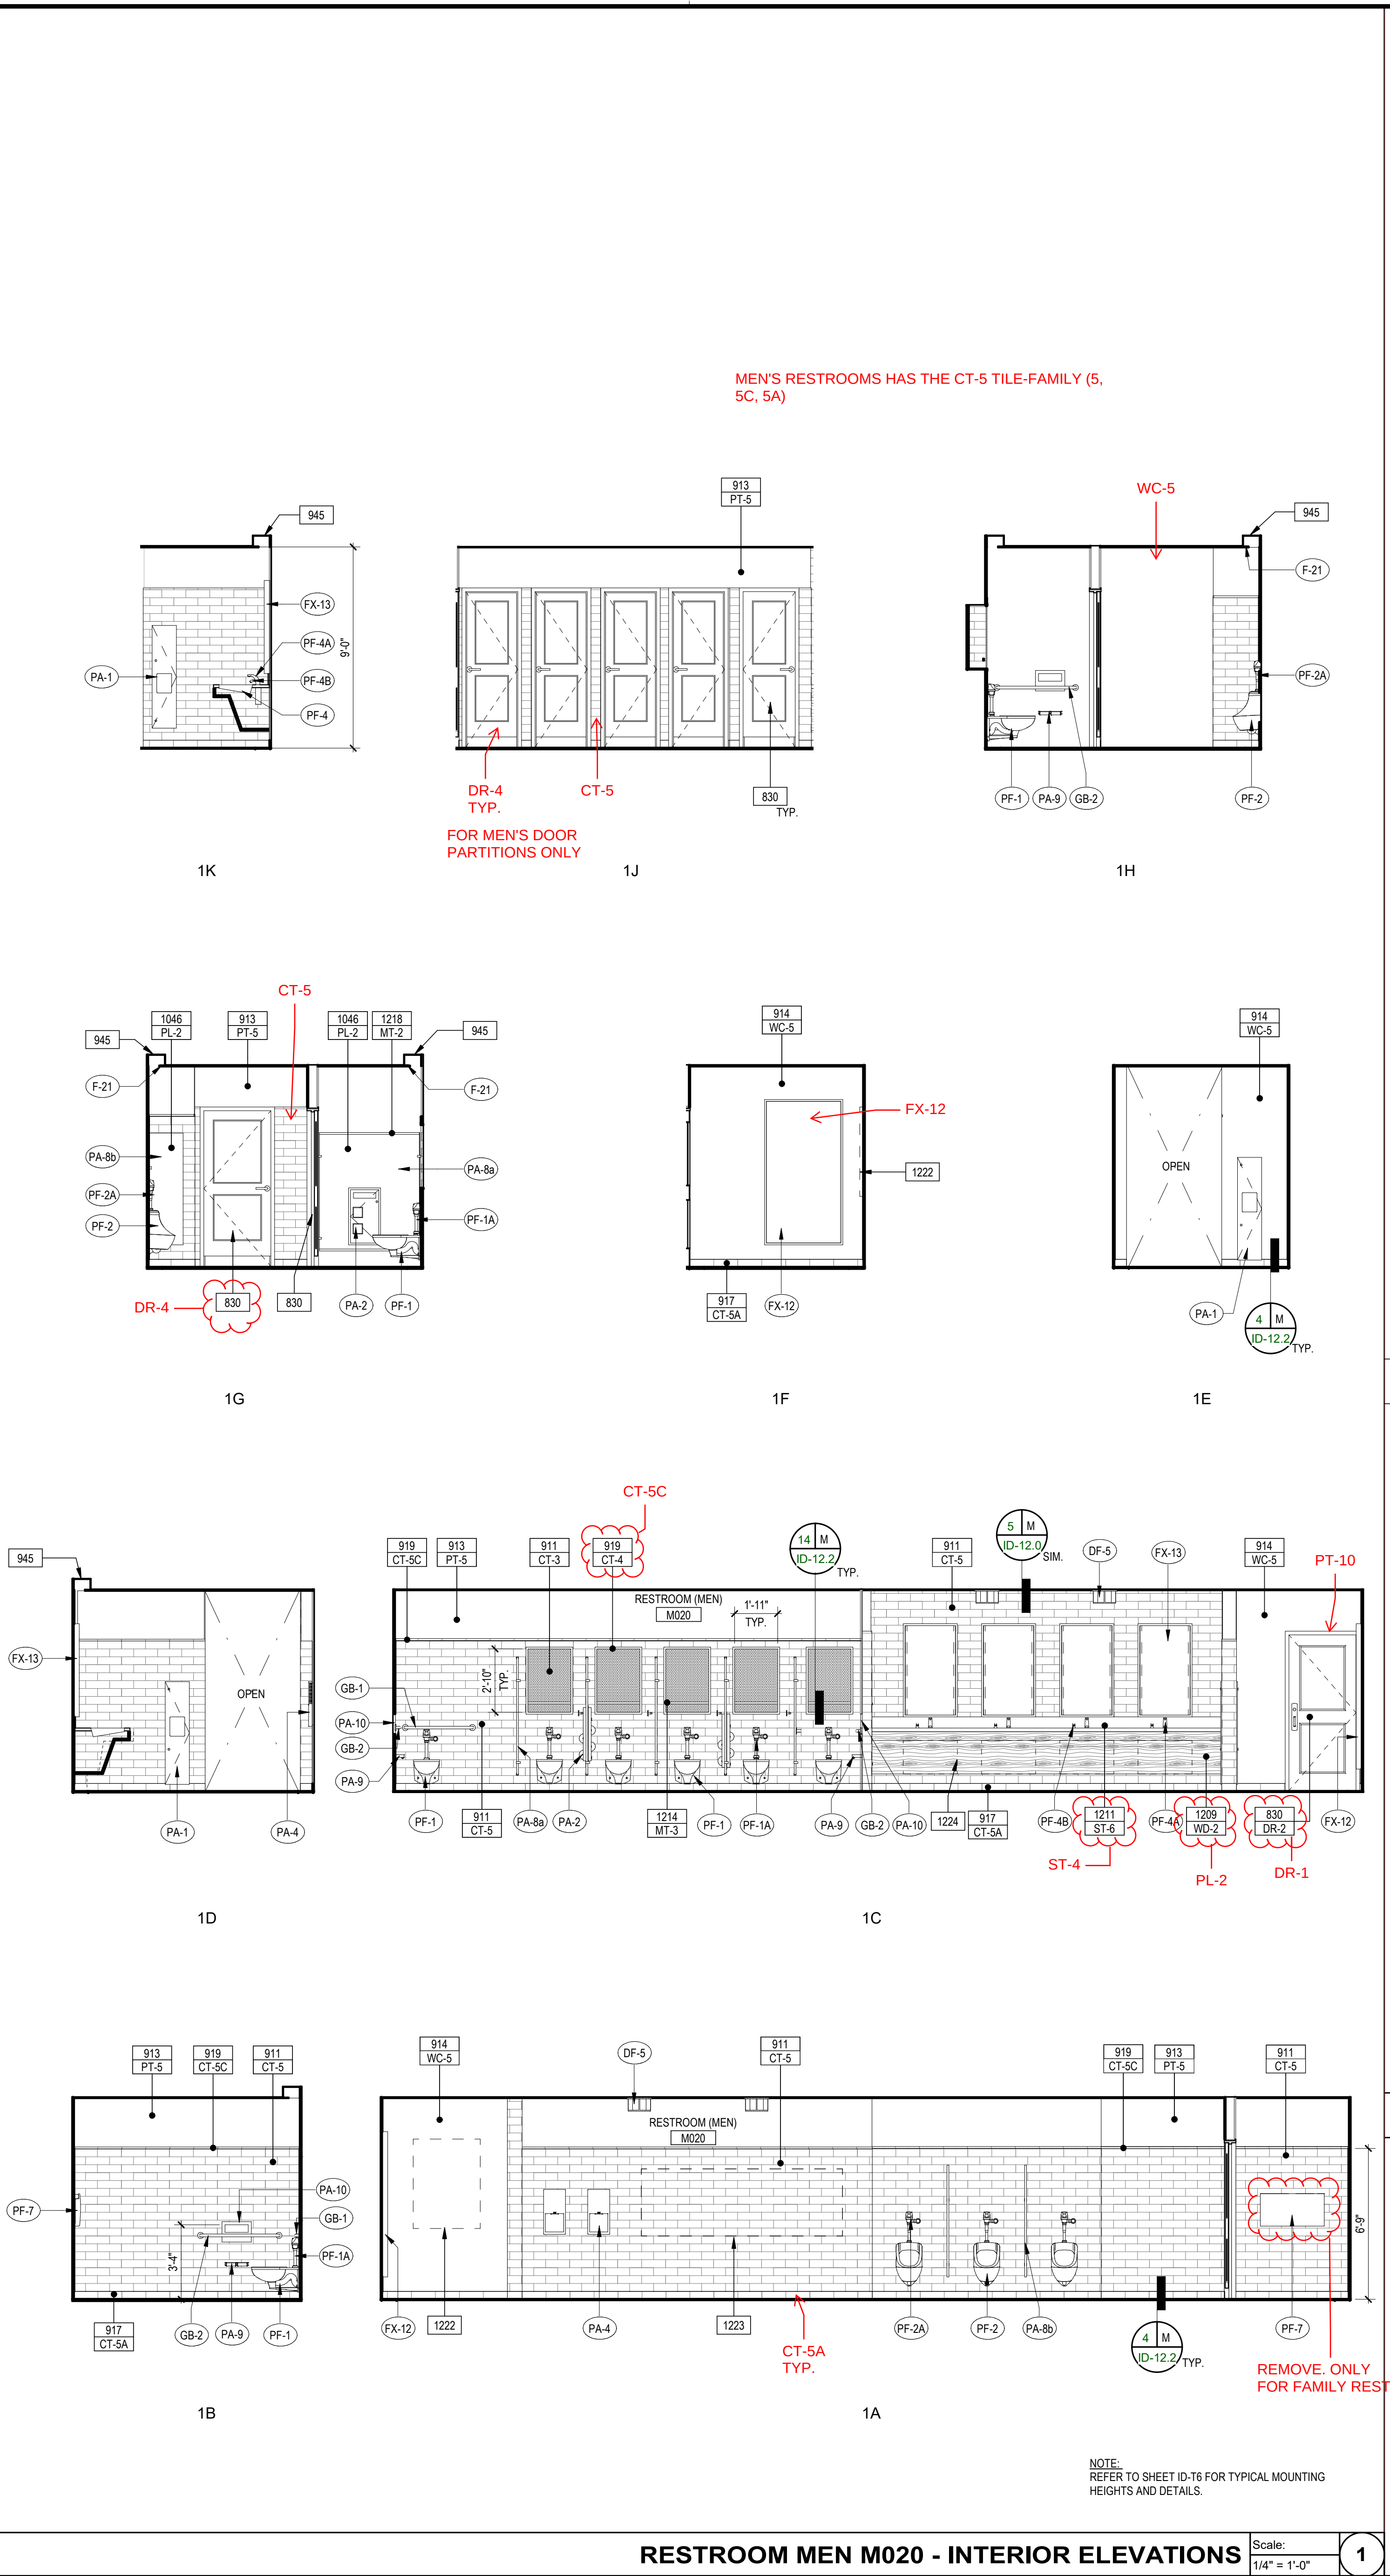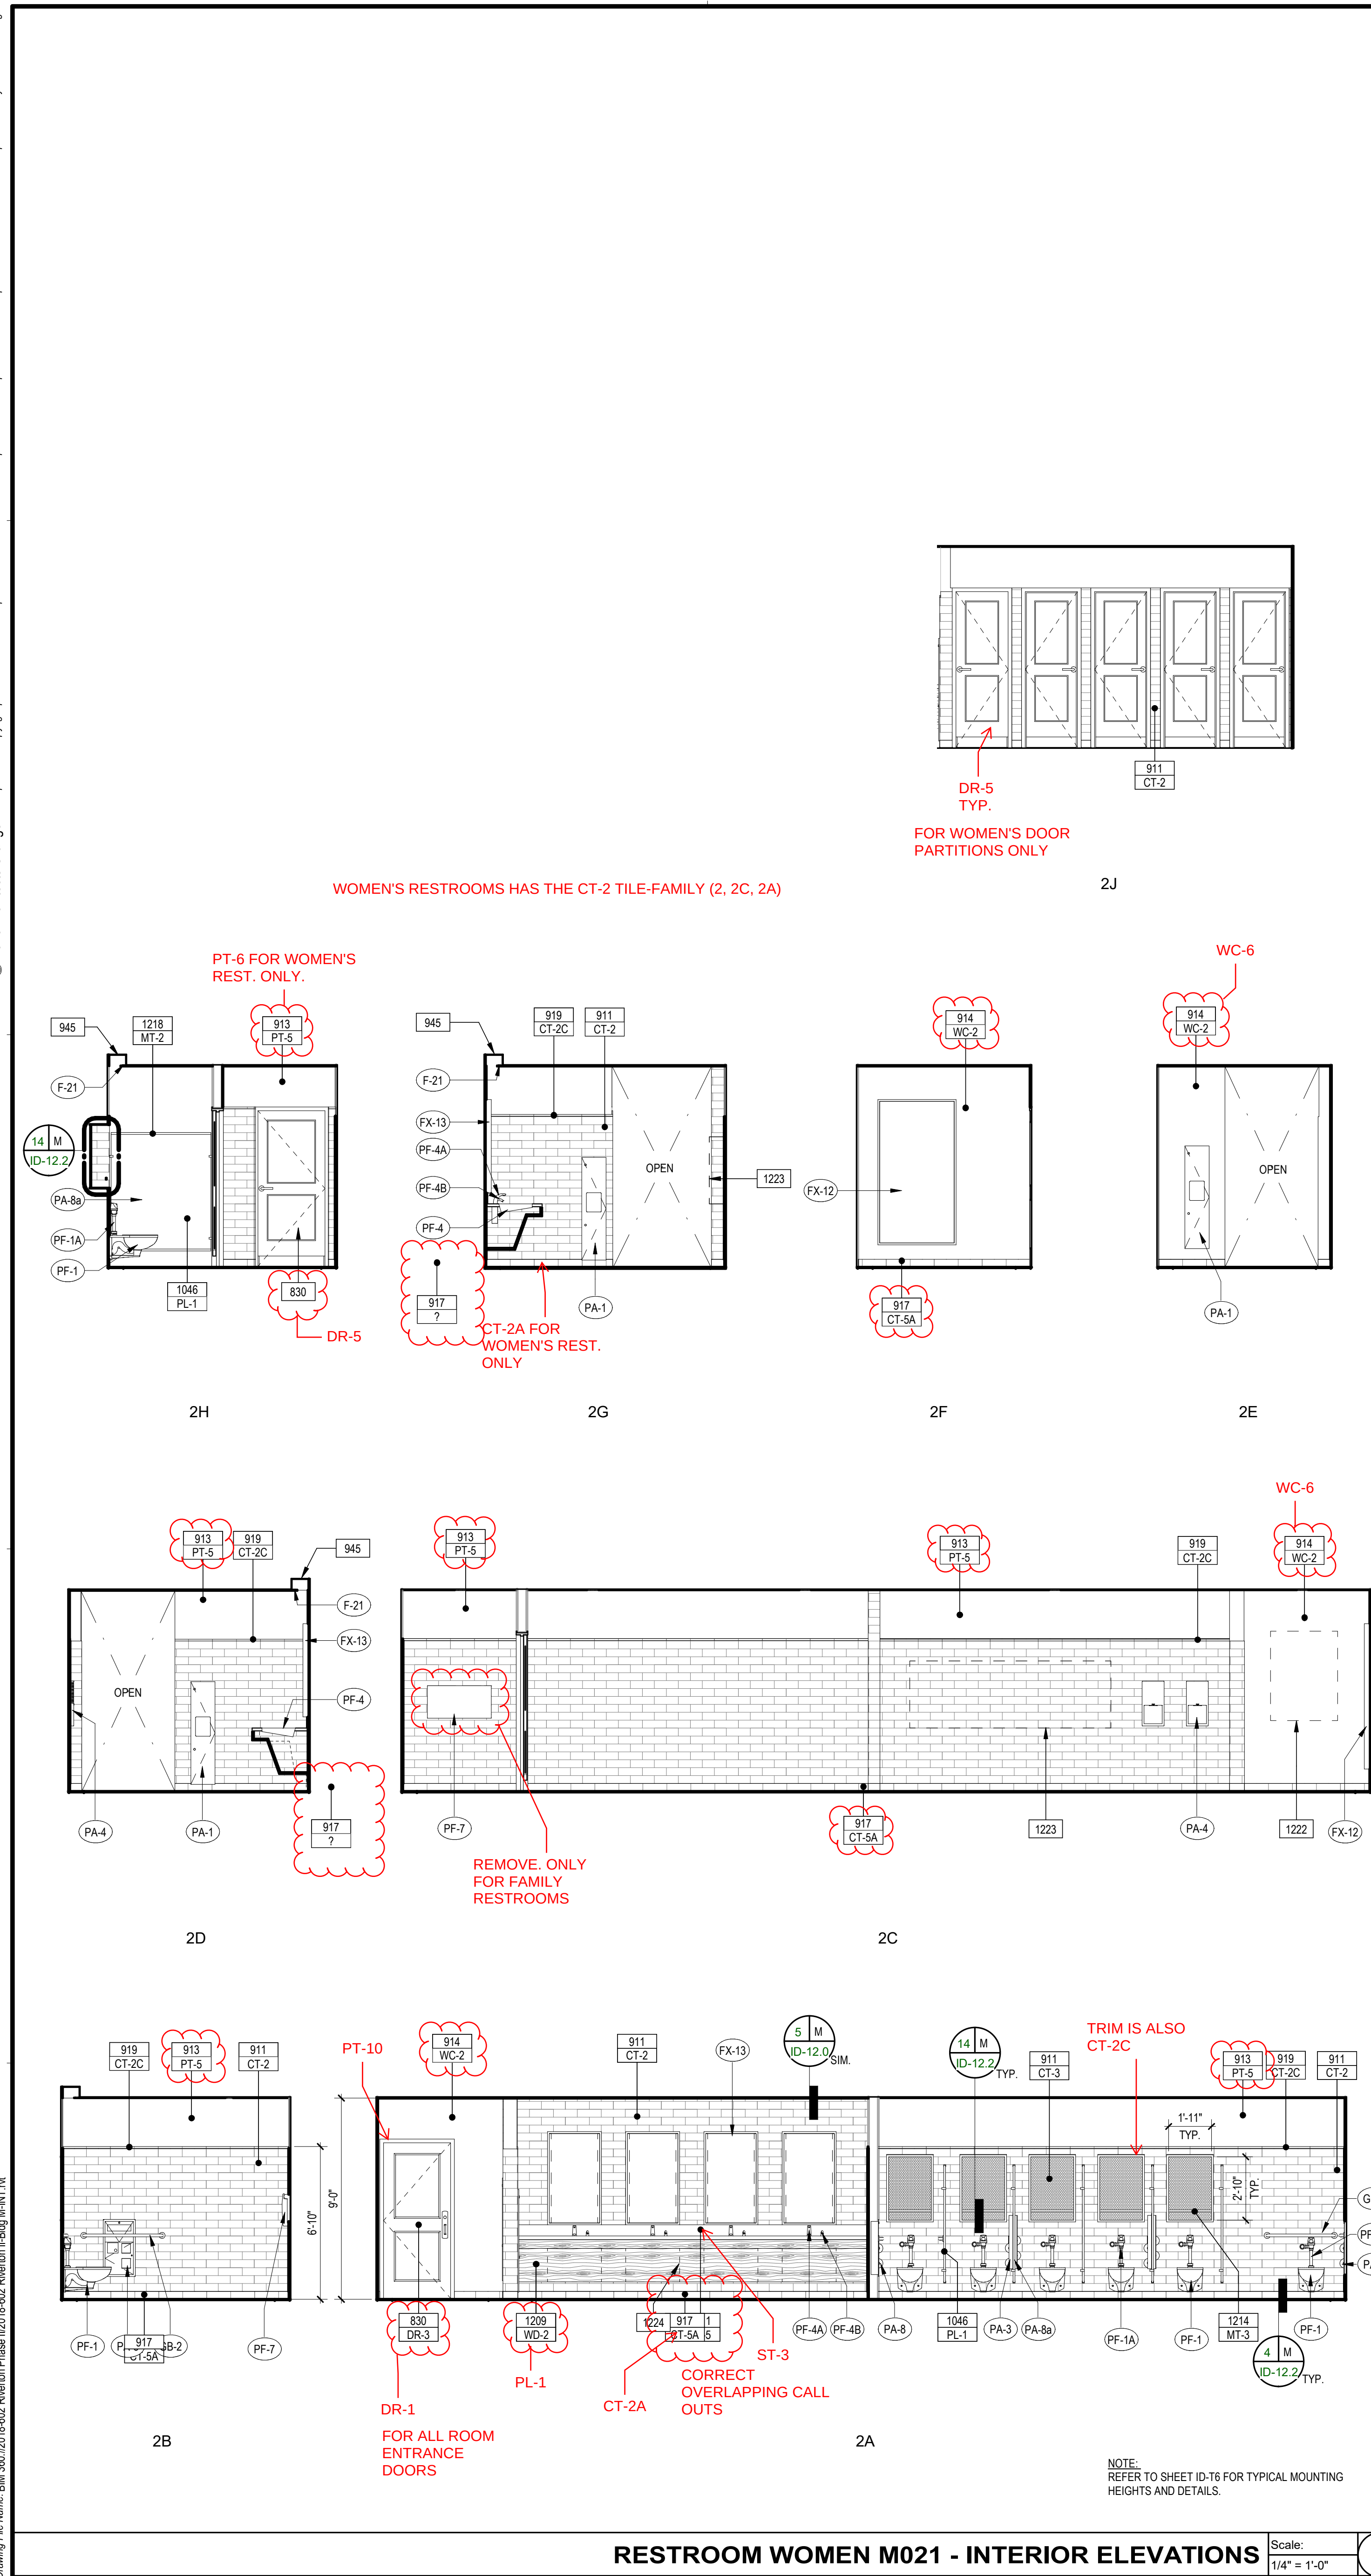

###	KEYNOTES
830	DOOR PER PLAN AND DOOR SCHEDULE
911	PORCELAIN TILE
913	PAINT
914	WALLCOVERING
917	4" TILE WALL BASE
919	TILE TRIM
945	CEILING LIGHT COVE. PAINT TO MATCH ADJ. SURFACE OR OTHERWISE INDICATED
1046	TOILET PARTITION
1209	WOOD TRIM
1211	STONE COUNTERTOP WITH 6" HIGH BACKSPLASH
1214	METAL RAIL
1218	METAL FRAME
1222	WALL ART LOCATION
1223	AMENITY CABINET
1224	REMOVEABLE ACCESS PANEL

###	ELEVATION SYMBOL LEGEND
###	KEYNOTE REFERENCE
###	KEYNOTE REFERENCE
XX-#	COLOR & FINISH REFERENCE
###	FIXTURE AND FURNISHING REFERENCE

AO
Architecture.
Design.
Relationships.

SEAL
STATE OF UTAH
RICHARD PETER JR.
No. 260337-0301
LICENSED ARCHITECT
CONSULTANT

CENTERCAL
PROPERTIES, LLC
CenterCal Properties, LLC
1600 E. Franklin Ave. Ste A
El Segundo, CA 90245
(310) 563-6900

Layton
CONSTRUCTION WITH INTEGRITY
Layton Construction Co., Inc.
9090 So. Sandy Parkway
Sandus, UT 84070-6409
(801) 963-4462


MOUNTAIN VIEW VILLAGE
PHASE II BUILDING M -
INTERIOR PACKAGE
W 13400 S & Mountain View Corridor
Riverton, Utah 84065

MENS AND WOMENS
RESTROOM - ELEVATIONS


Project Number: 2016-602
Plan Check Number: Permit Number

31102020 12:50:18 PM
Sheet Printed: 31102020 12:50:18 PM
Drawing File Name: BM-360-2016-602 Riverton Phase II-Bldg M-INT.rvt


SHEET
M
ID-5.1

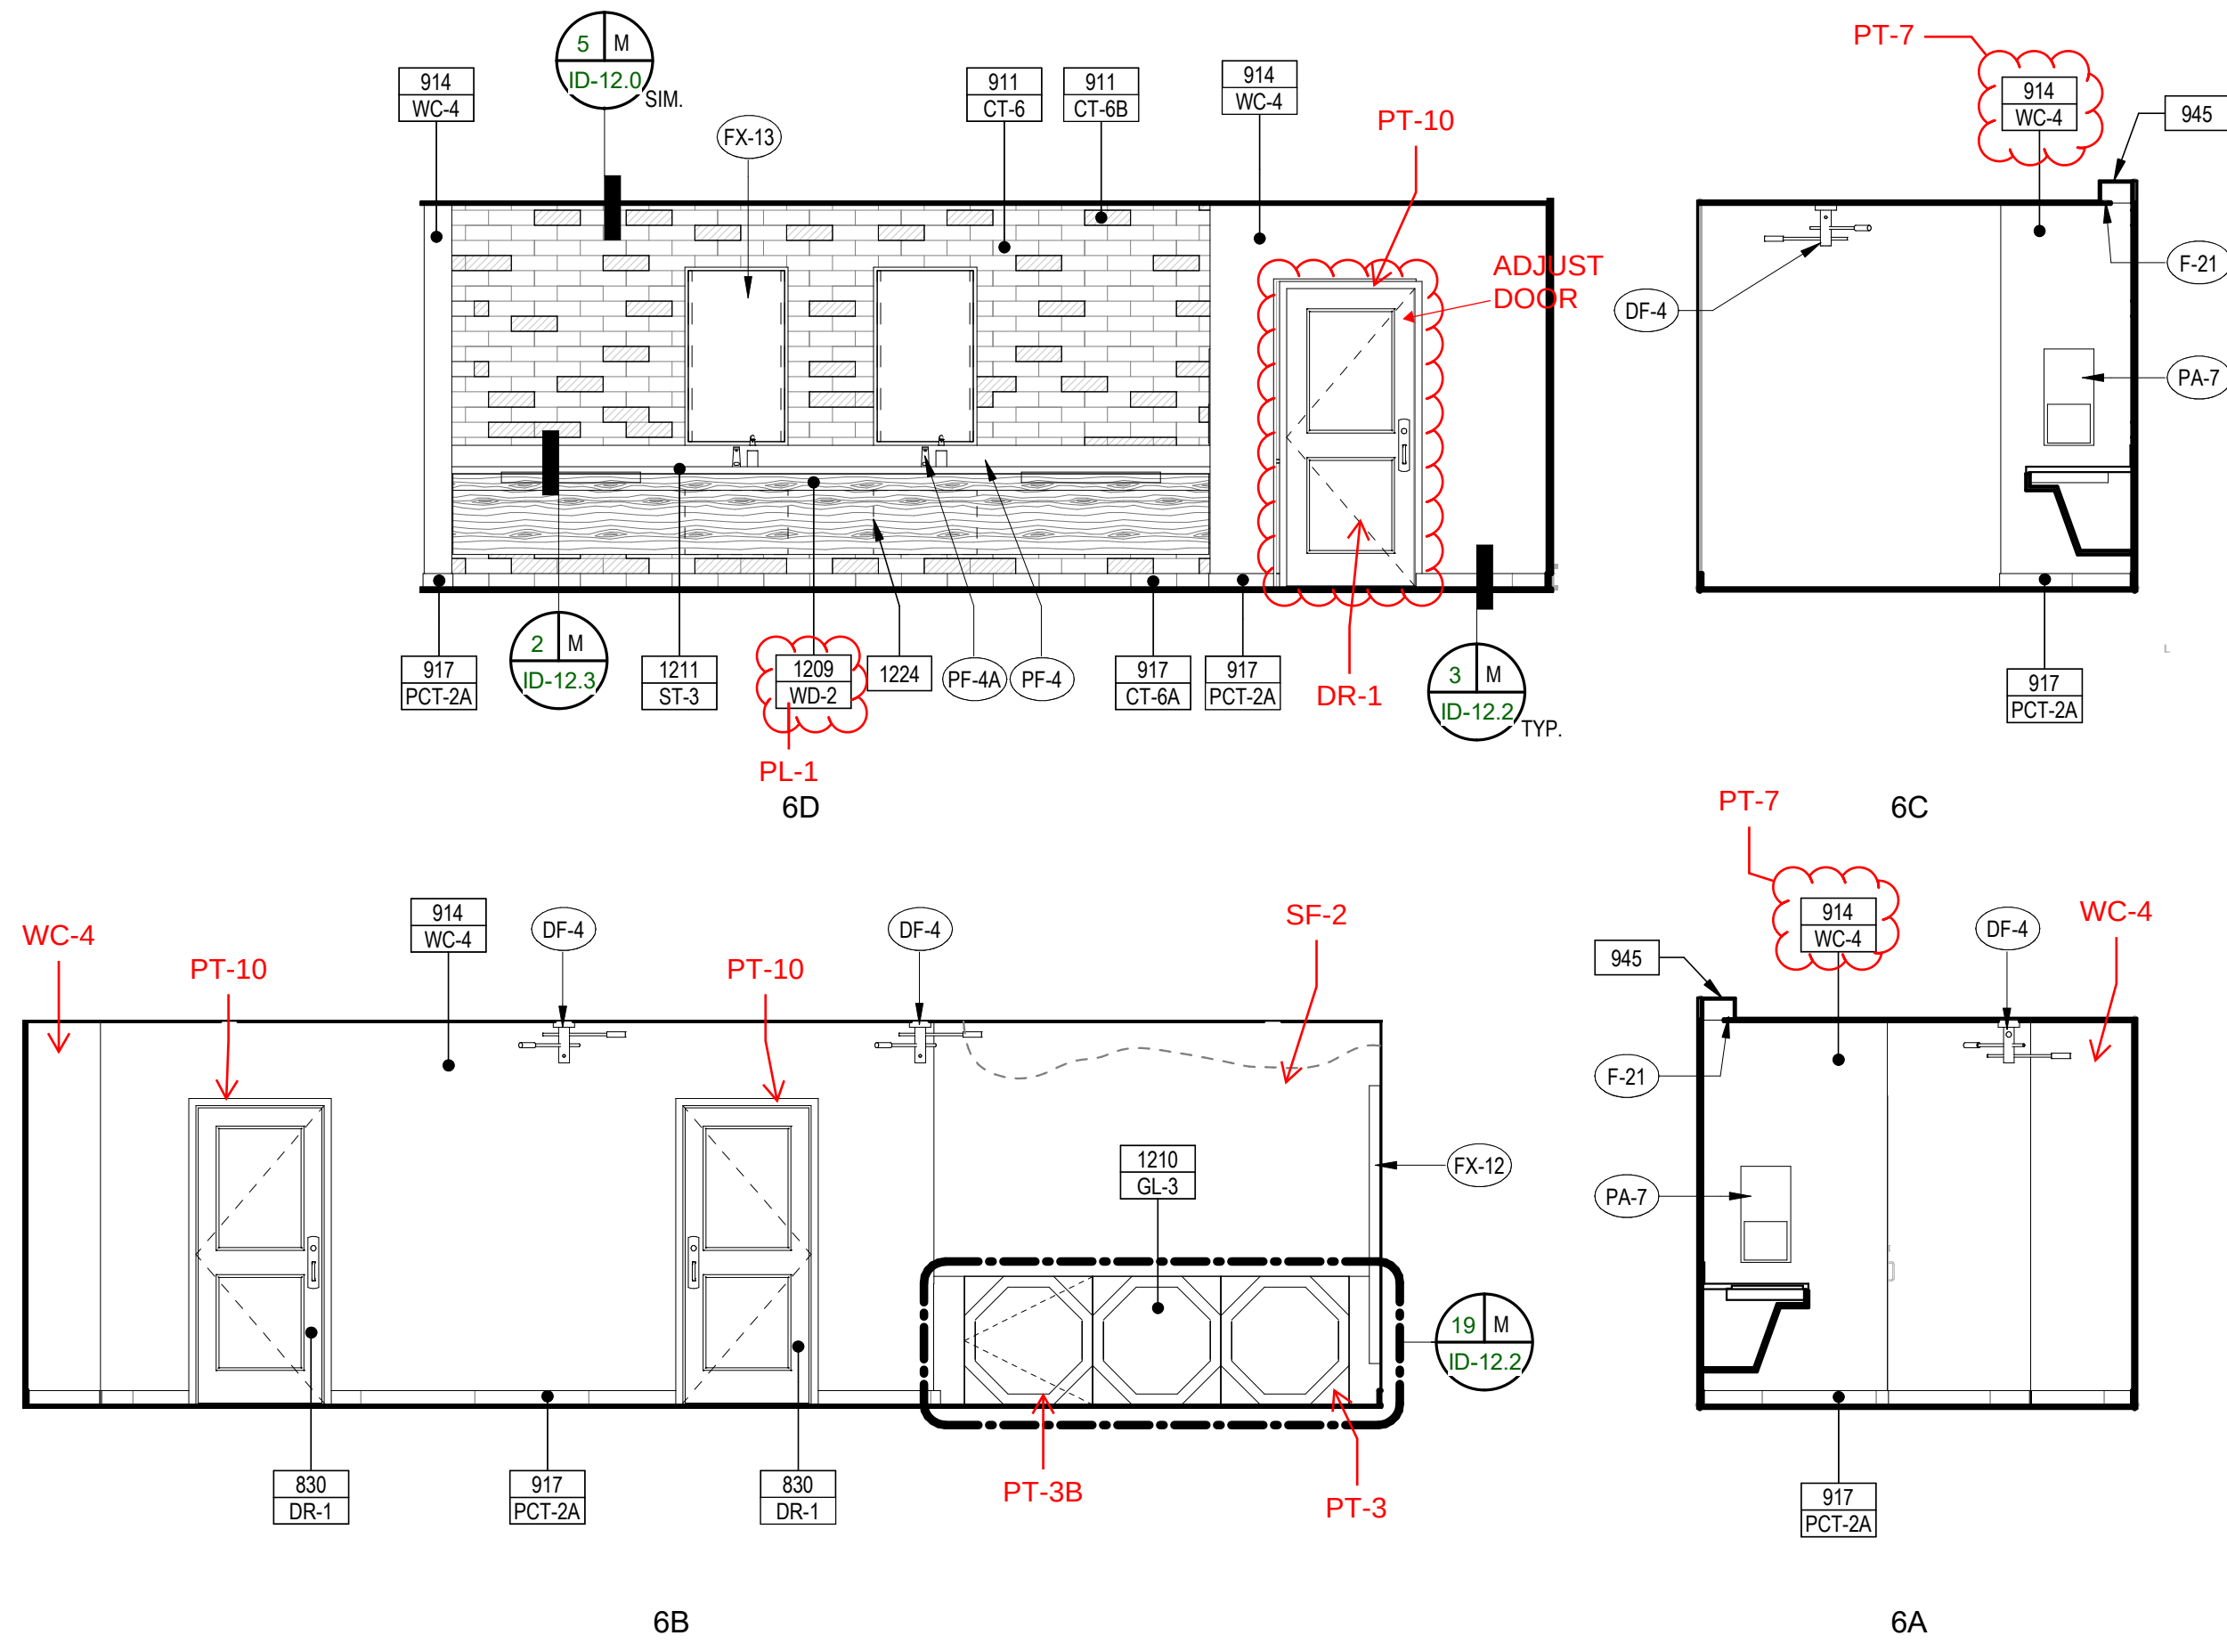


FAMILY AREA M028 - INTERIOR ELEVATIONS Scale: 1/4" 6

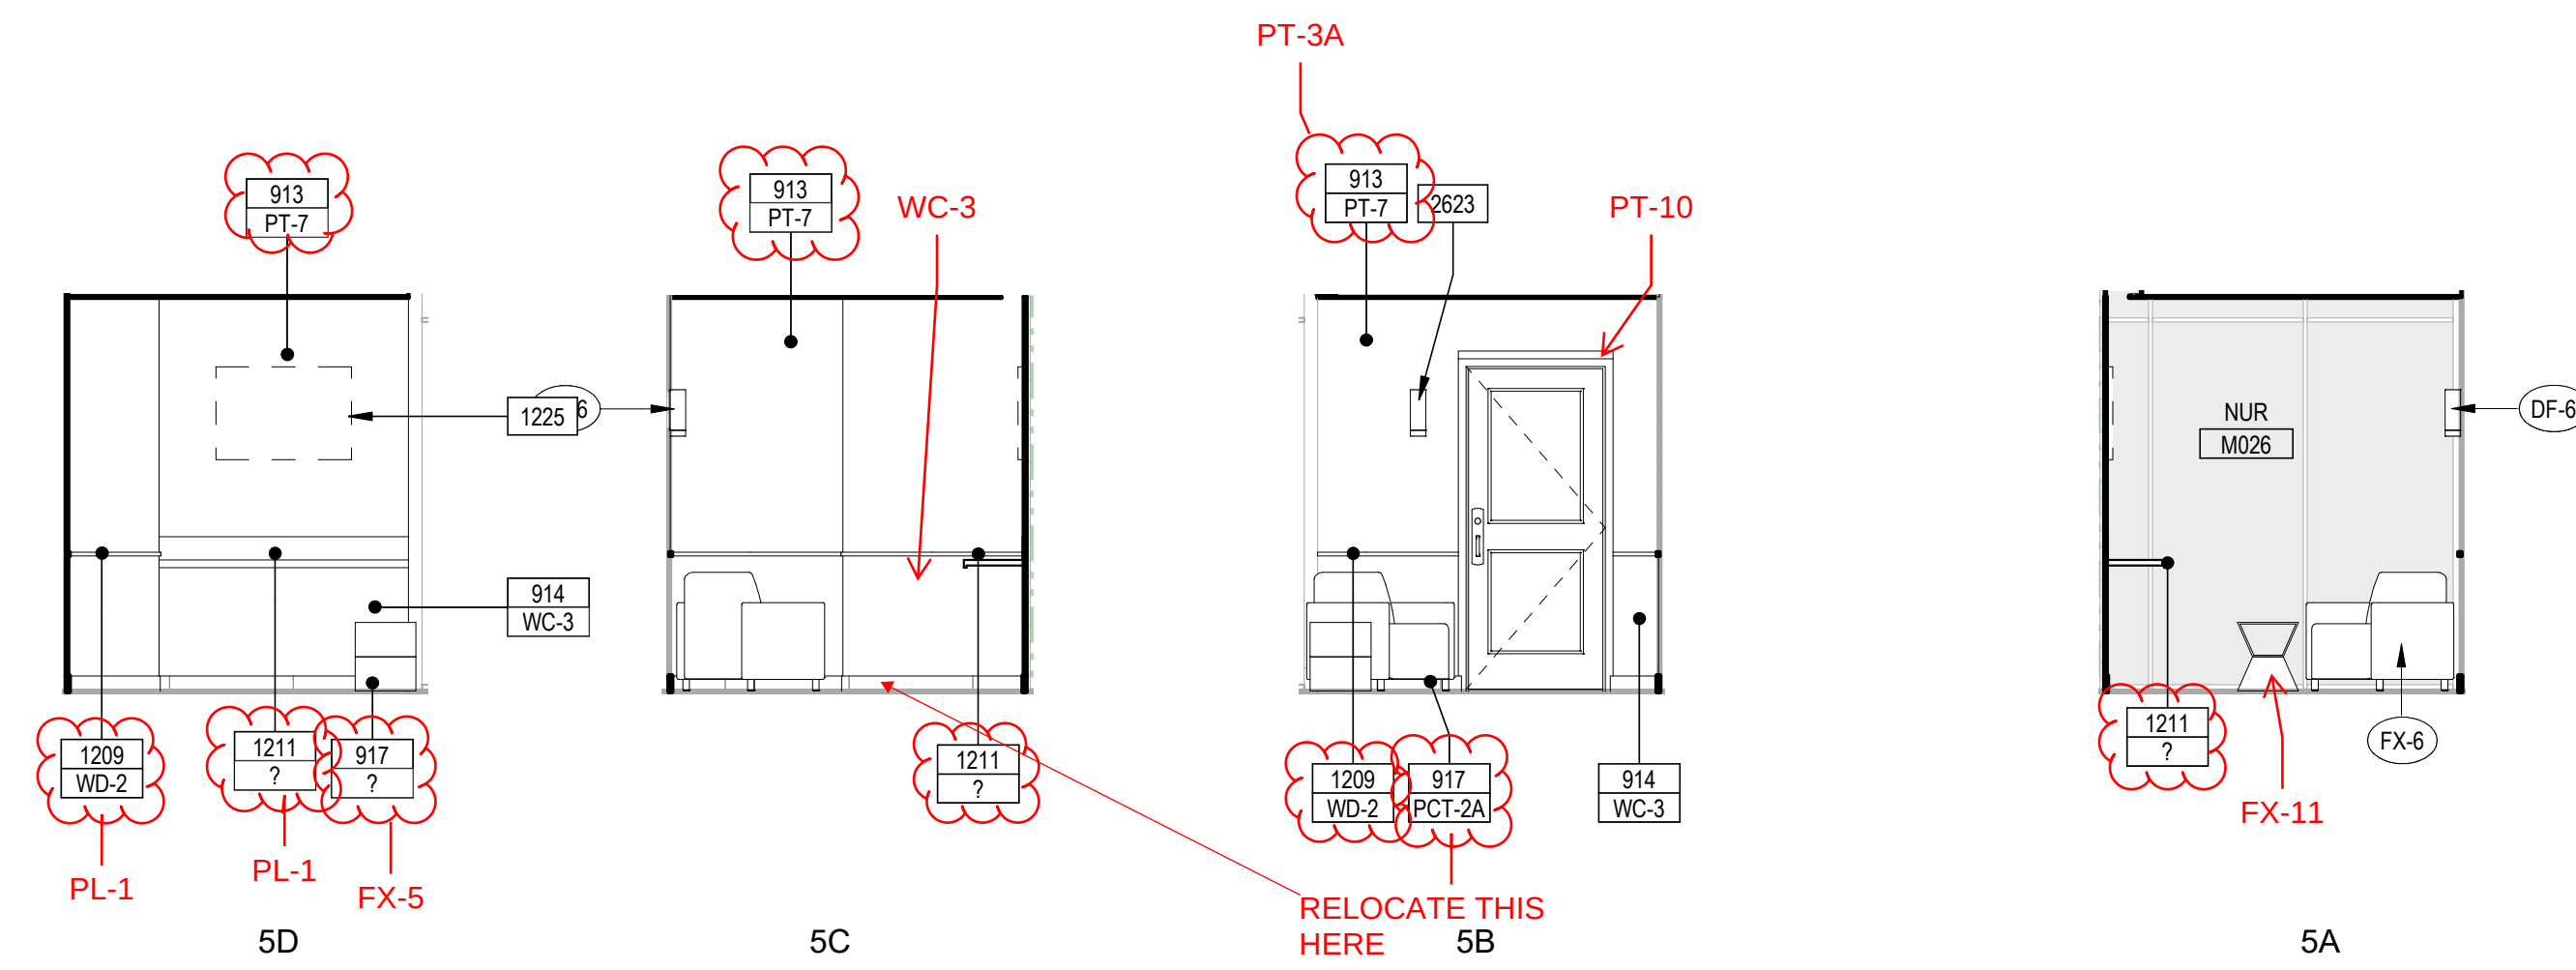


NURSING ROOM M026 - INTERIOR ELEVATIONS Scale: 1/4" 5

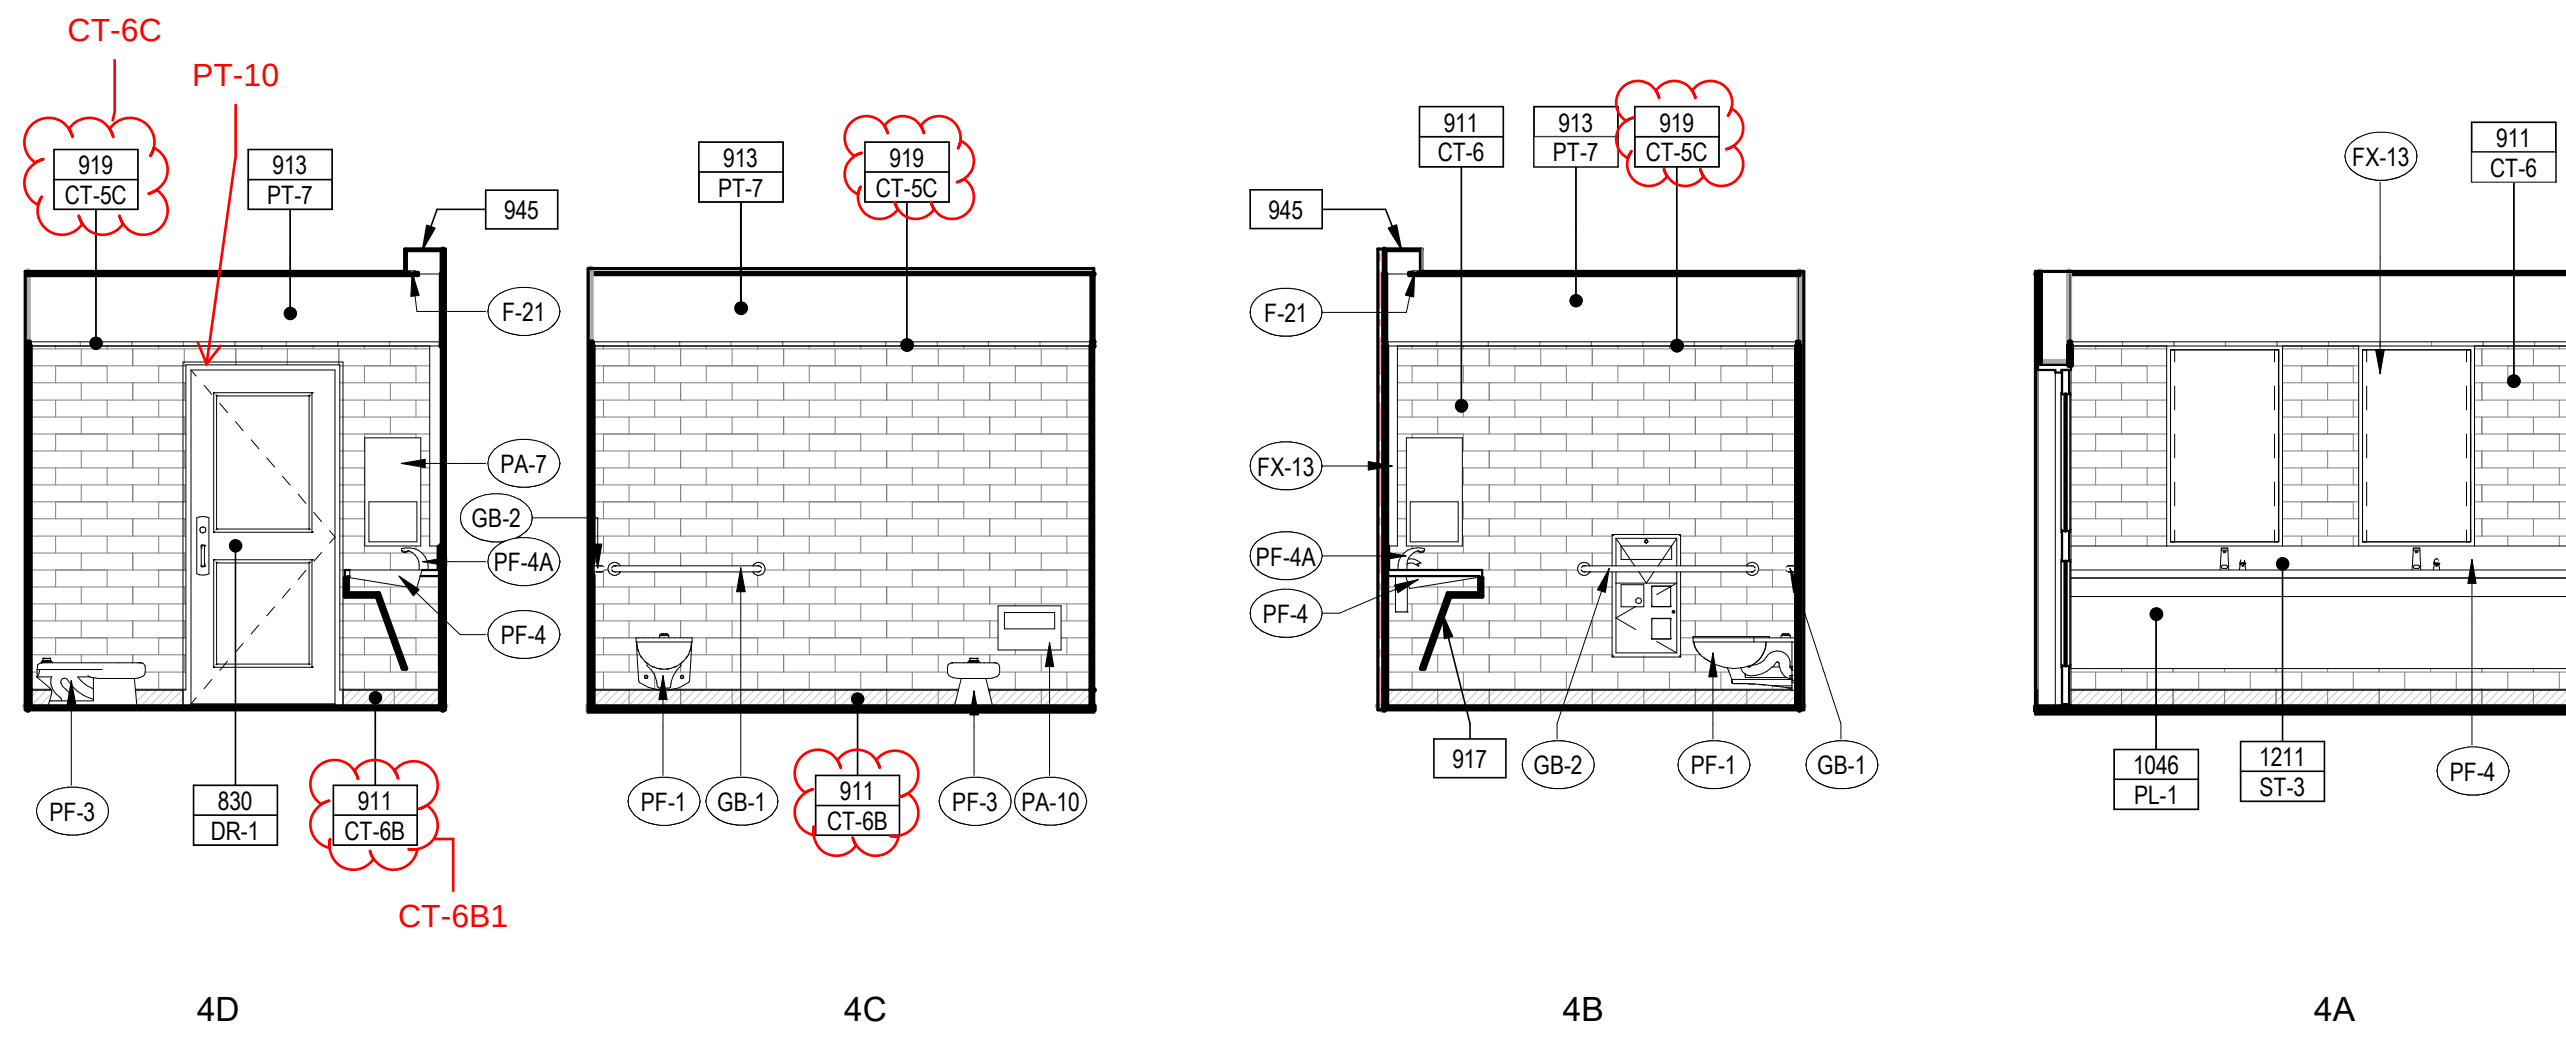


FAMILY RESTROOM M025 - INTERIOR ELEVATIONS Scale: 1/4" 4

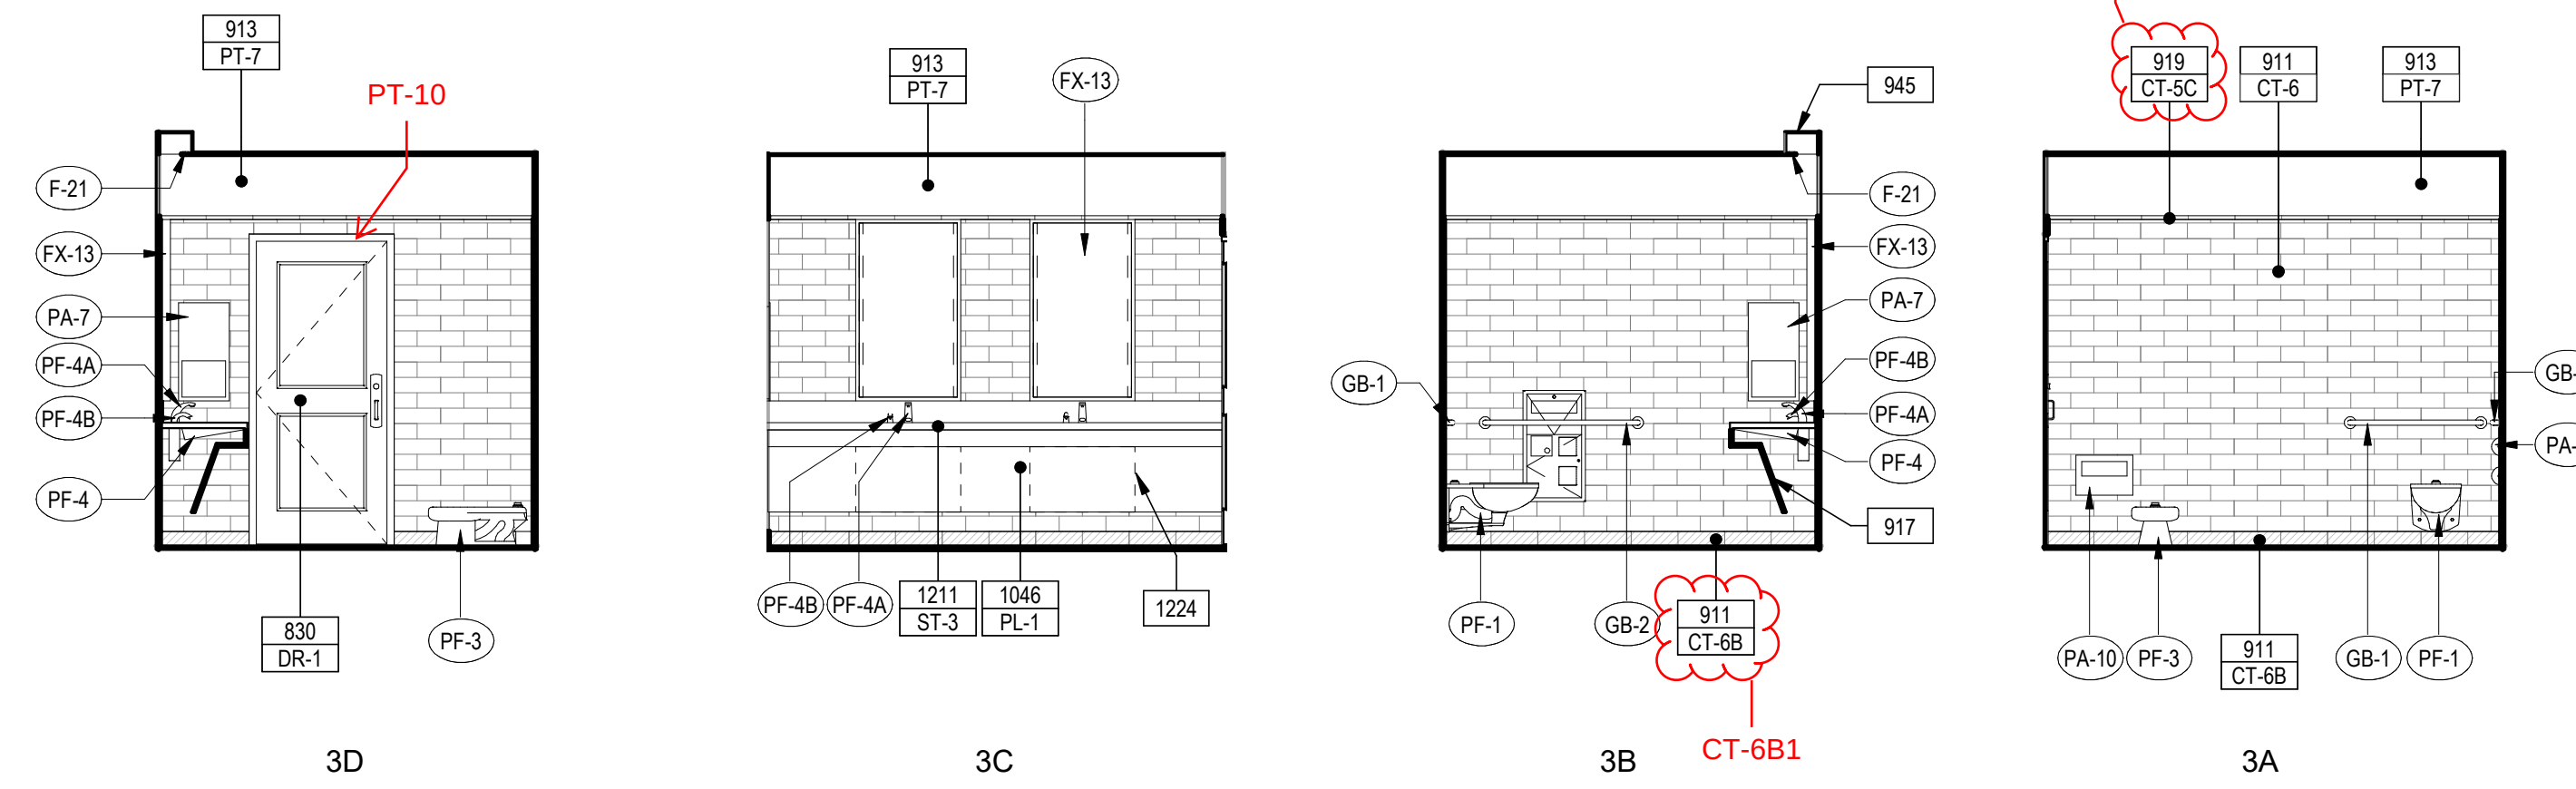

FAMILY RESTROOM M024 - INTERIOR ELEVATIONS Scale: 1/4" 3

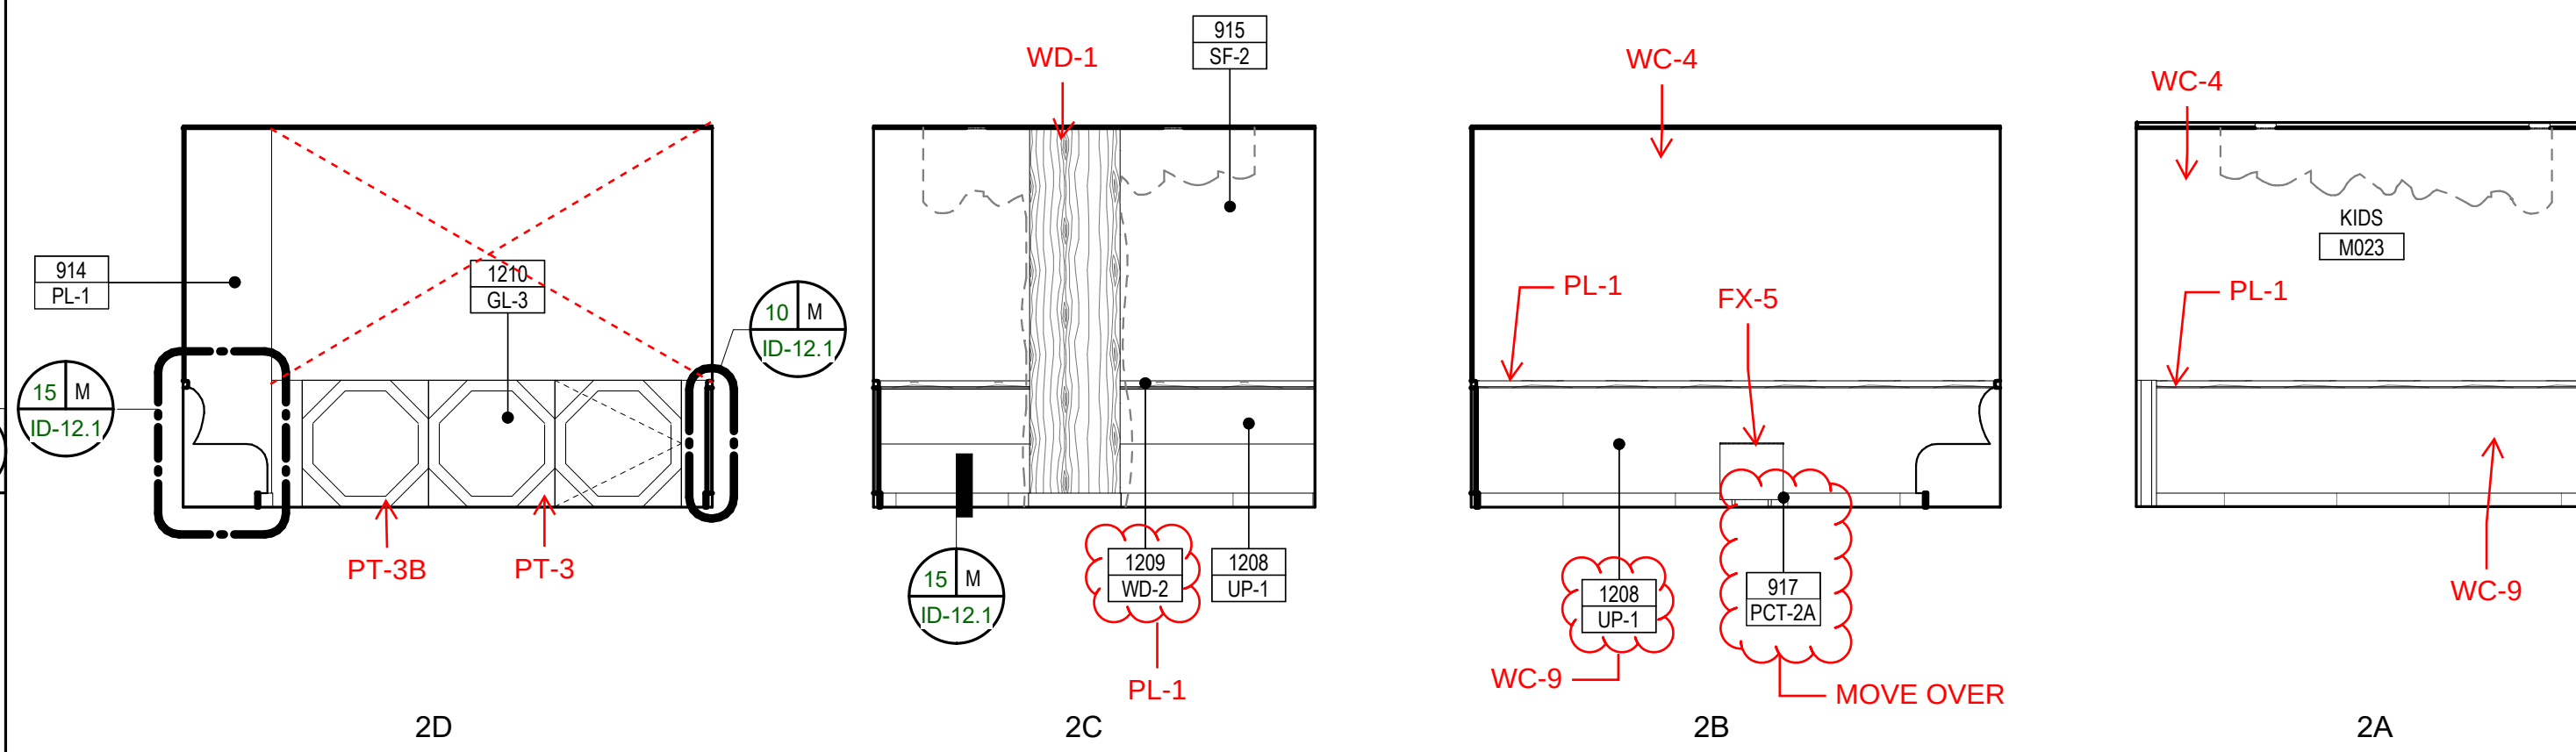

KIDS M023 - INTERIOR ELEVATIONS Scale: 1/4" 2

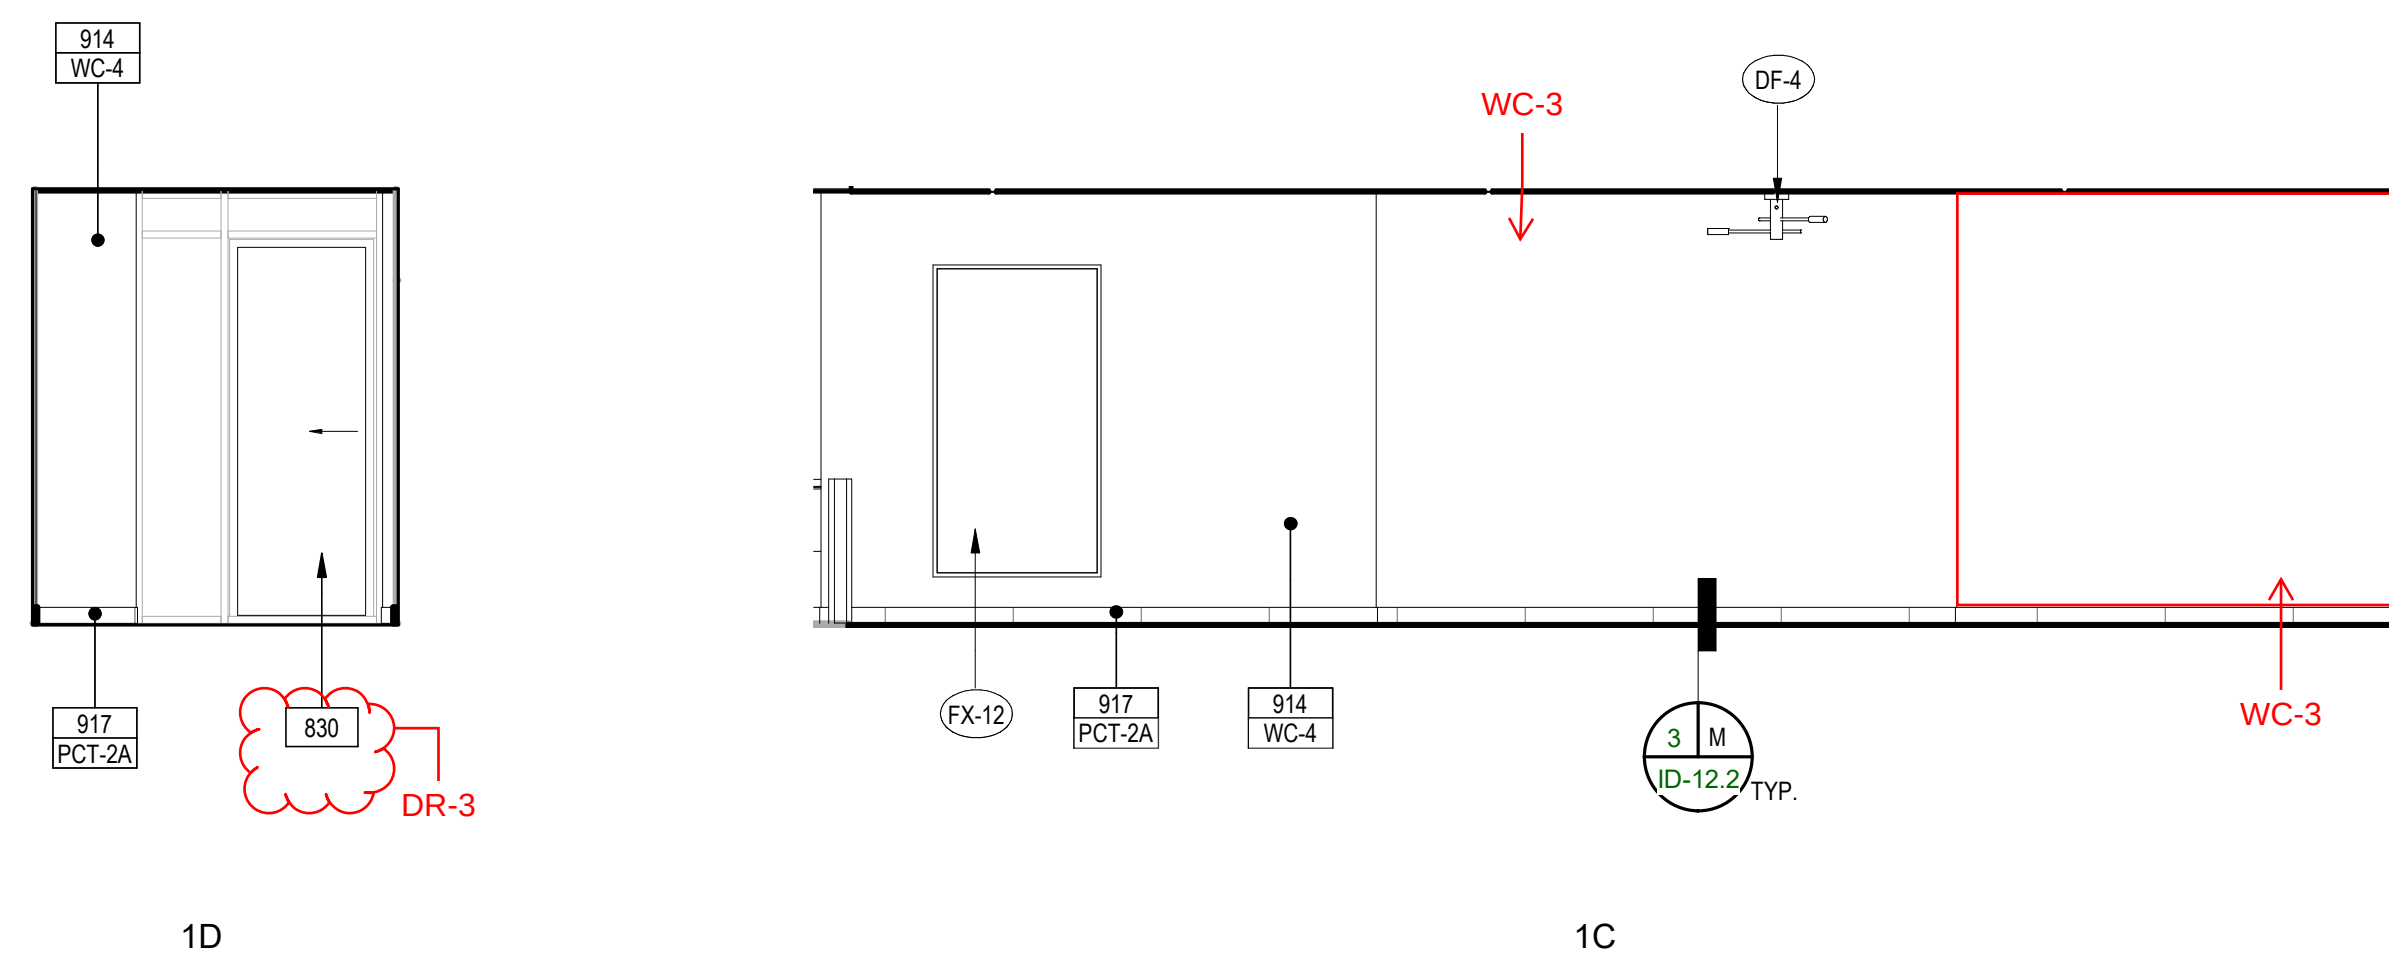


STROLLER PARKING M022 - INTERIOR ELEVATIONS Scale: 1/4" 1

KEYNOTES

- 830 DOOR PER PLAN AND DOOR SCHEDULE
- 911 PORCELAIN TILE
- 913 PAINT
- 914 WALLCOVERING
- 915 WALL DIGITAL GRAPHICS
- 917 4" TILE WALL BASE
- 919 TILE TRIM
- 945 CEILING LIGHT COVE. PAINT TO MATCH ADJ. SURFACE OR OTHERWISE INDICATED
- 1046 TOILET PARTITION
- 1208 UPHOLSTERY
- 1209 WOOD TRIM
- 1210 GATE
- 1211 STONE COUNTERTOP WITH 6" HIGH BACKSPASH
- 1224 REMOVEABLE ACCESS PANEL
- 1225 TV SCREEN
- 2623 INTERIOR SURFACE MOUNTED WALL LIGHTING FIXTURE PER ELECTRICAL DRAWINGS

ELEVATION SYMBOL LEGEND


- ### KEYNOTE REFERENCE
- ### KEYNOTE REFERENCE
- XX-# COLOR & FINISH REFERENCE
- ### FIXTURE AND FURNISHING REFERENCE

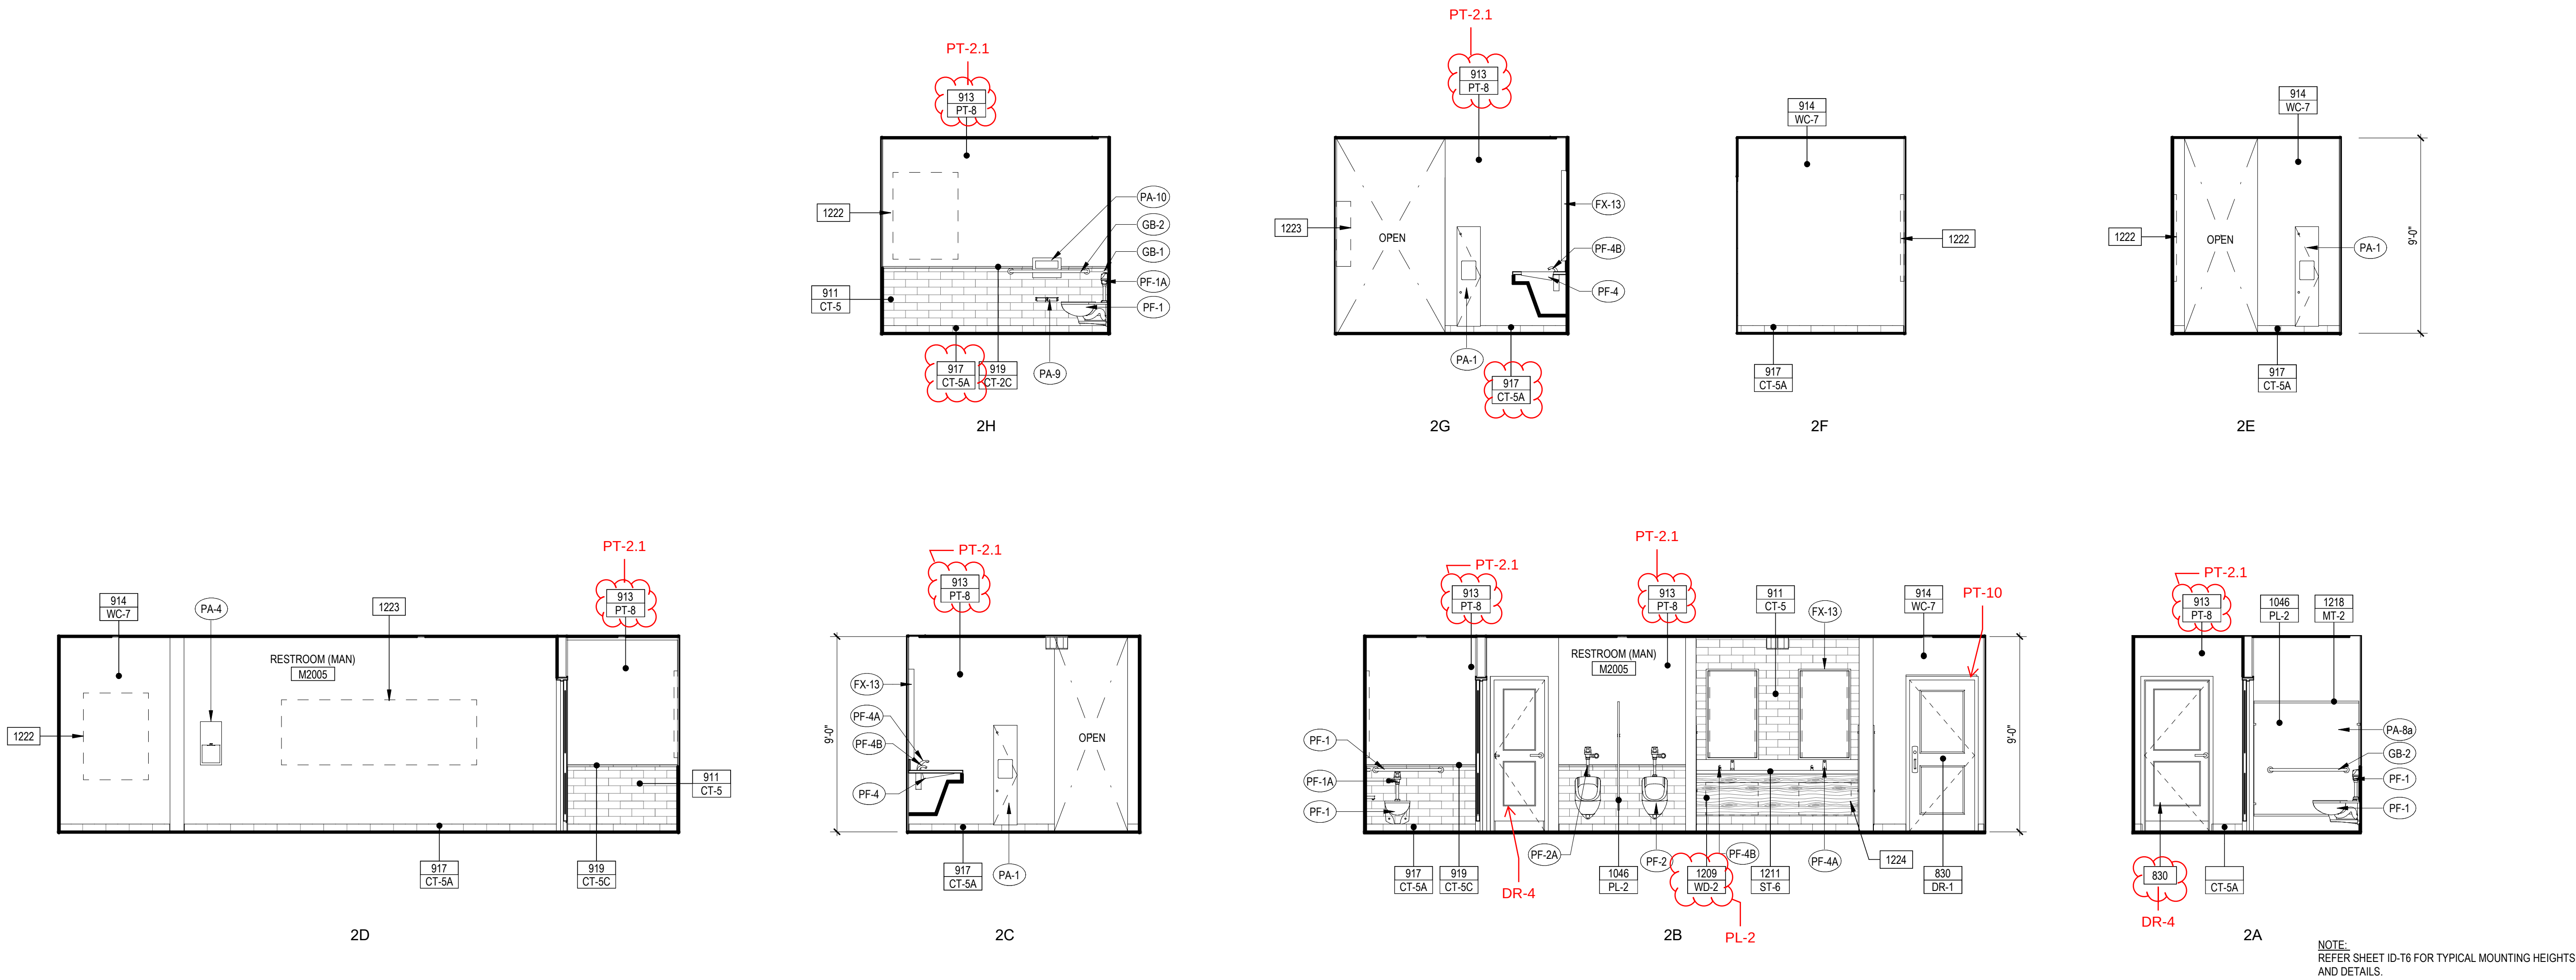

INTERIOR ELEVATIONS - RESTROOM MEN M2005

Scale:
1/4"

2

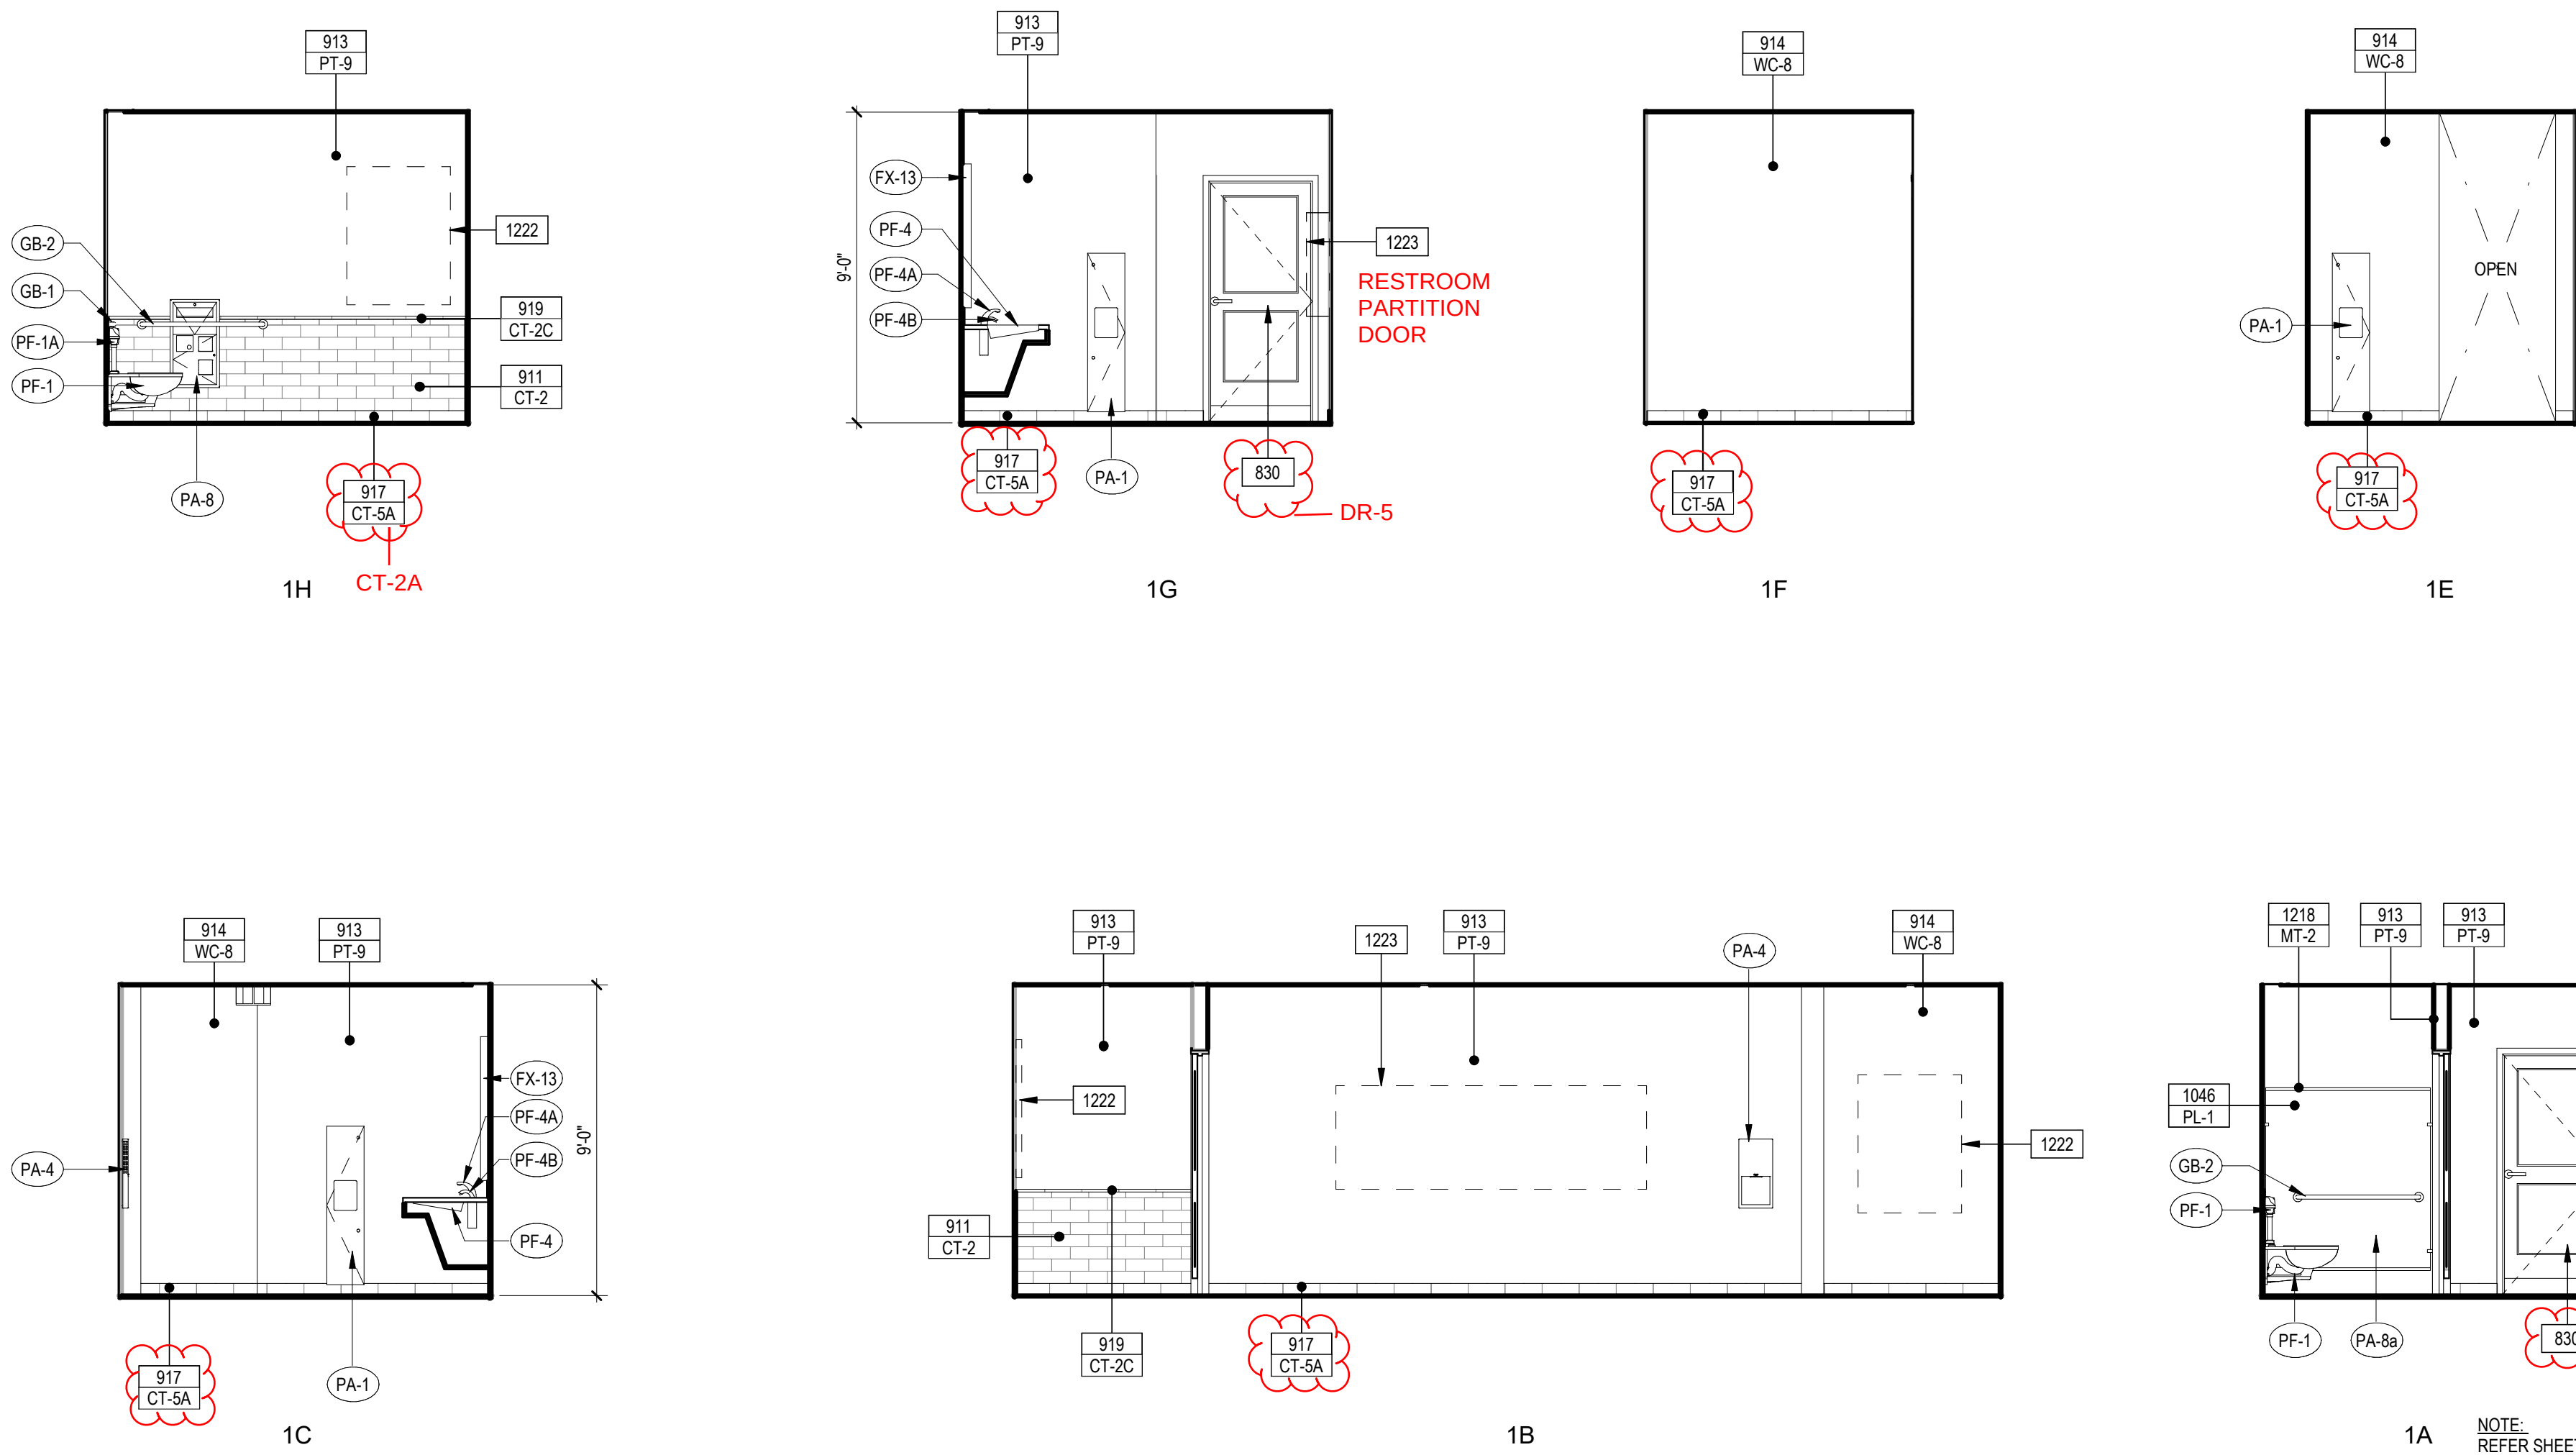

INTERIOR ELEVATIONS- RESTROOM WOMEN M2006

Scale:
1/4"


1

KEYNOTES


- ### DOOR PER PLAN AND DOOR SCHEDULE
- 911 PORCELAIN TILE
- 913 PAINT
- 914 WALLCOVERING
- 917 4" TILE WALL BASE
- 919 TILE TRIM
- 1046 TOILET PARTITION
- 1209 WOOD TRIM
- 1211 STONE COUNTERTOP WITH 6" HIGH BACKSPLASH
- 1218 METAL FRAME
- 1222 WALL ART LOCATION
- 1223 AMENITY CABINET
- 1224 REMOVEABLE ACCESS PANEL

ELEVATION SYMBOL LEGEND


- ### KEYNOTE REFERENCE
- ### KEYNOTE REFERENCE
- XX-# COLOR & FINISH REFERENCE
- ### FIXTURE AND FURNISHING REFERENCE

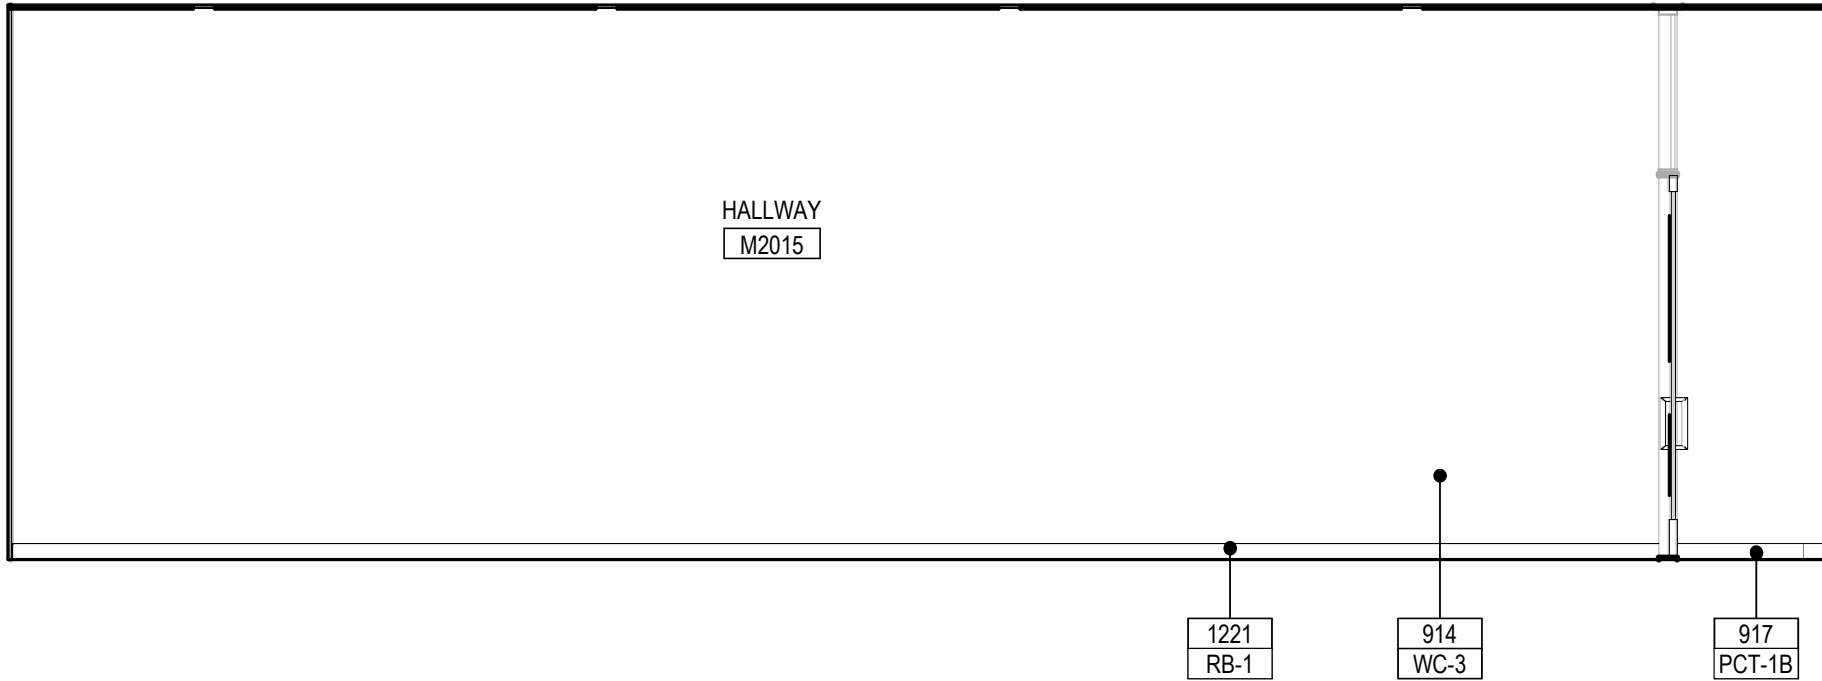


1D

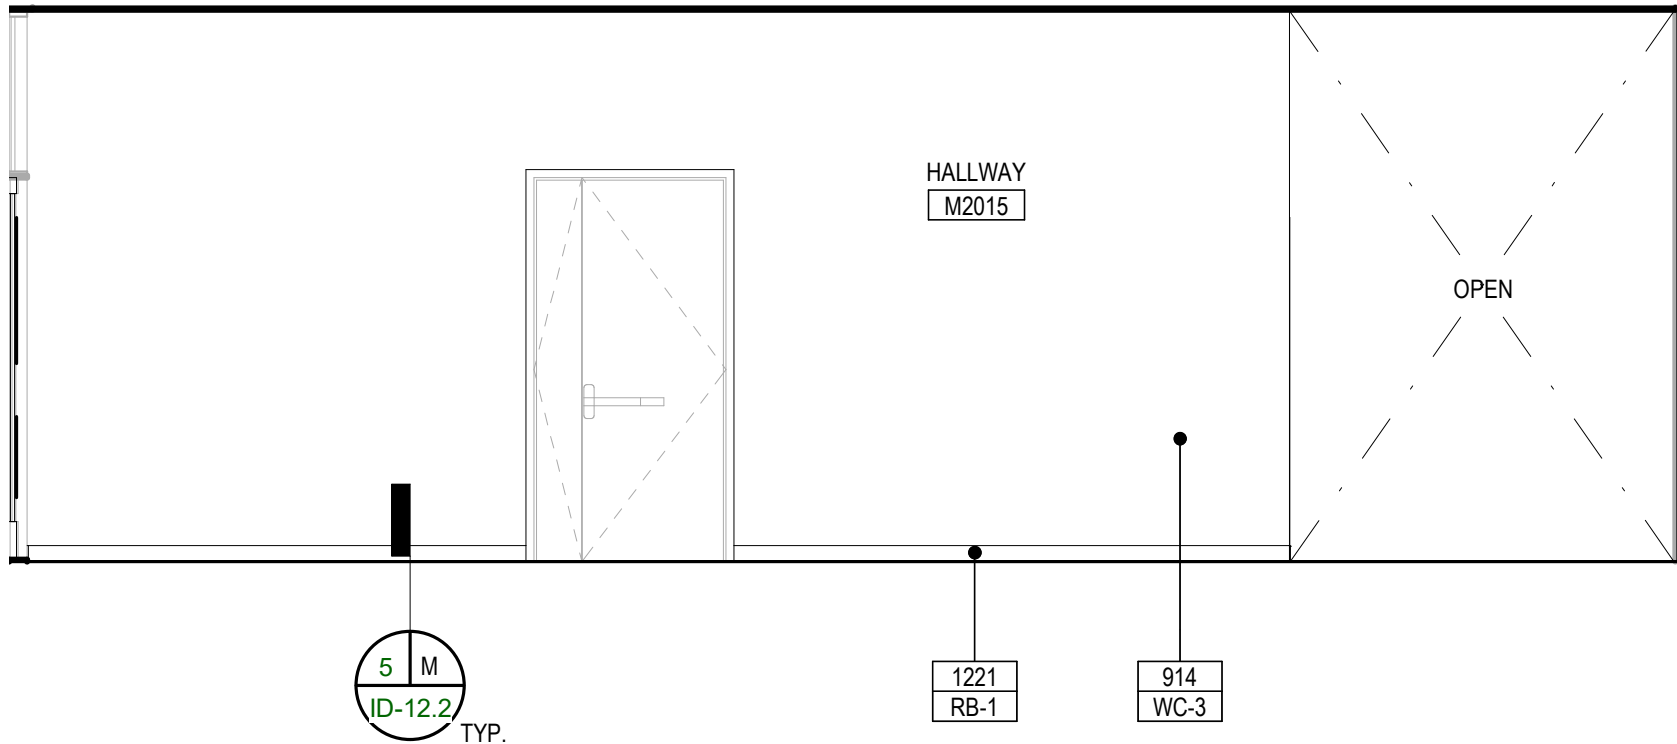


1B

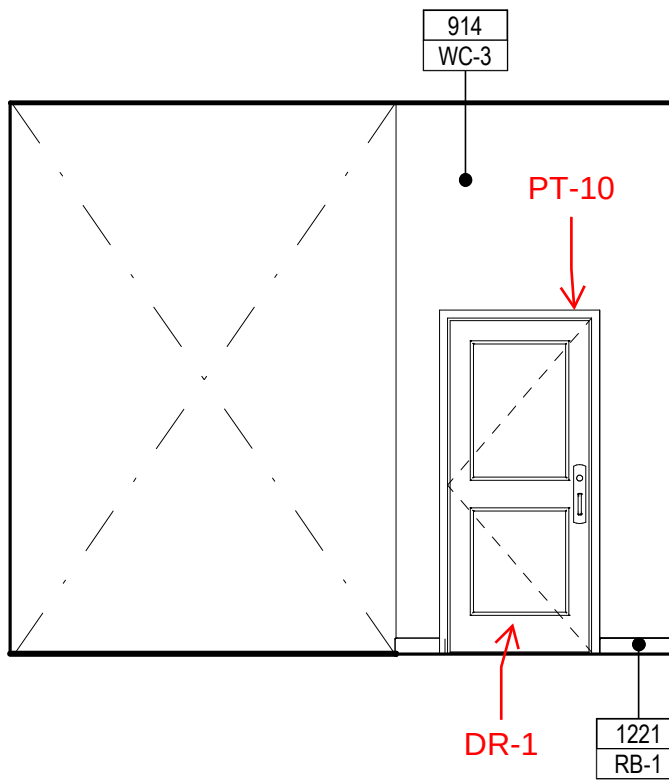


1F

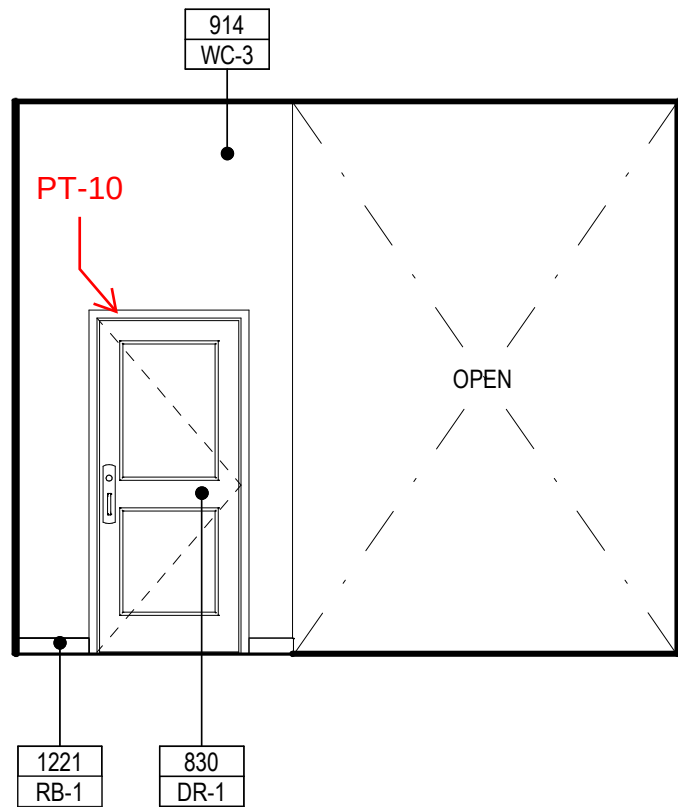

1E

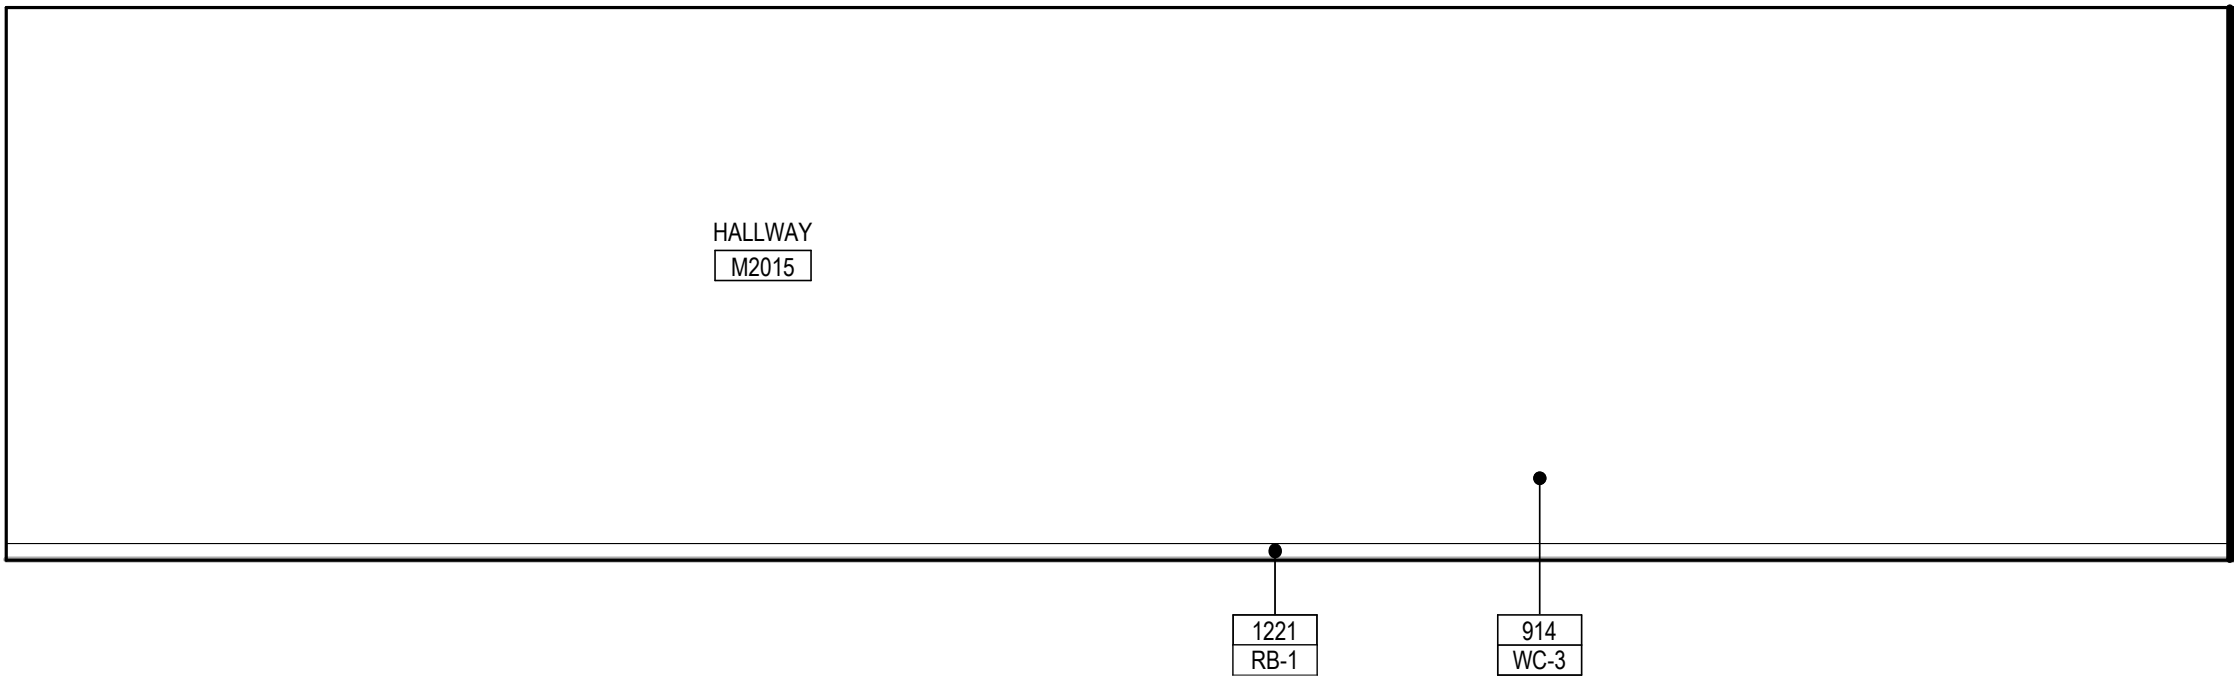

1C

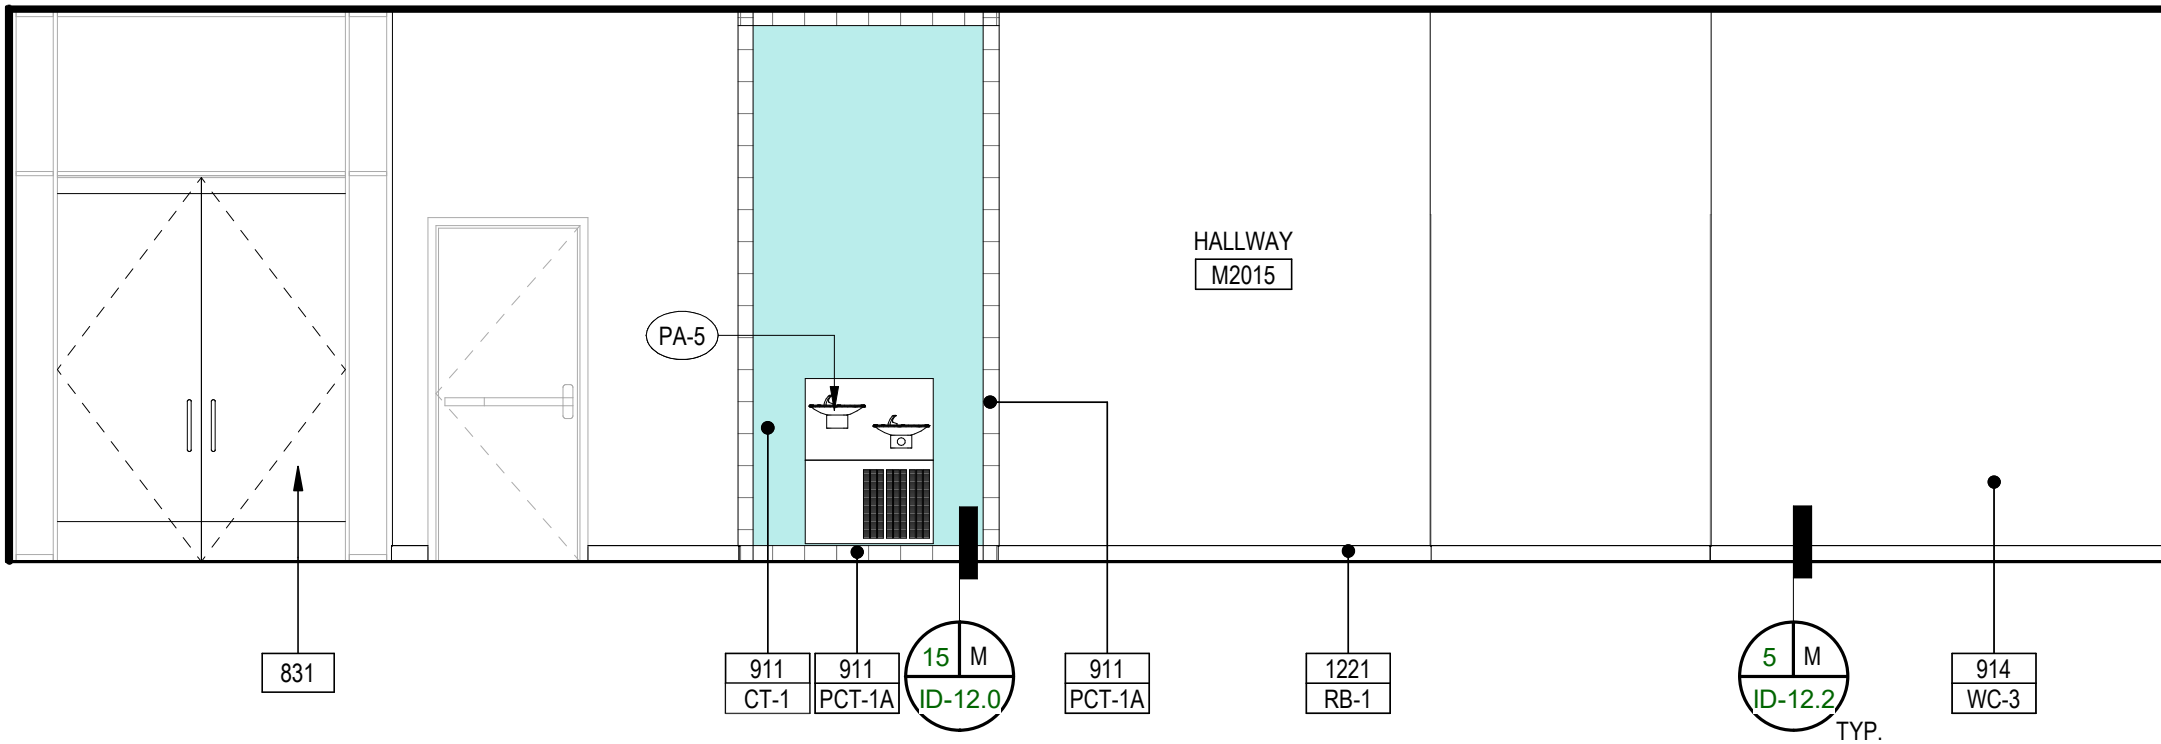

1A

CORRIDOR ELEVATIONS - HALLWAY M2015

Scale: 1/4" = 1'

###	KEYNOTES
830	DOOR PER PLAN AND DOOR SCHEDULE
831	INTERIOR ACCESS DOOR AND DOOR PER PLAN AND DOOR SCHEDULE
911	PORCELAIN TILE
914	WALLCOVERING
917	4" TILE WALL BASE
1221	RUBBER BASE


ELEVATION SYMBOL LEGEND	
###	KEYNOTE REFERENCE
###	KEYNOTE REFERENCE
XX-#	COLOR & FINISH REFERENCE
###	FIXTURE AND FURNISHING REFERENCE



ENLARGED RESTROOM FINISH PLAN - LEVEL 3

Scale: 1/4" = 1'-0"

2

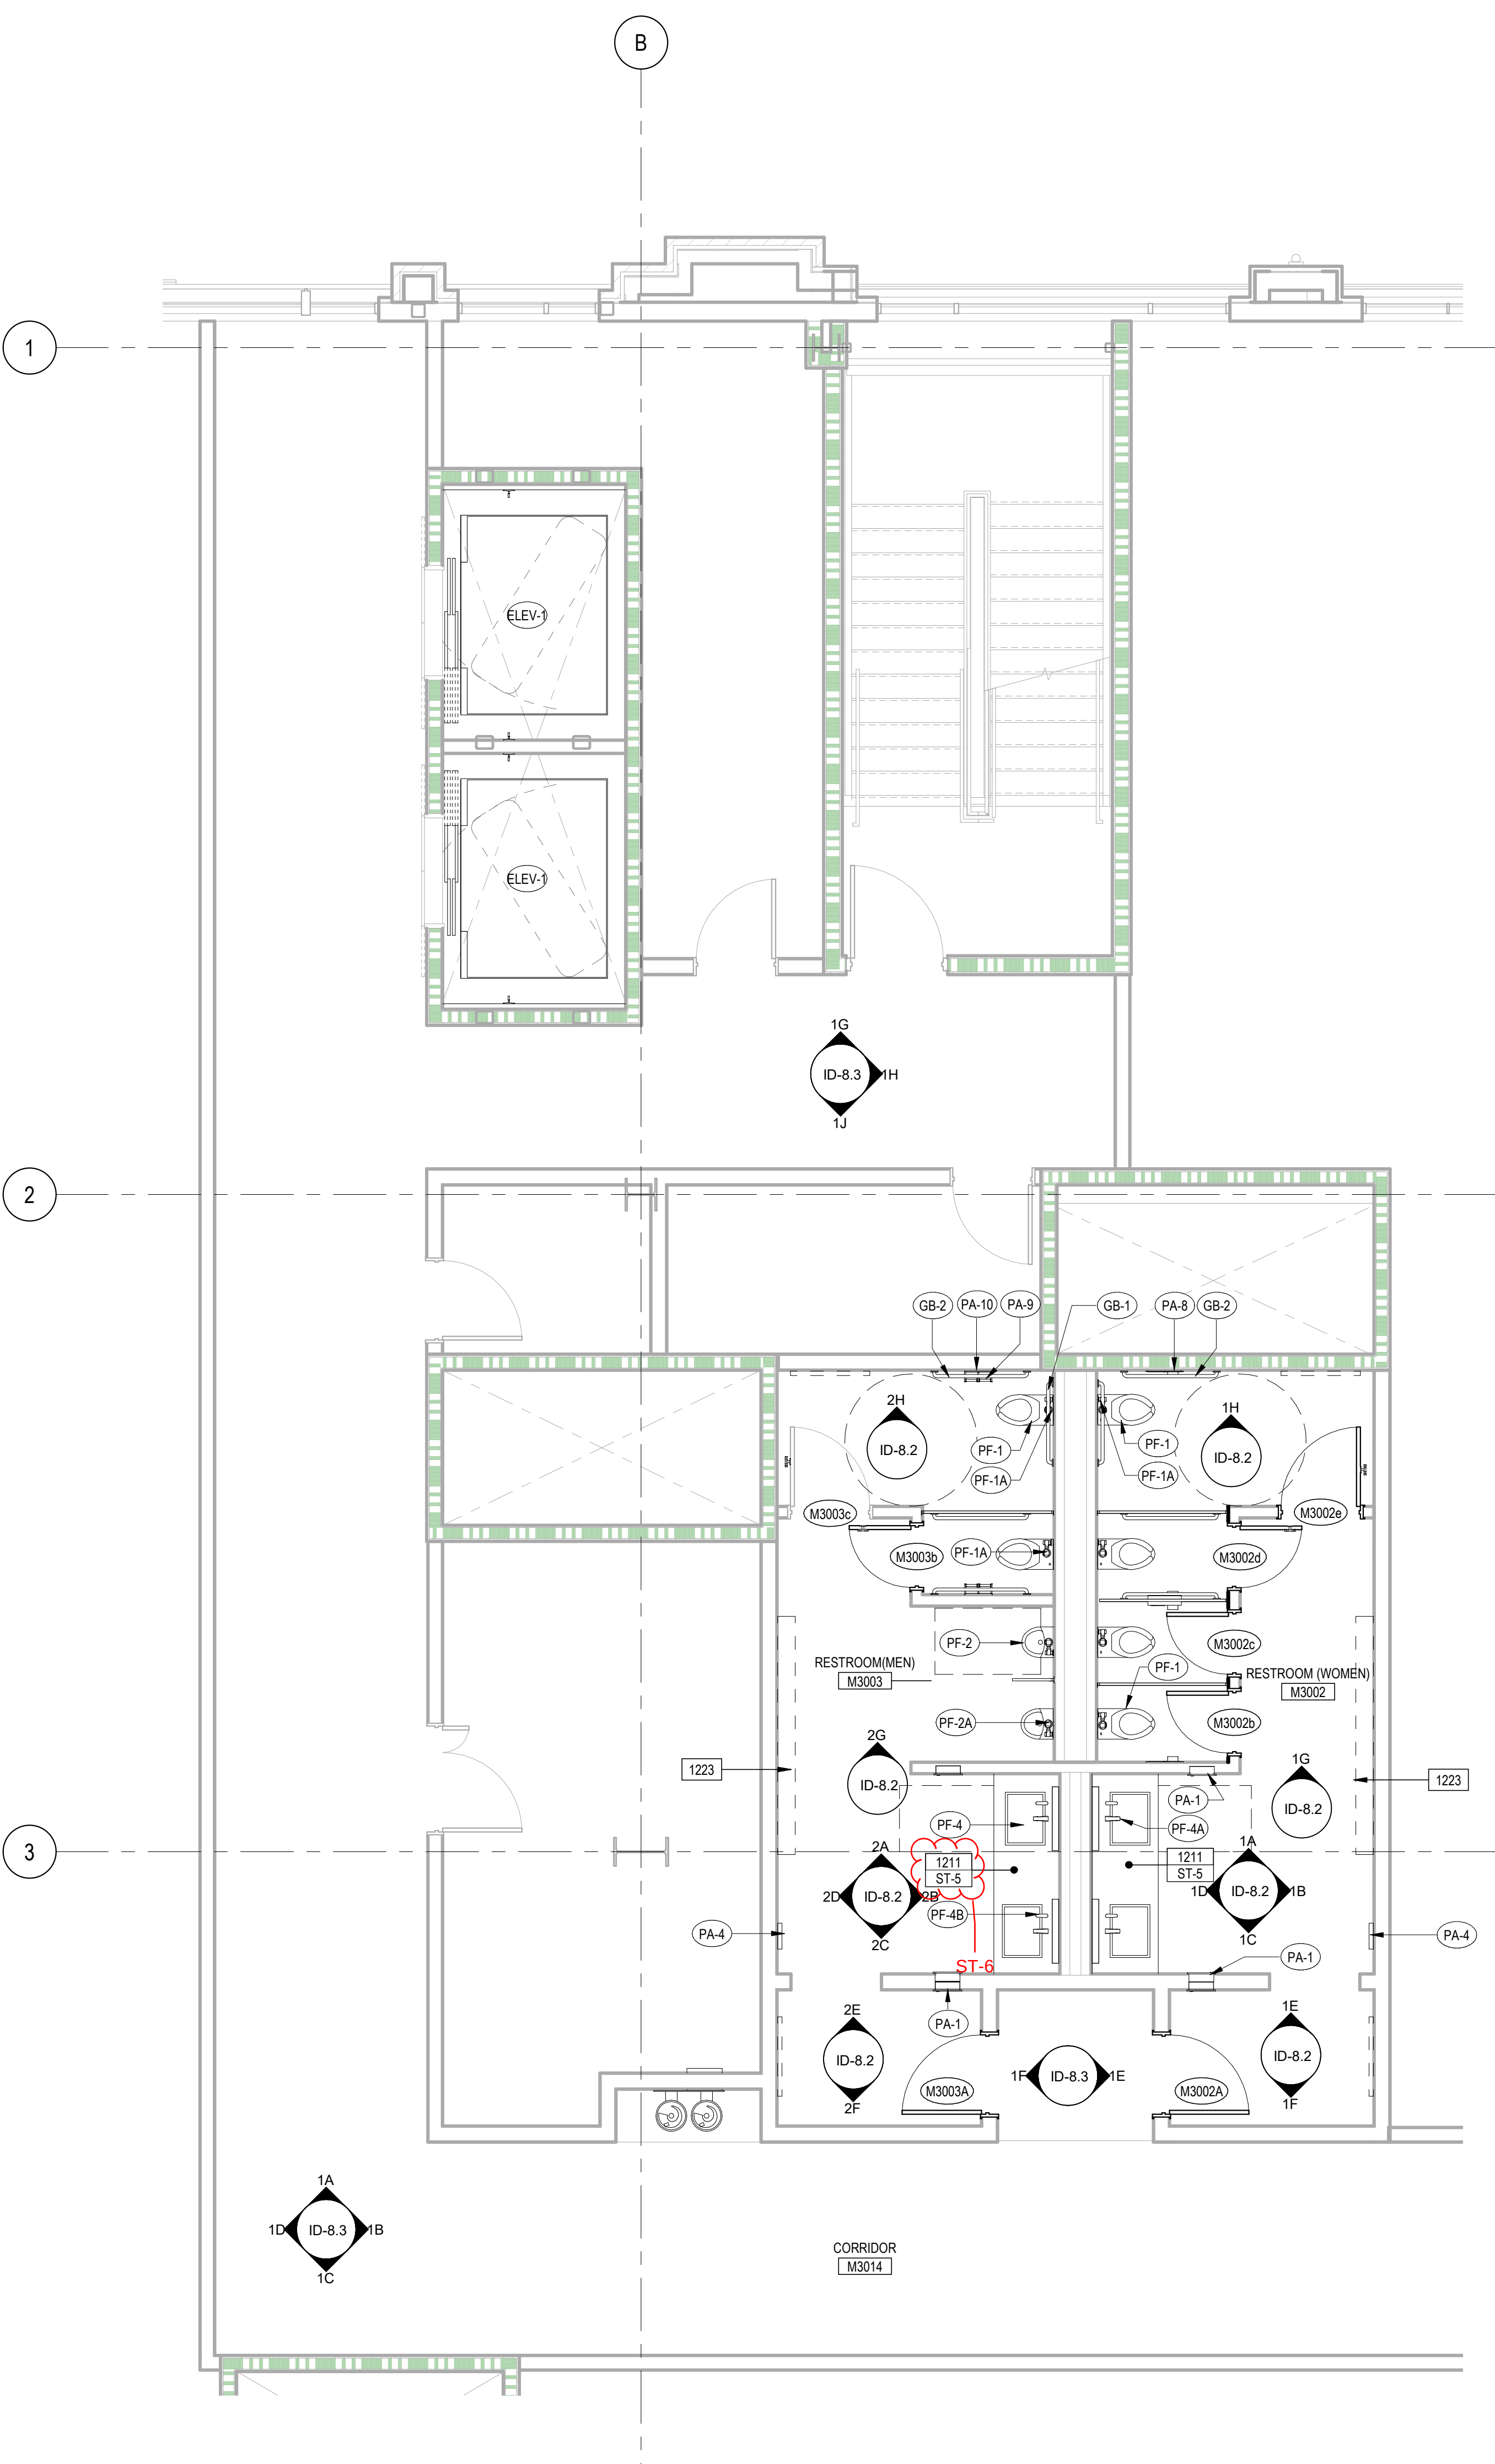

ENLARGED RESTROOM FURNISHING PLAN - LEVEL 3

Scale: 1/4" = 1'-0"

1

KEYNOTES

- 931 FLOOR TILE
- 934 CARPET
- 1211 STONE THRESHOLD
- 1223 AMENITY CABINET

FIXTURE & FURNISHING SYMBOL LEGEND

FIXTURE AND FURNISHING REFERENCE

FINISH PLAN SYMBOL LEGEND

- NON-RATED WALLS (SHELL SCOPE)
- 1 HR FIRE RATED WALLS (SHELL SCOPE)
- 2 HR FIRE RATED WALLS (SHELL SCOPE)

FINISH START SYMBOL

- KEYNOTE REFERENCE
- KEYNOTE REFERENCE
- COLOR & FINISH REFERENCE




Scale:
 $1/4" = 1'-0"$

1

S H E E T
M
ID-8.1

© 2016 Architects Orange. These plans are copyright protected. Unless and protection unauthorized use is not permitted. These plans shall not be reproduced or used without written permission by Architects Orange.

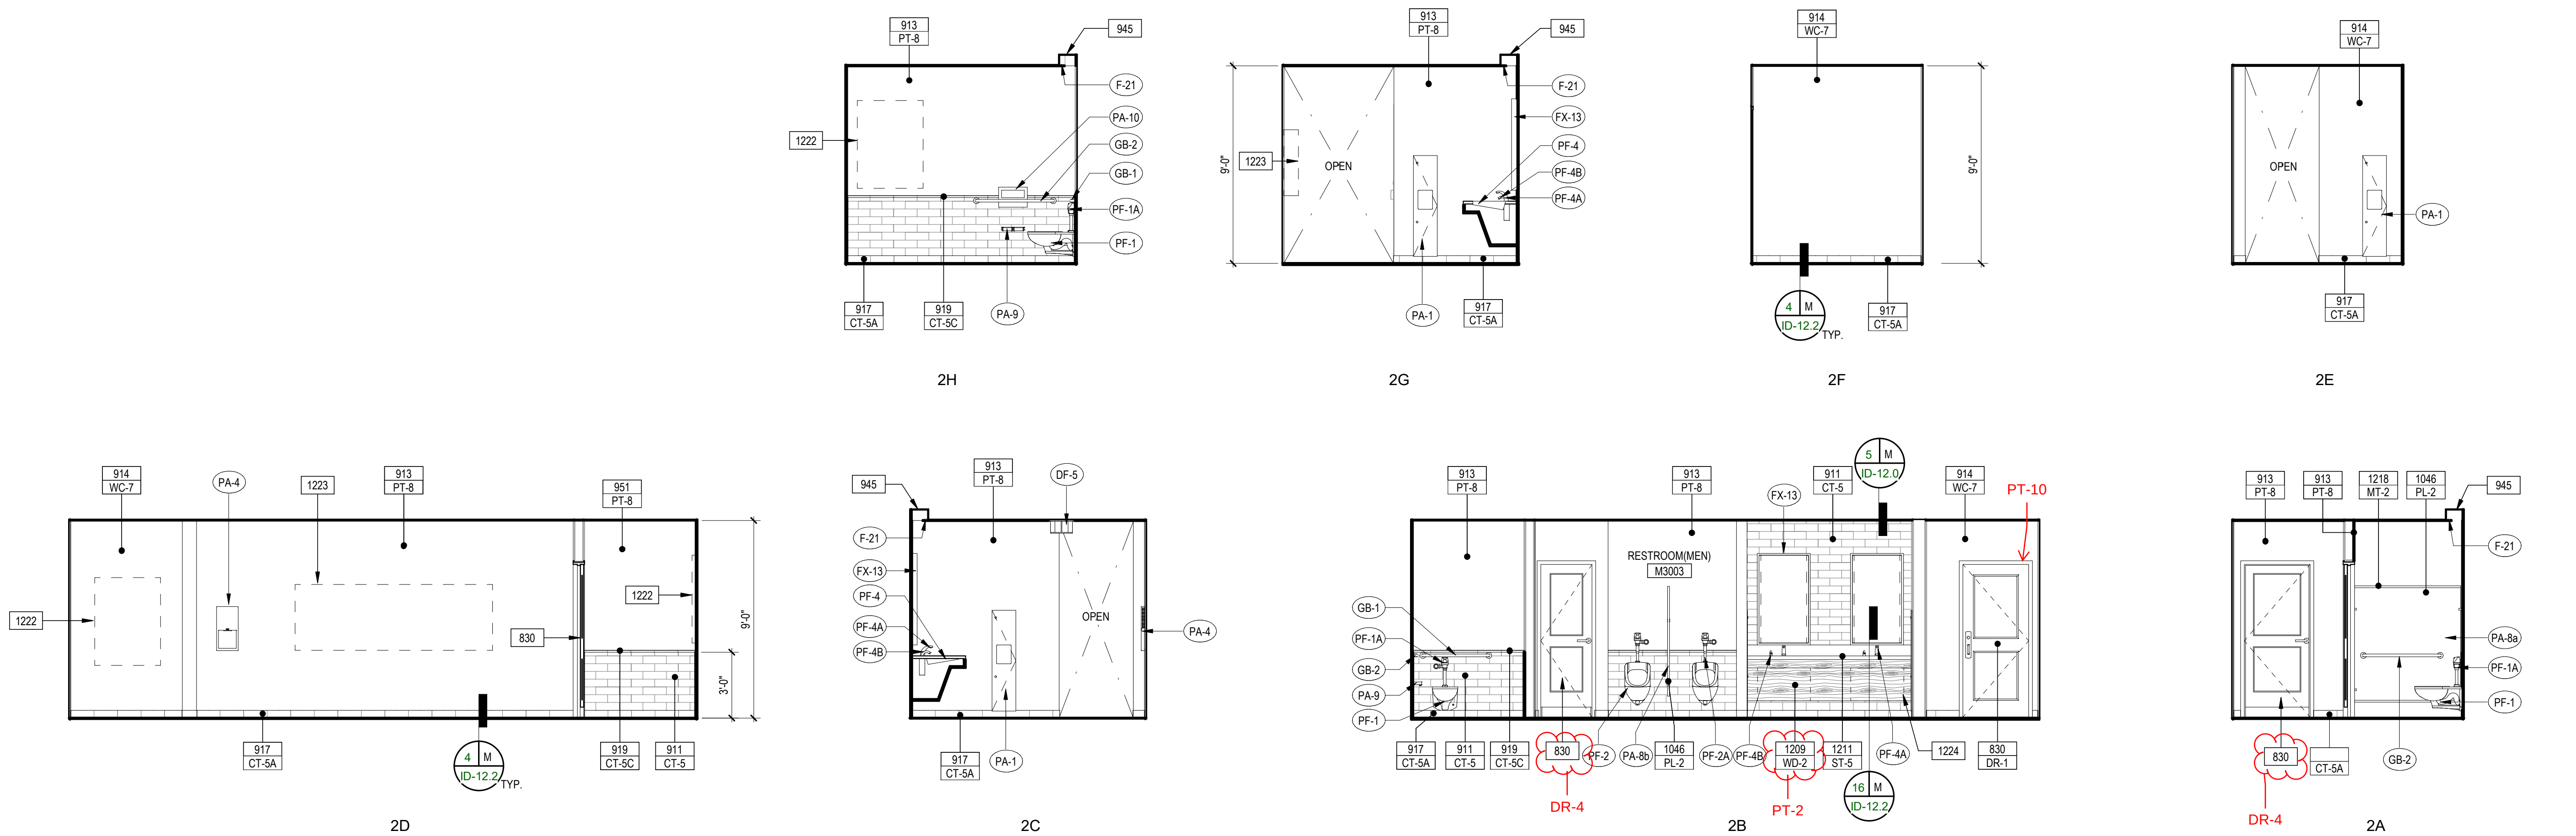

NOTE:
REFER TO SHEET ID-T6 FOR TYPICAL MOUNTING
HEIGHTS AND DETAILS.


INTERIOR ELEVATIONS - RESTROOM MEN M30003

Scale:
1/4"

2

KEYNOTES

- 830 DOOR PER PLAN AND DOOR SCHEDULE
- 911 PORCELAIN TILE
- 913 PAINT
- 914 WALLCOVERING
- 917 4" TILE WALL BASE
- 919 TILE TRIM
- 945 CEILING LIGHT COVE. PAINT TO MATCH ADJ. SURFACE OR OTHERWISE INDICATED
- 951 MOLDED EPS FOAM TRIM. SMOOTH FINISH
- 1046 TOILET PARTITION
- 1209 WOOD TRIM
- 1211 STONE COUNTERTOP WITH 6" HIGH BACKSPLASH
- 1218 METAL FRAME
- 1222 WALL ART LOCATION
- 1223 AMENITY CABINET
- 1224 REMOVEABLE ACCESS PANEL

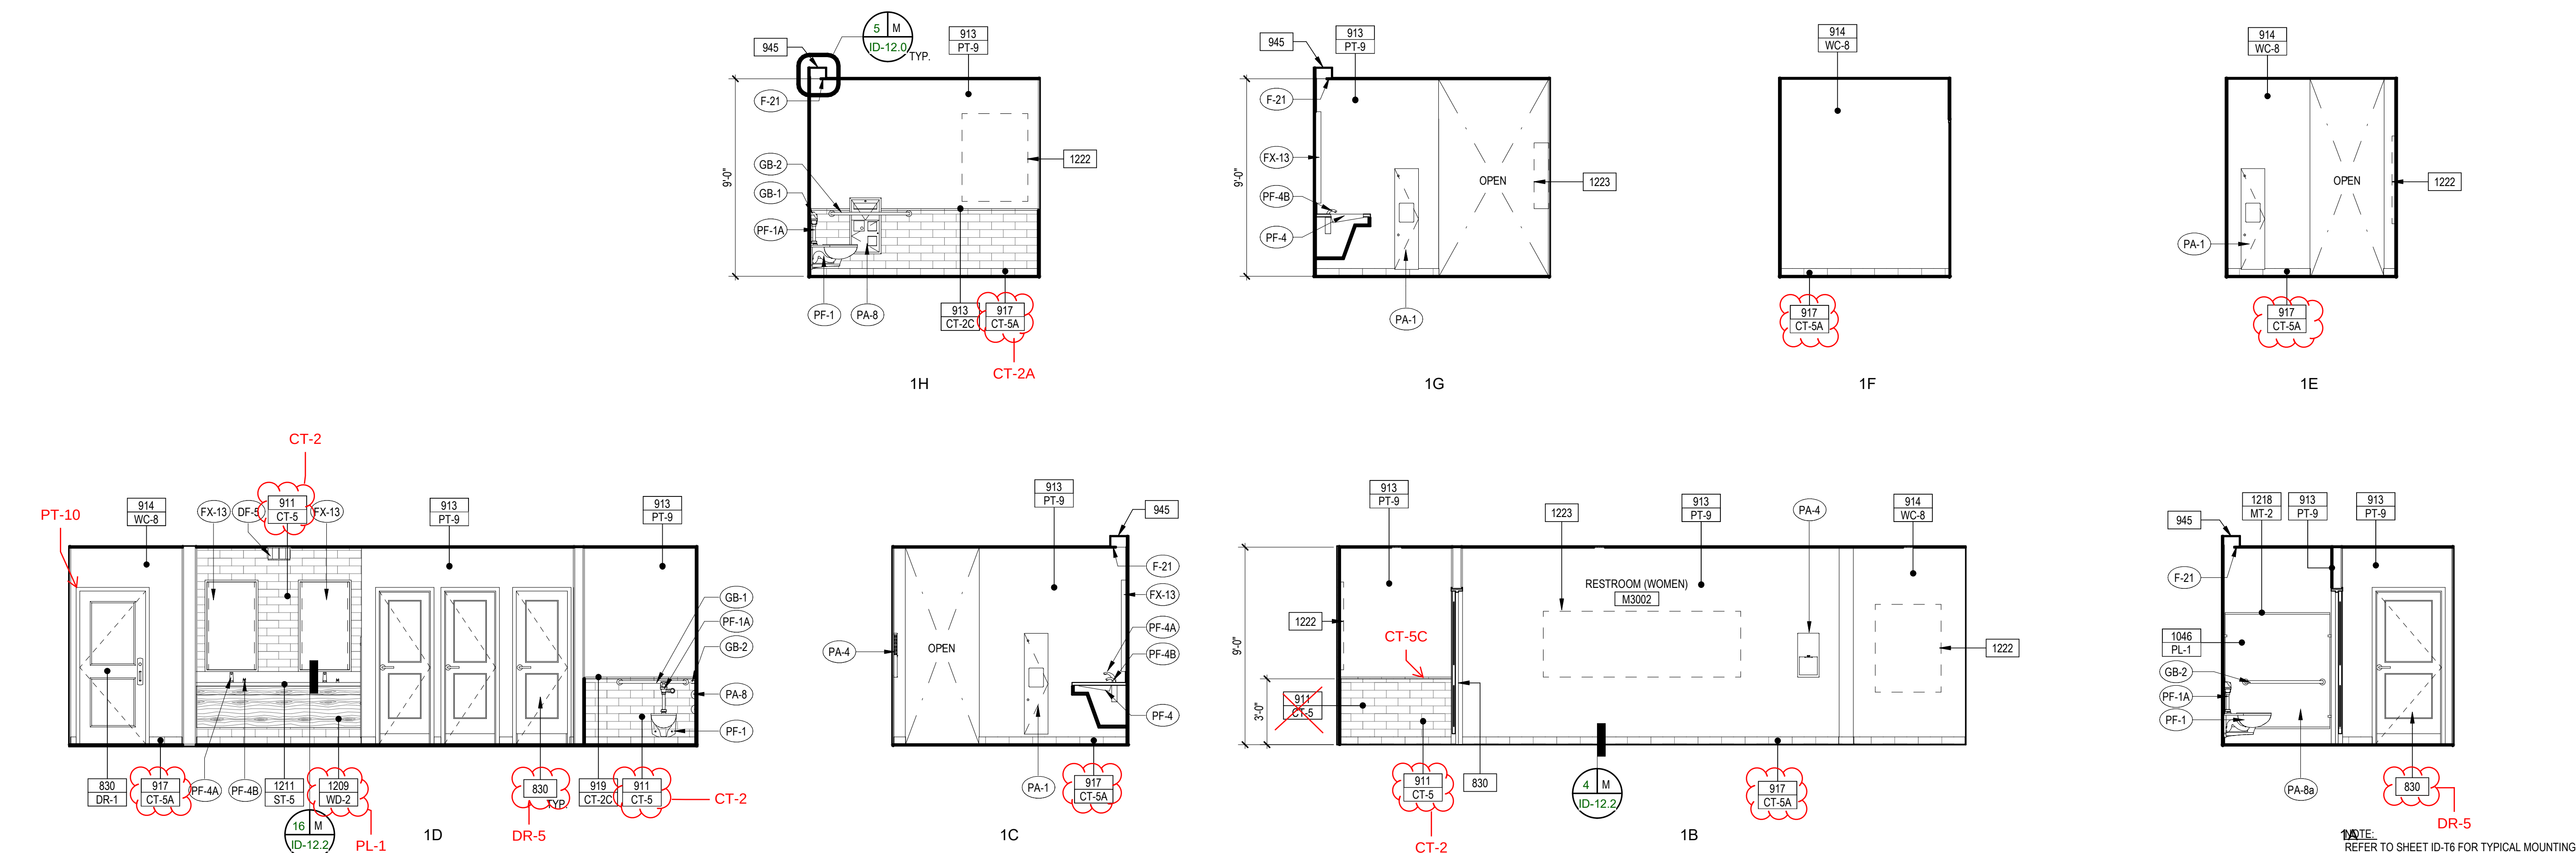

NOTE:
REFER TO SHEET ID-T6 FOR TYPICAL MOUNTING
HEIGHTS AND DETAILS.


INTERIOR ELEVATIONS - RESTROOM WOMEN M3002

Scale:
1/4"

1

ELEVATION SYMBOL LEGEND

- ### KEYNOTE REFERENCE
- ### KEYNOTE REFERENCE
- XX-# COLOR & FINISH REFERENCE
- ### FIXTURE AND FURNISHING REFERENCE

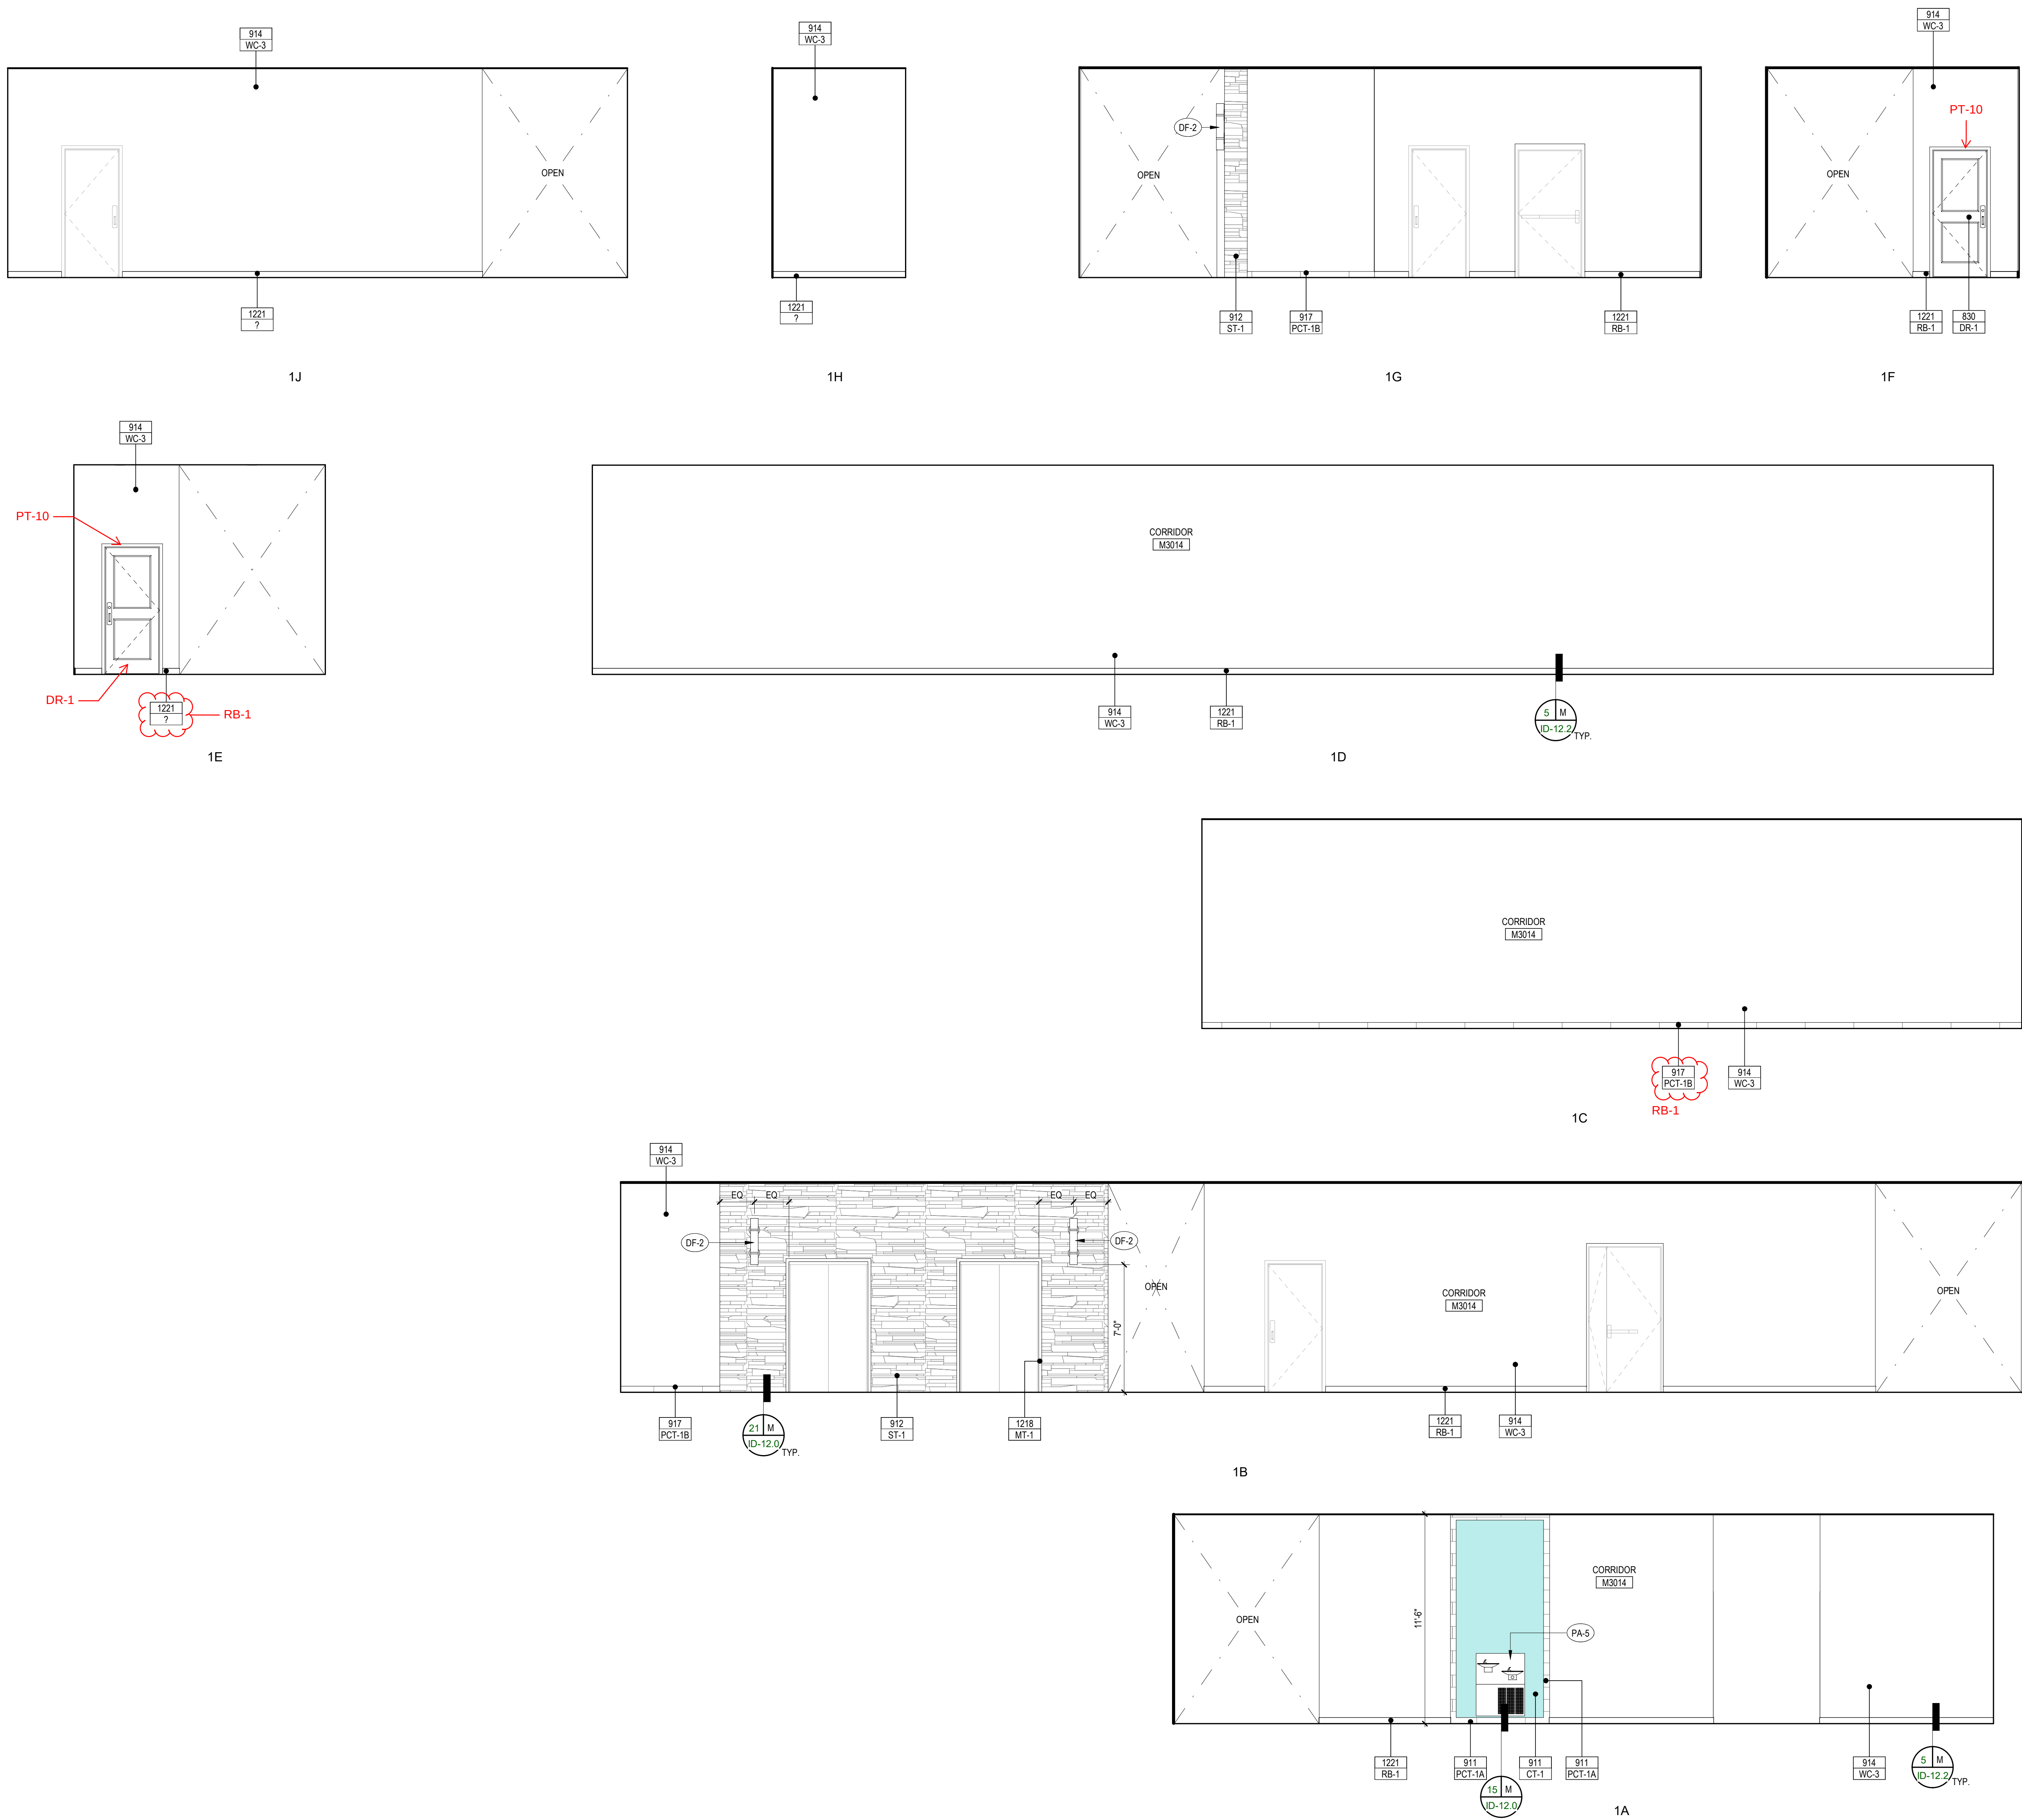

CORRIDOR ELEVATIONS - HALLWAY M3014

Scale:
1/4"


1

KEYNOTES

- 830 DOOR PER PLAN AND DOOR SCHEDULE
- 911 PORCELAIN TILE
- 912 STONE
- 914 WALLCOVERING
- 917 4" TILE WALL BASE
- 1218 METAL FRAME
- 1221 RUBBER BASE

ELEVATION SYMBOL LEGEND


- ### KEYNOTE REFERENCE
- ### KEYNOTE REFERENCE
- XX-# COLOR & FINISH REFERENCE
- ### FIXTURE AND FURNISHING REFERENCE

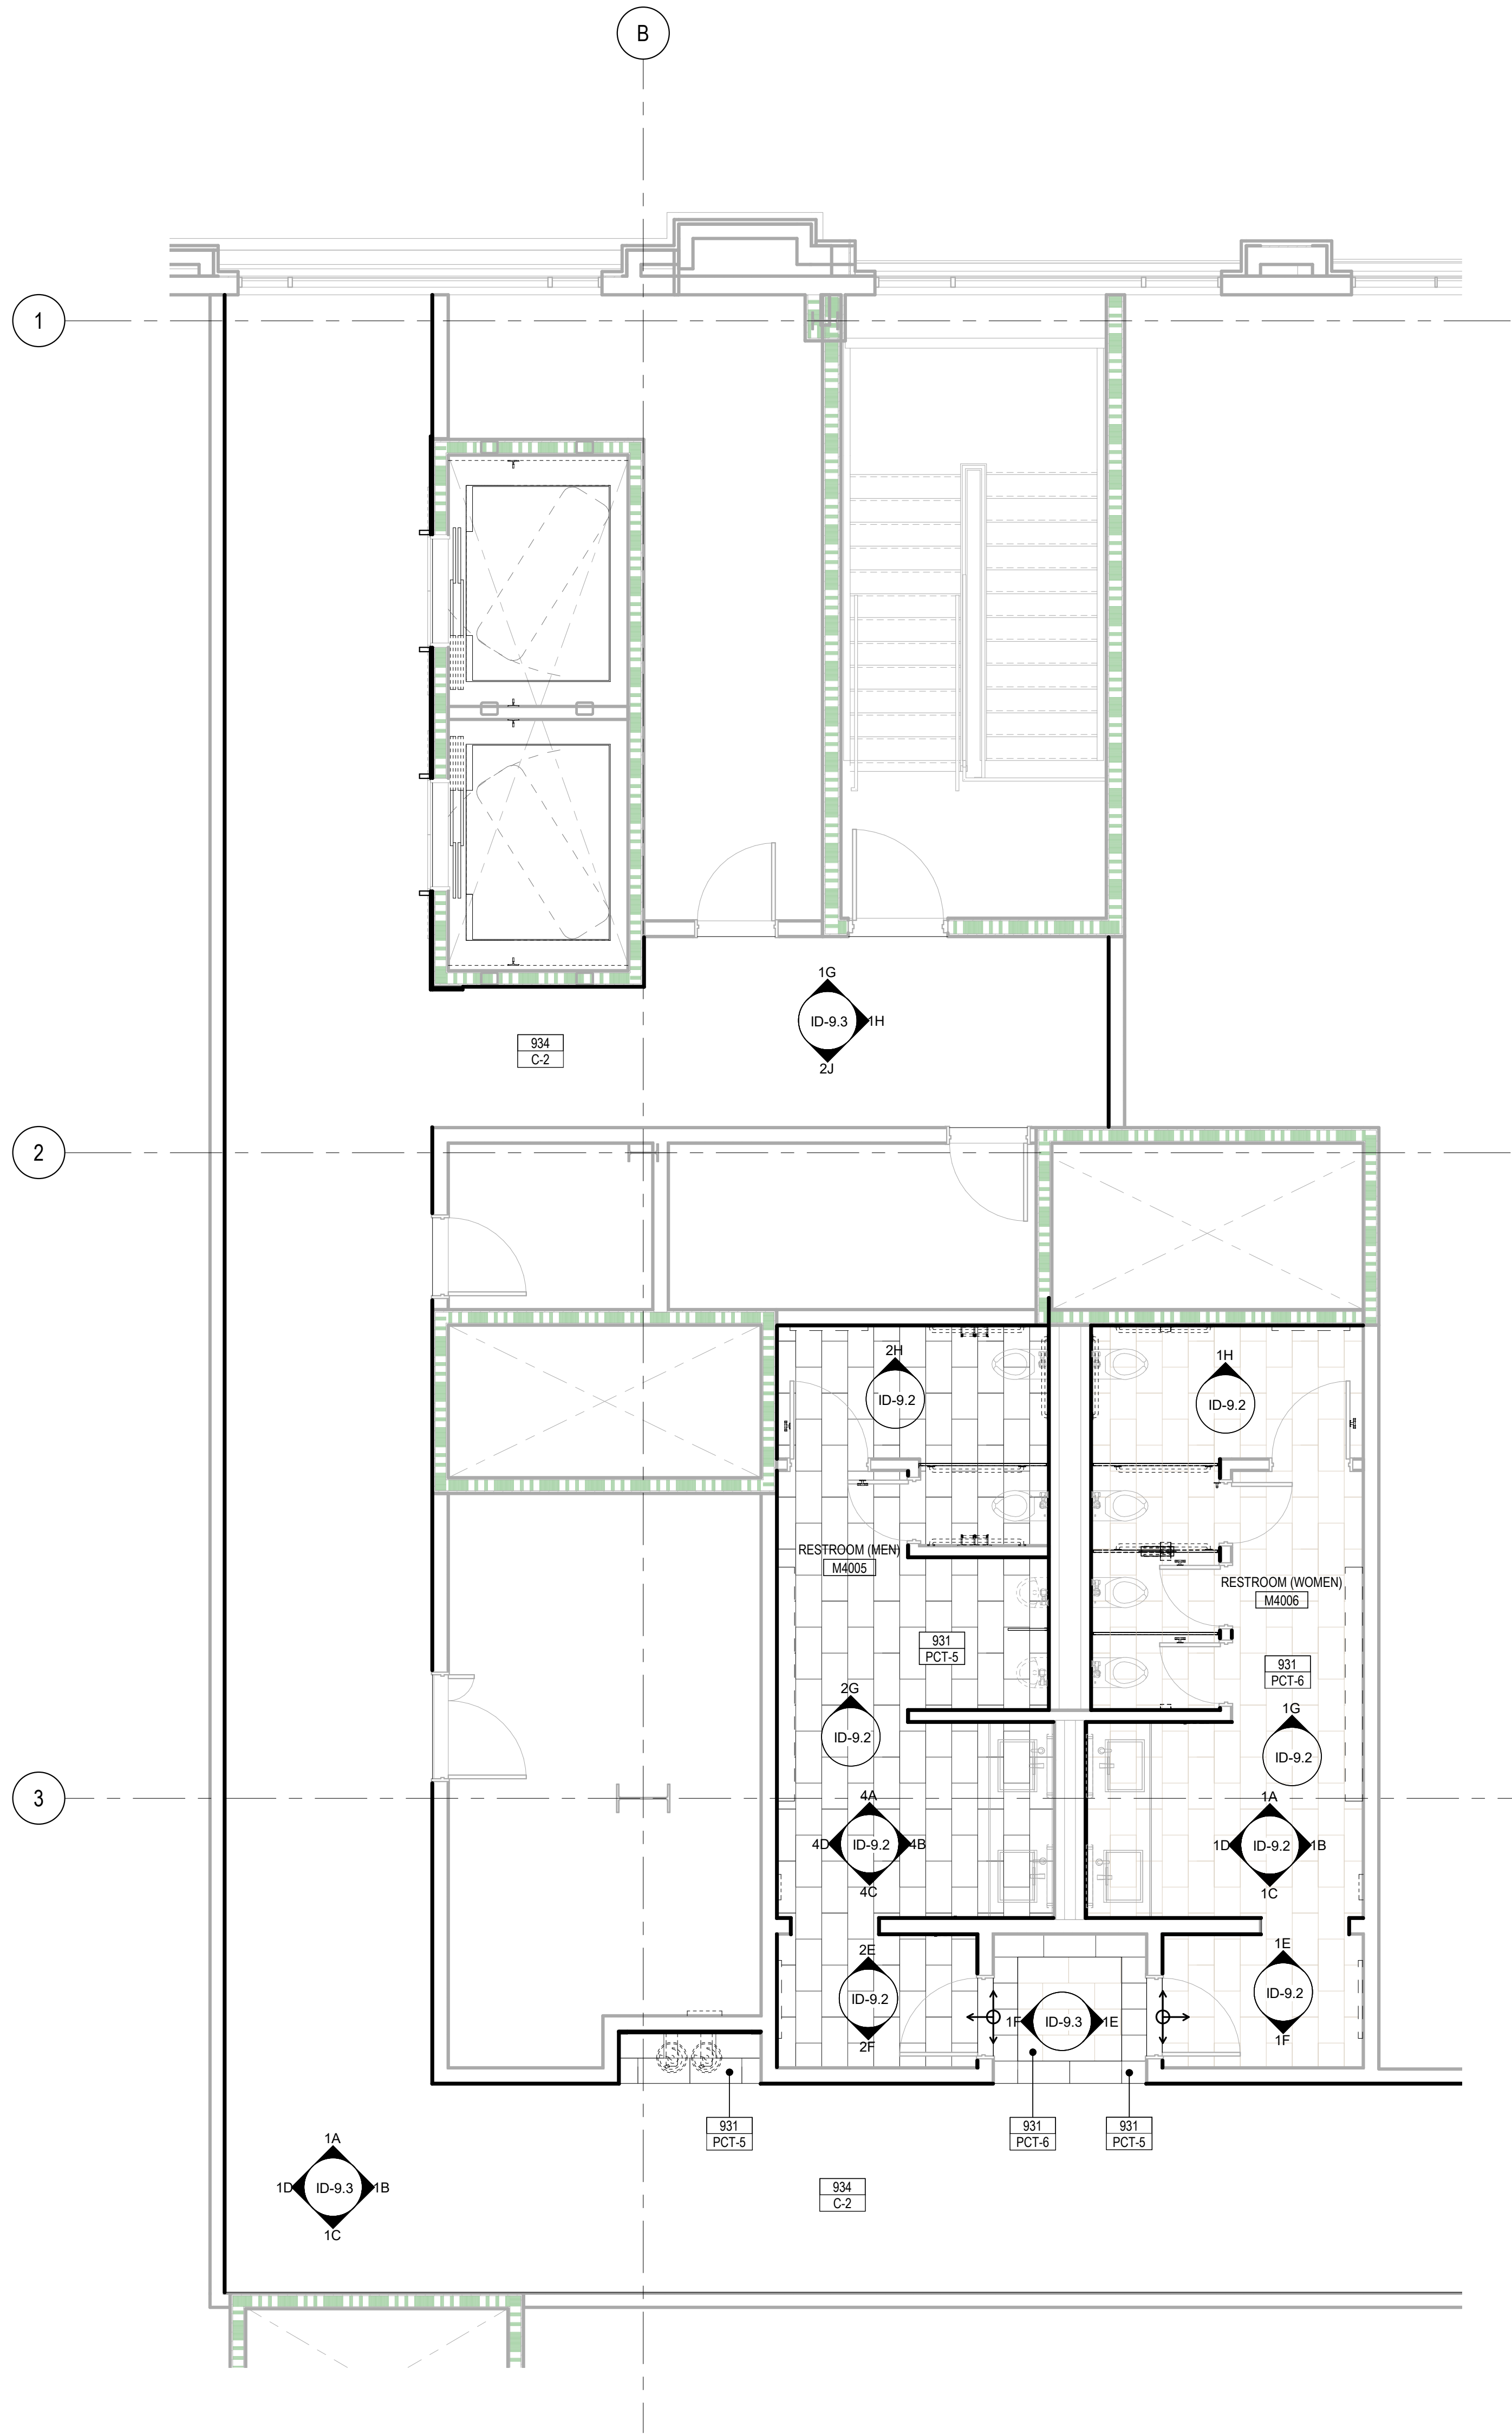

ENLARGED RESTROOM FINISH PLAN - LEVEL 4

Scale: 1/4" = 1'-0"

2

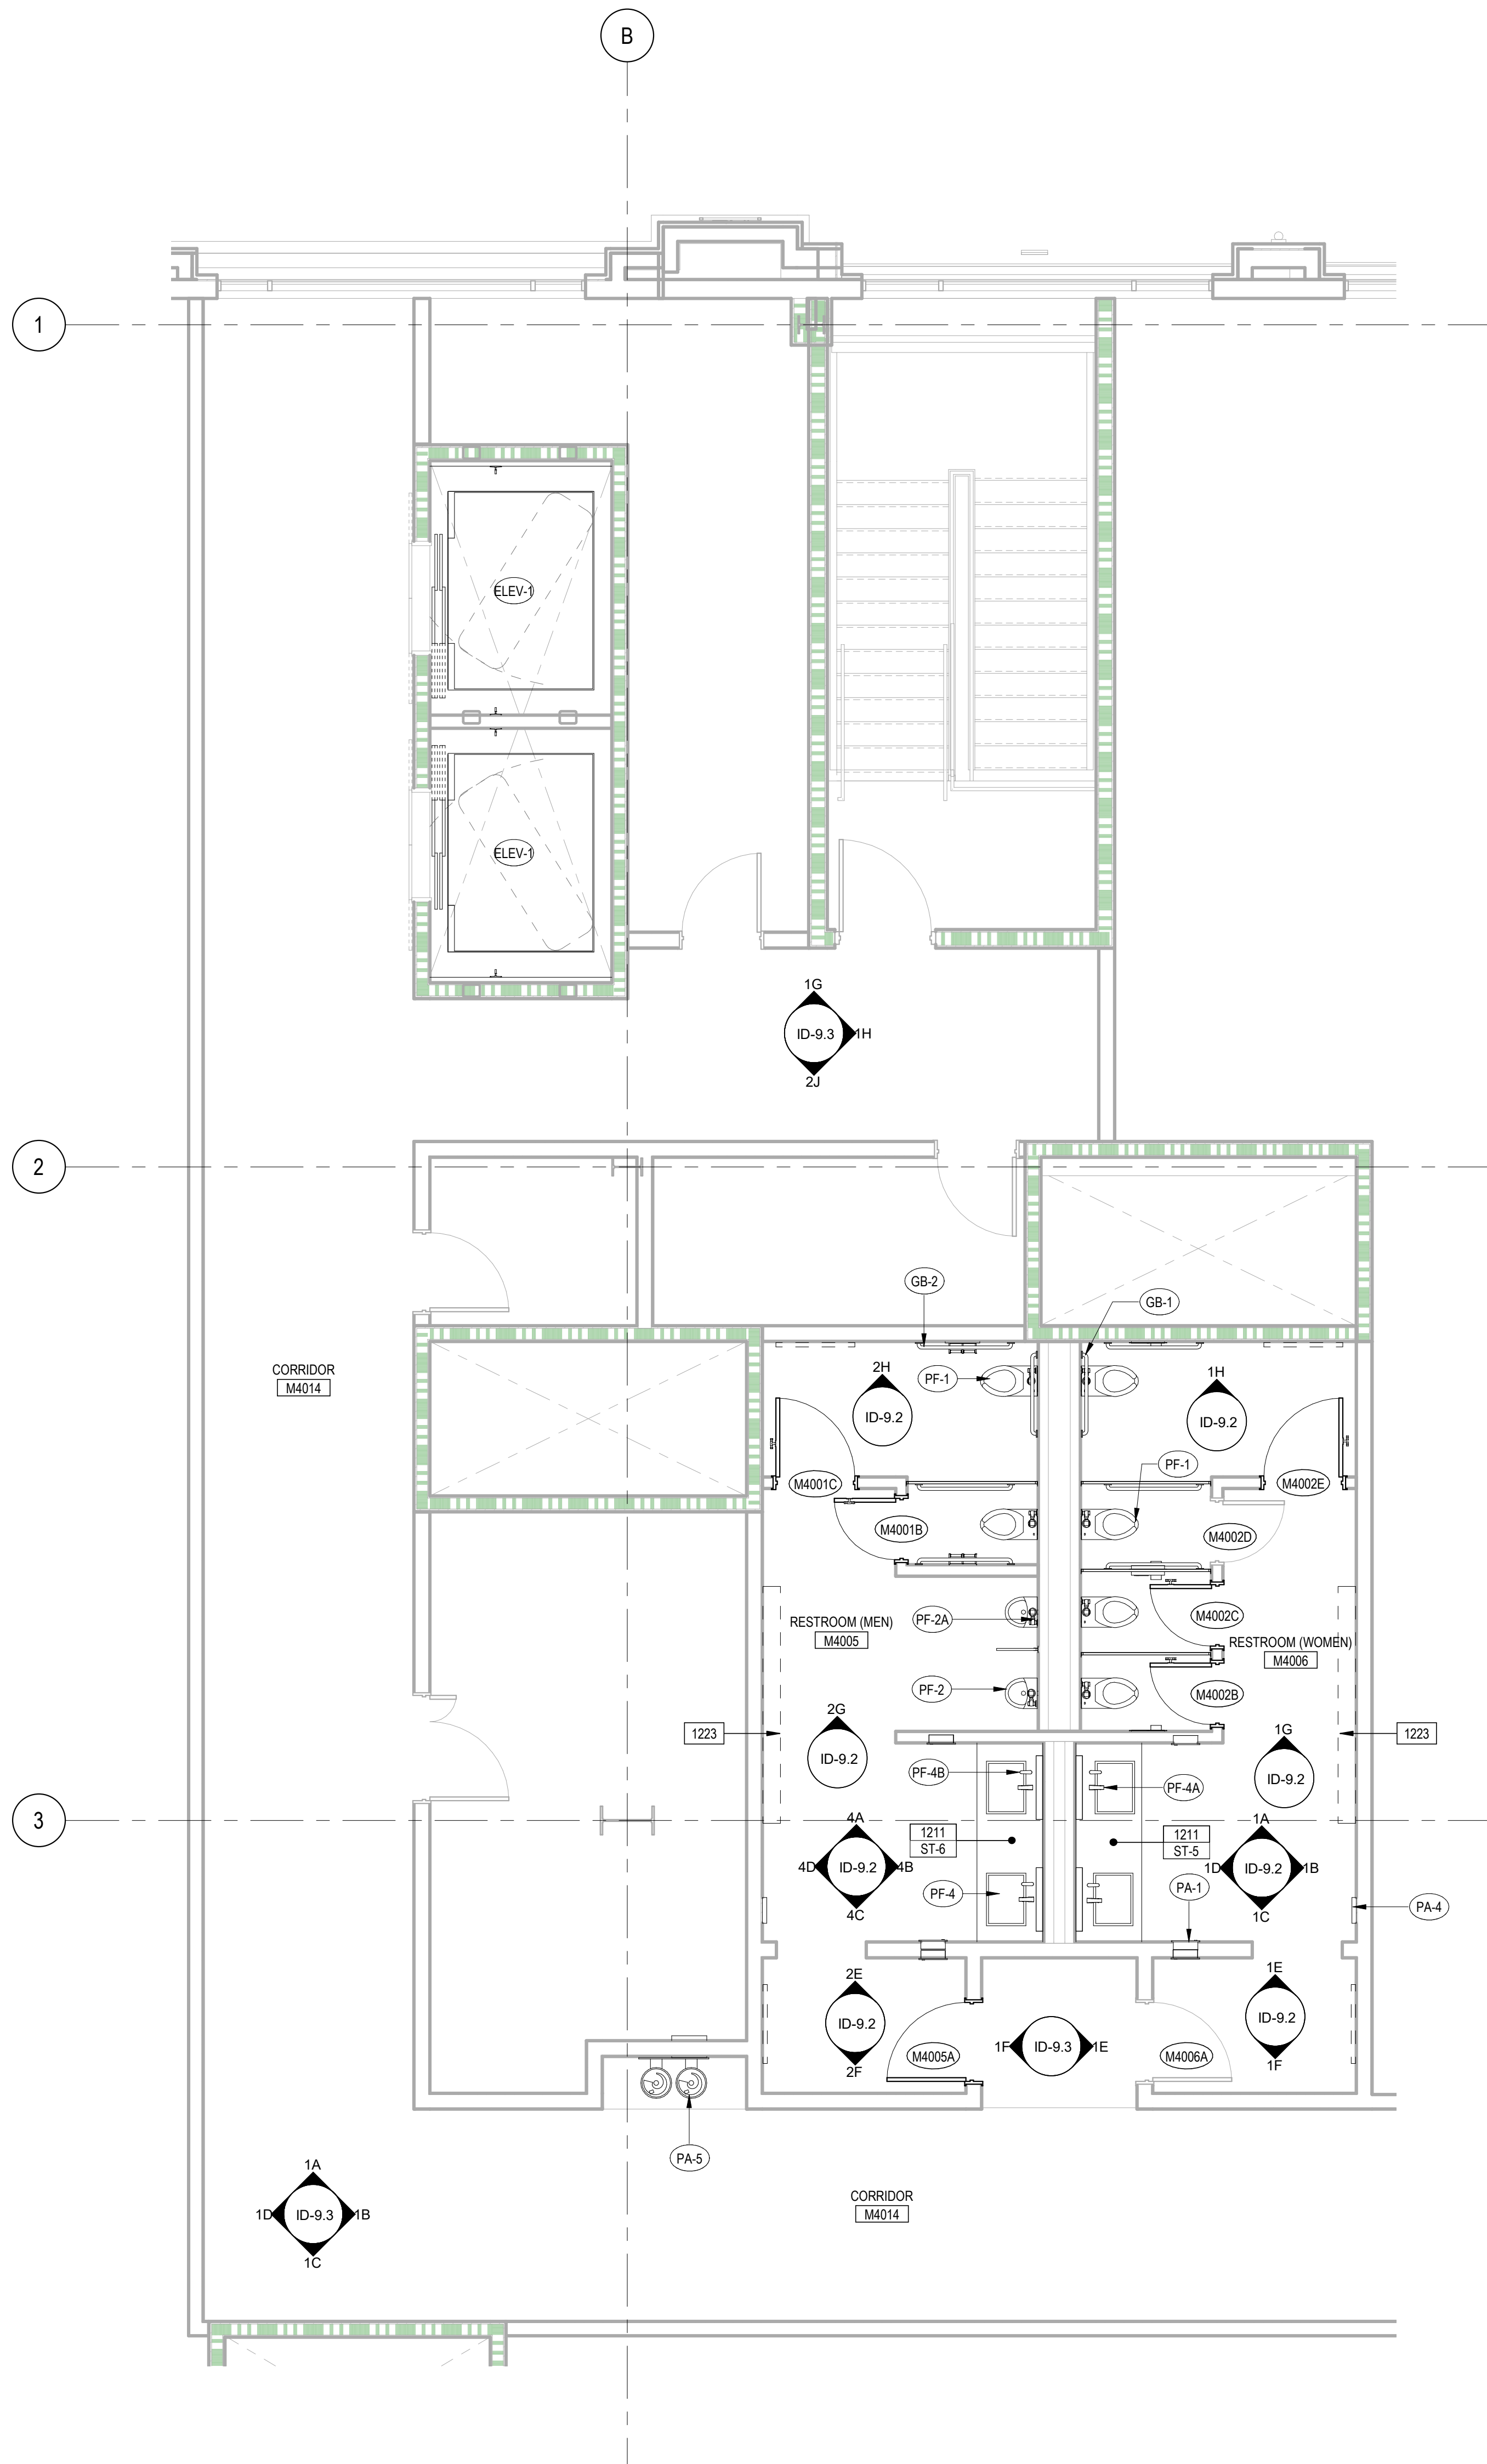

ENLARGED RESTROOM FURNISHING PLAN - LEVEL 4

Scale: 1/4" = 1'-0"

1

KEYNOTES

- 931 FLOOR TILE
934 CARPET
1211 STONE COUNTERTOP WITH 6" HIGH BACKSPLASH
1223 AMENITY CABINET

FIXTURE & FURNISHING SYMBOL LEGEND


---> FIXTURE AND FURNISHING REFERENCE

FINISH PLAN SYMBOL LEGEND

- NON-RATED WALLS (SHELL SCOPE)
1 HR FIRE RATED WALLS (SHELL SCOPE)
2 HR FIRE RATED WALLS (SHELL SCOPE)

FINISH START SYMBOL

- > KEYNOTE REFERENCE
---> KEYNOTE REFERENCE
---> COLOR & FINISH REFERENCE

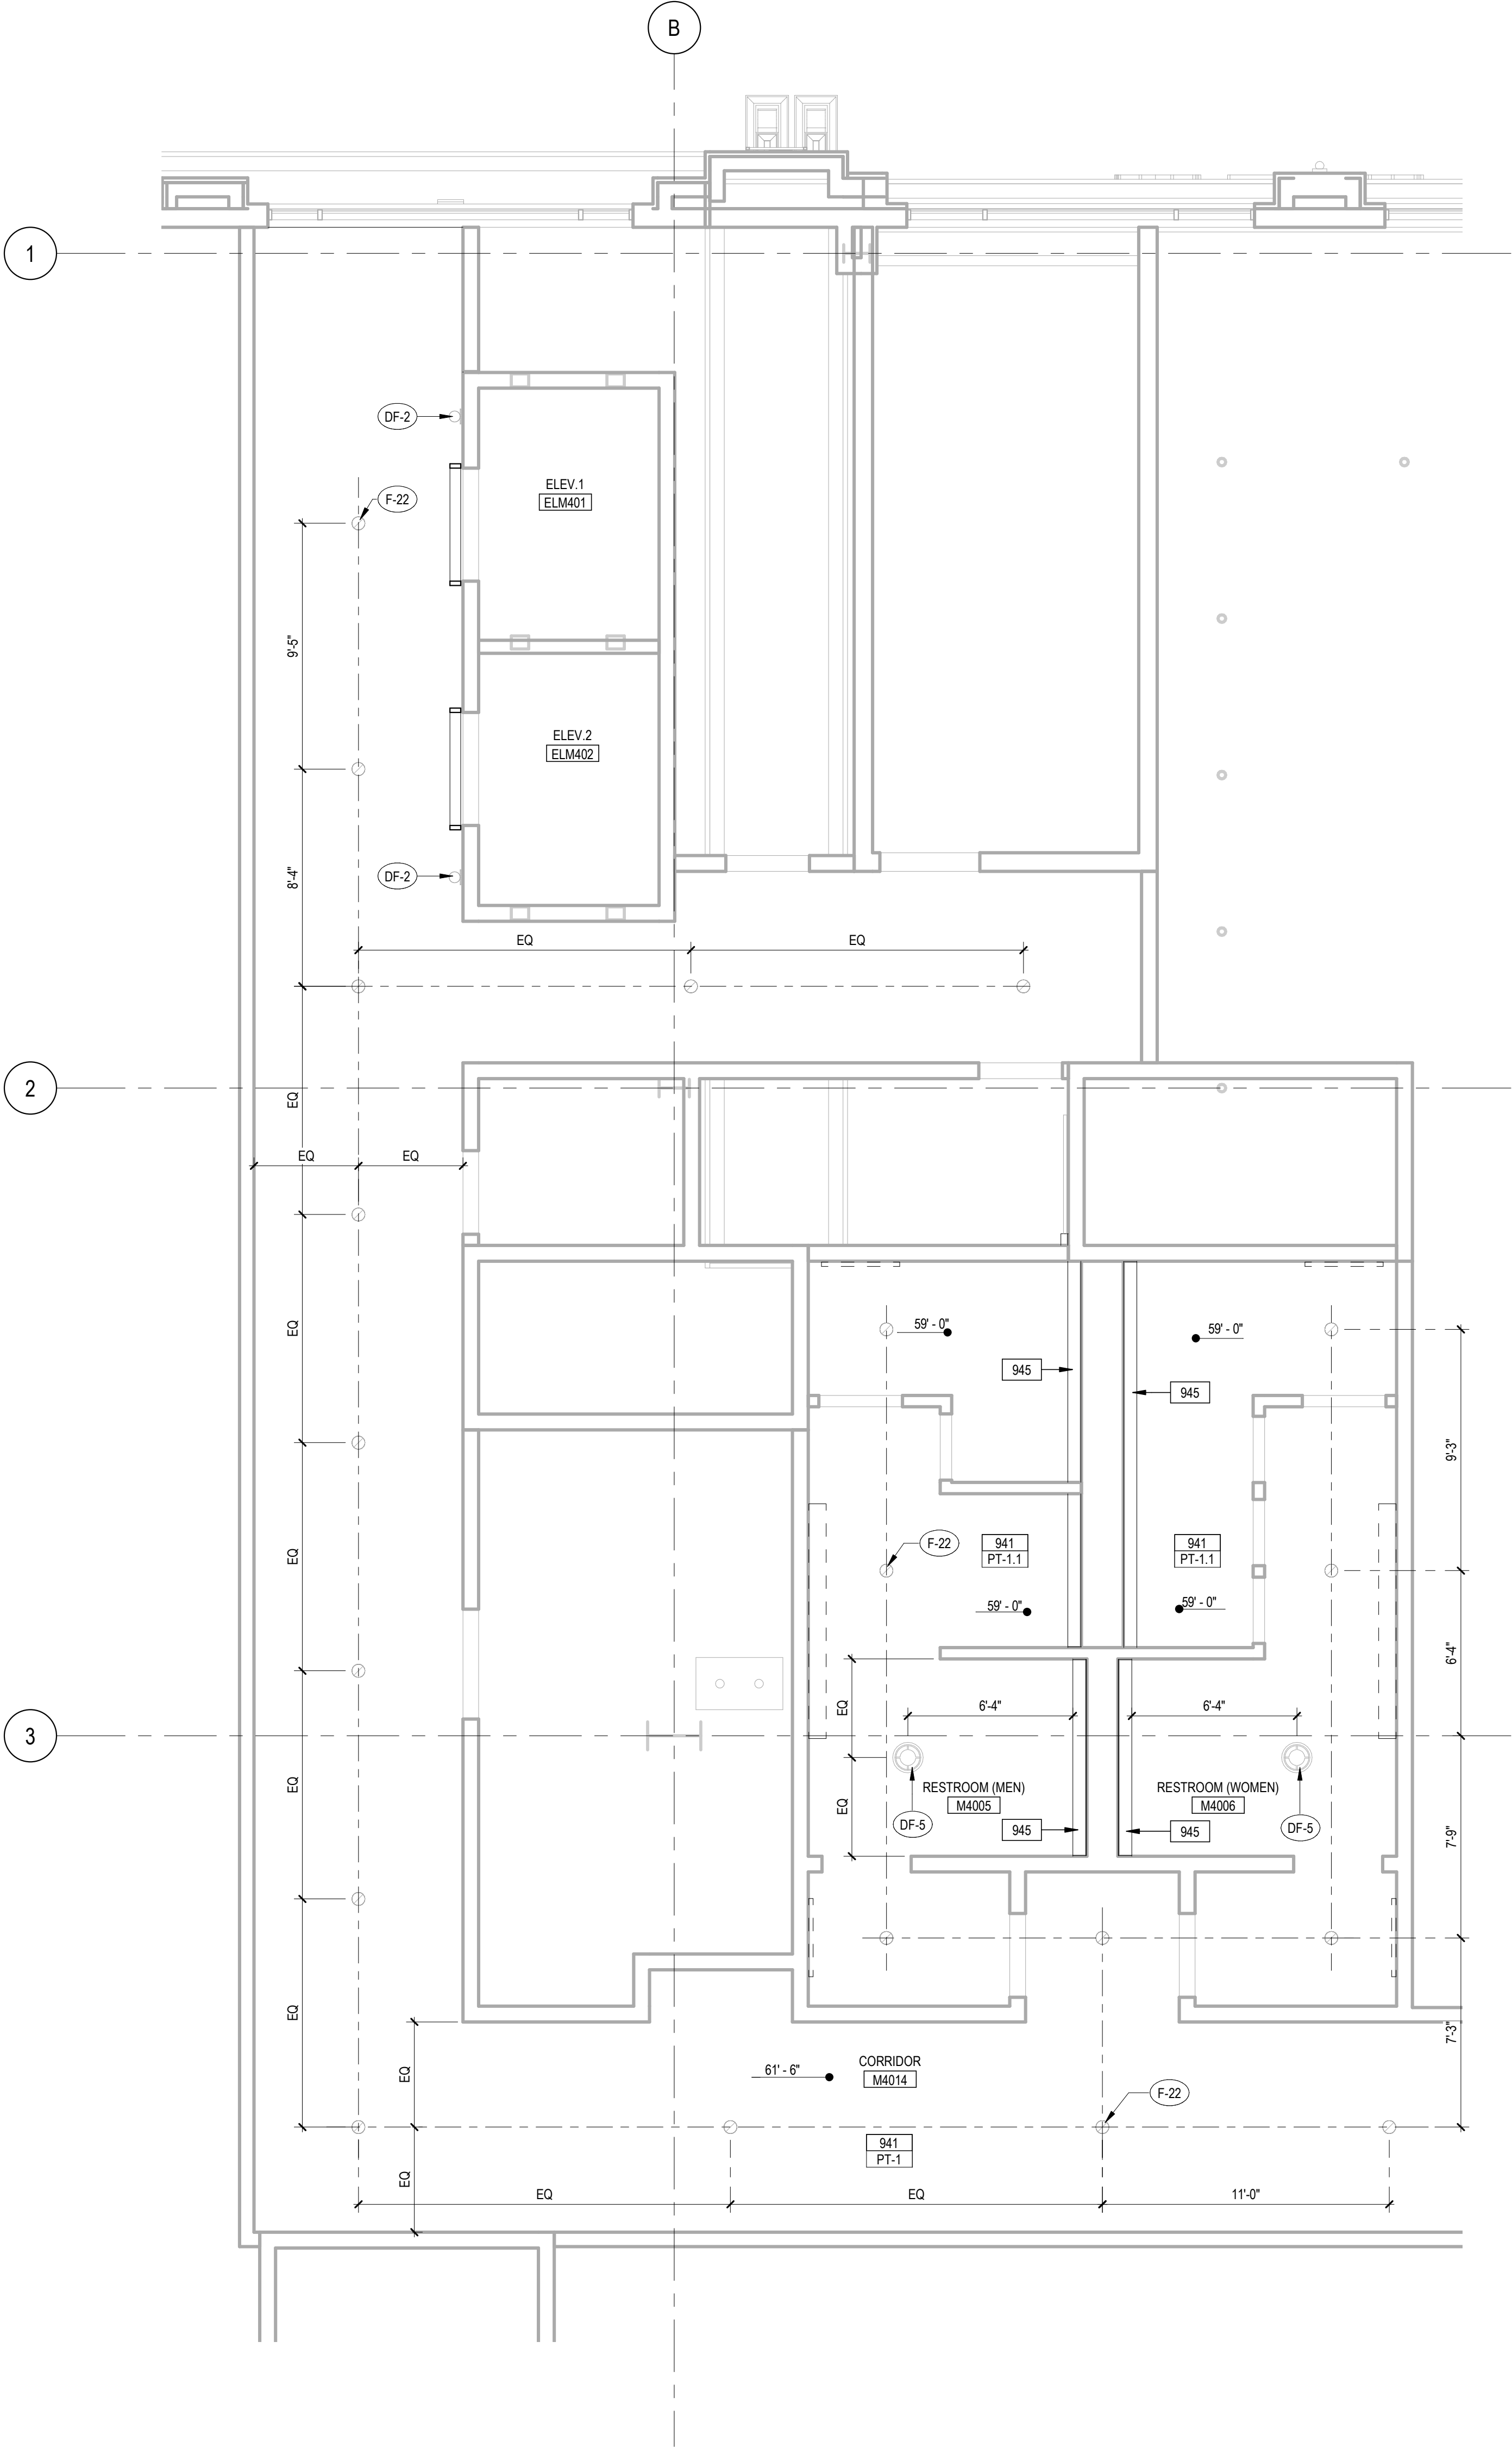

ENLARGED REFLECTED CEILING PLAN RESTROOM- LEVEL 4

Scale:
1/4" = 1'-0"



1

RCP SYMBOL LEGEND

- ① ELECTRICAL J-BOX, SEE ELECTRICAL PLANS
- COVE LIGHTING
- WALL MOUNTED SCONCE LIGHT FIXTURE
- WALL MOUNTED SCONCE LIGHT FIXTURE
- RECESSED LIGHT FIXTURE
- 1 KEYNOTE
- A COLOR AND FINISH

KEYNOTES


- 941 PAINTED CEILING
- 945 CEILING LIGHT COVE. PAINT TO MATCH ADJ. SURFACE OR OTHERWISE INDICATED



ELEVATION SYMBOL LEGEND

Diagram illustrating the four types of callouts:

- KEYNOTE REFERENCE (two #s)
- KEYNOTE REFERENCE (three #s)
- COLOR & FINISH REFERENCE (XX-#)
- FIXTURE AND FURNISHING REFERENCE (# in a circle)

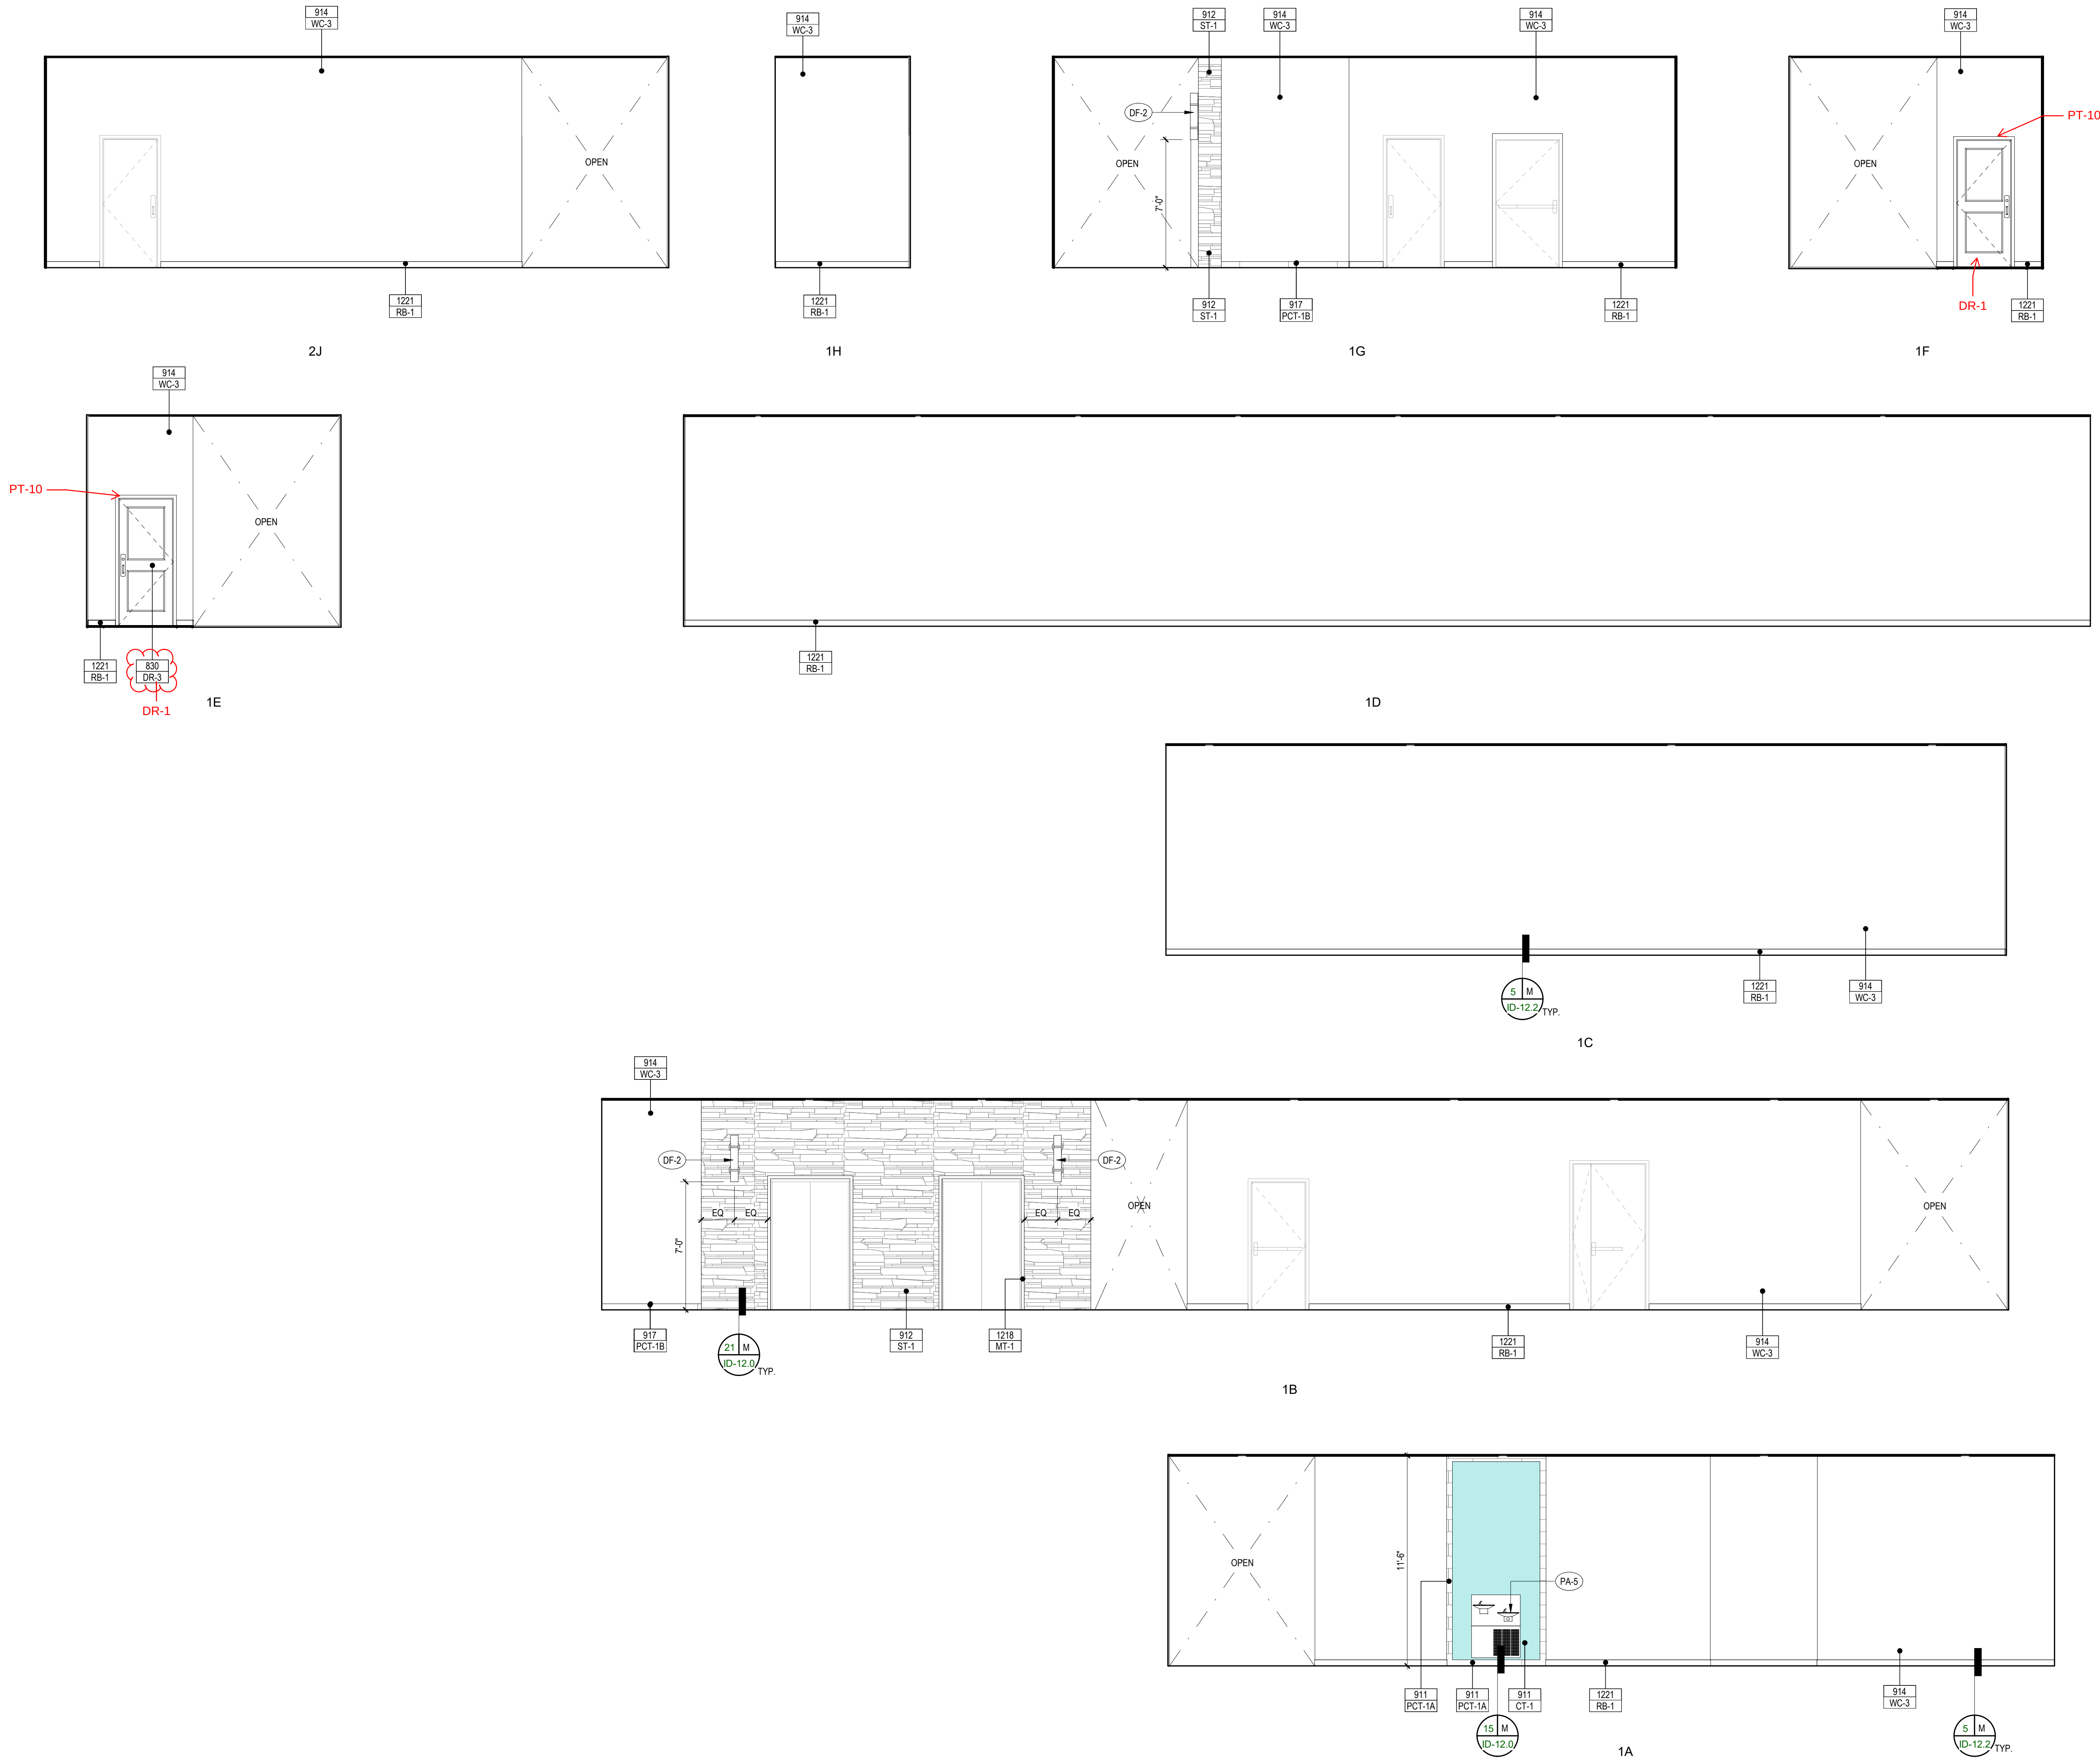

CORRIDOR ELEVATIONS - HALLWAY M4014

Scale:
1/4"

1

KEYNOTES

- 830 DOOR PER PLAN AND DOOR SCHEDULE
911 PORCELAIN TILE
912 STONE
914 WALLCOVERING
917 4" TILE WALL BASE
1218 METAL FRAME
1221 RUBBER BASE

ELEVATION SYMBOL LEGEND

- ### KEYNOTE REFERENCE
KEYNOTE REFERENCE
XX-# COLOR & FINISH REFERENCE
FIXTURE AND FURNISHING REFERENCE

[illegible]

LIGHT FIXTURE SCHEDULE



5



4



3




2


NOTE:
REFER TO DESIGN MATERIALS & FFE SPECIFICATIONS
PACKAGE FOR COMPLETE DOOR INFORMATION.

DOOR SCHEDULE




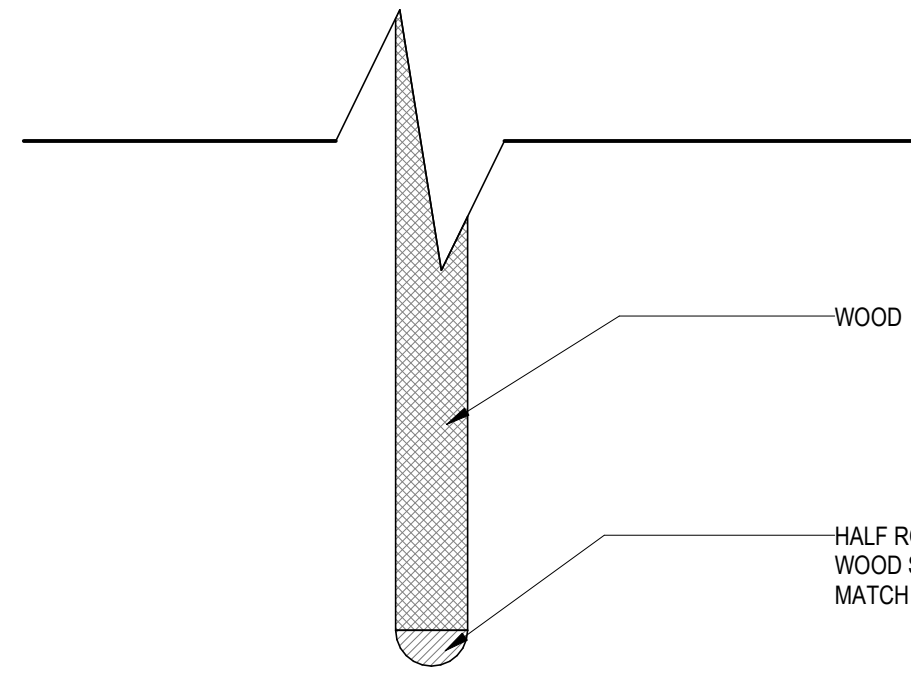


DETAIL Scale: 6" = 1'-0" 20

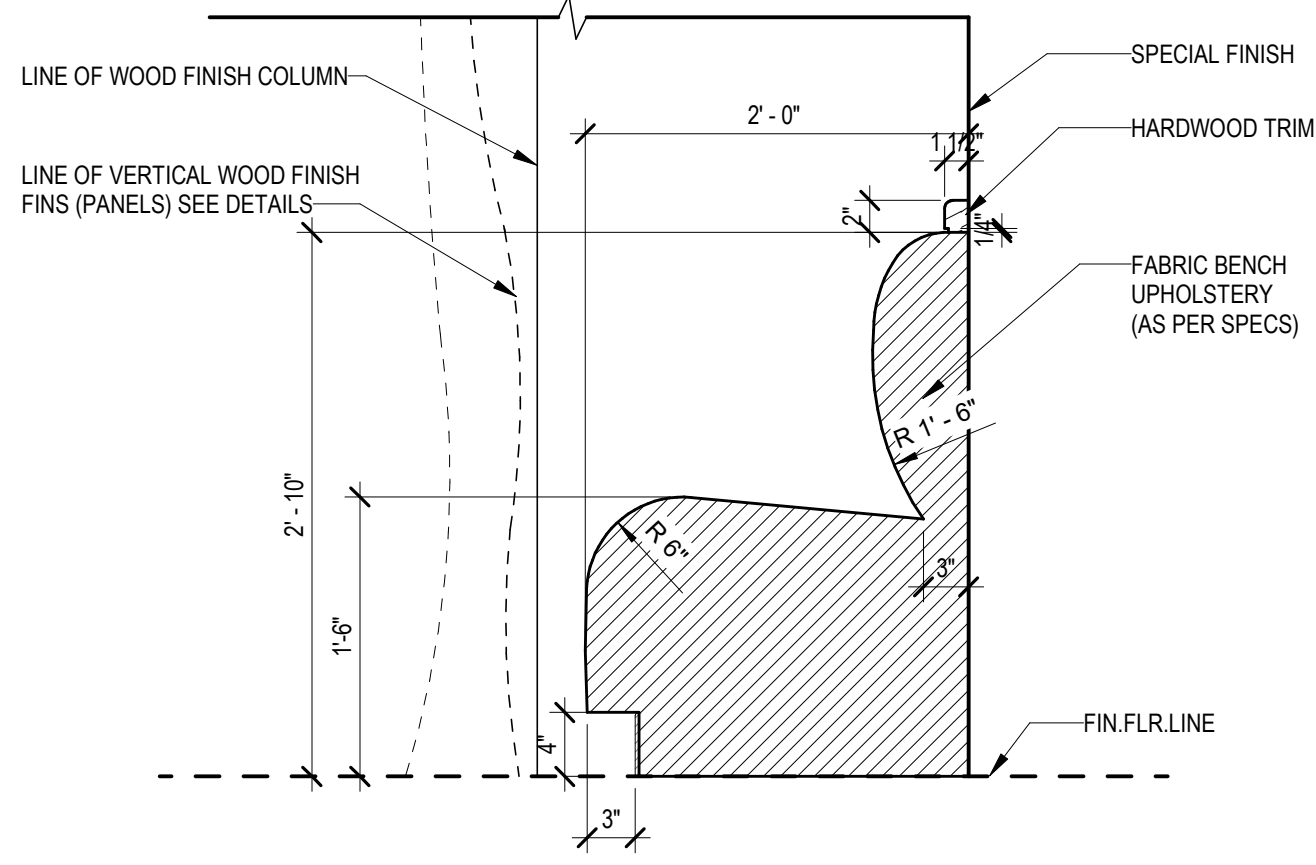


COUCH DETAIL - KIDS Scale: 1" = 1'-0" 15

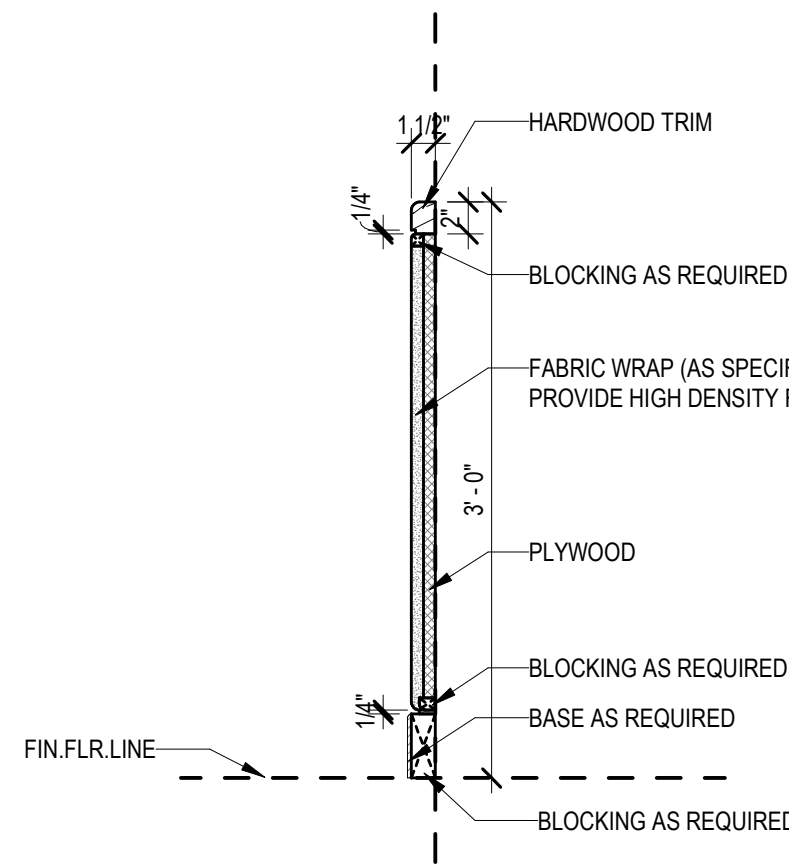


UPHOLSTERY AT WALL - KIDS Scale: 1" = 1'-0" 10

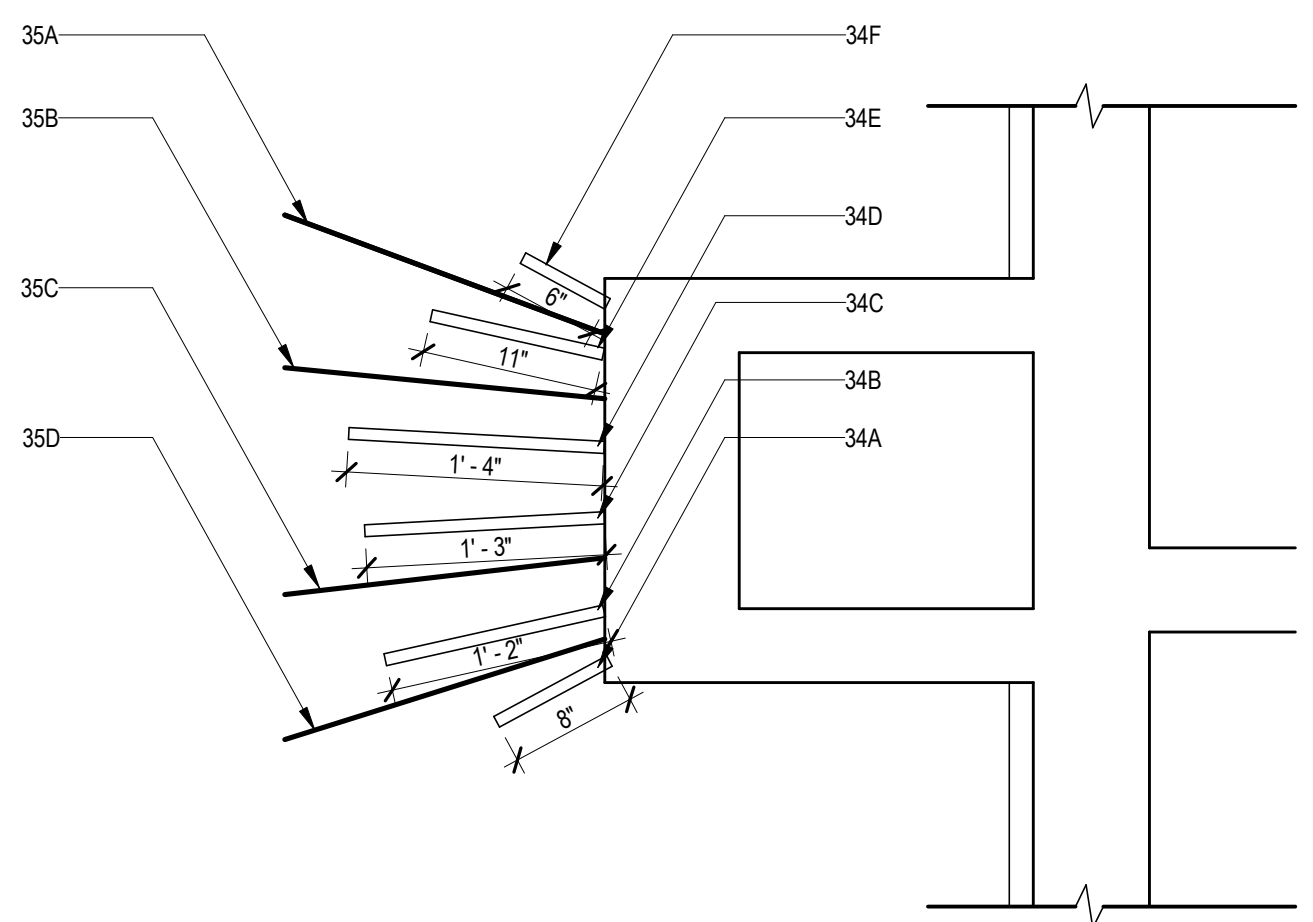


TREE DETAIL - KIDS Scale: 1" = 1'-0" 5

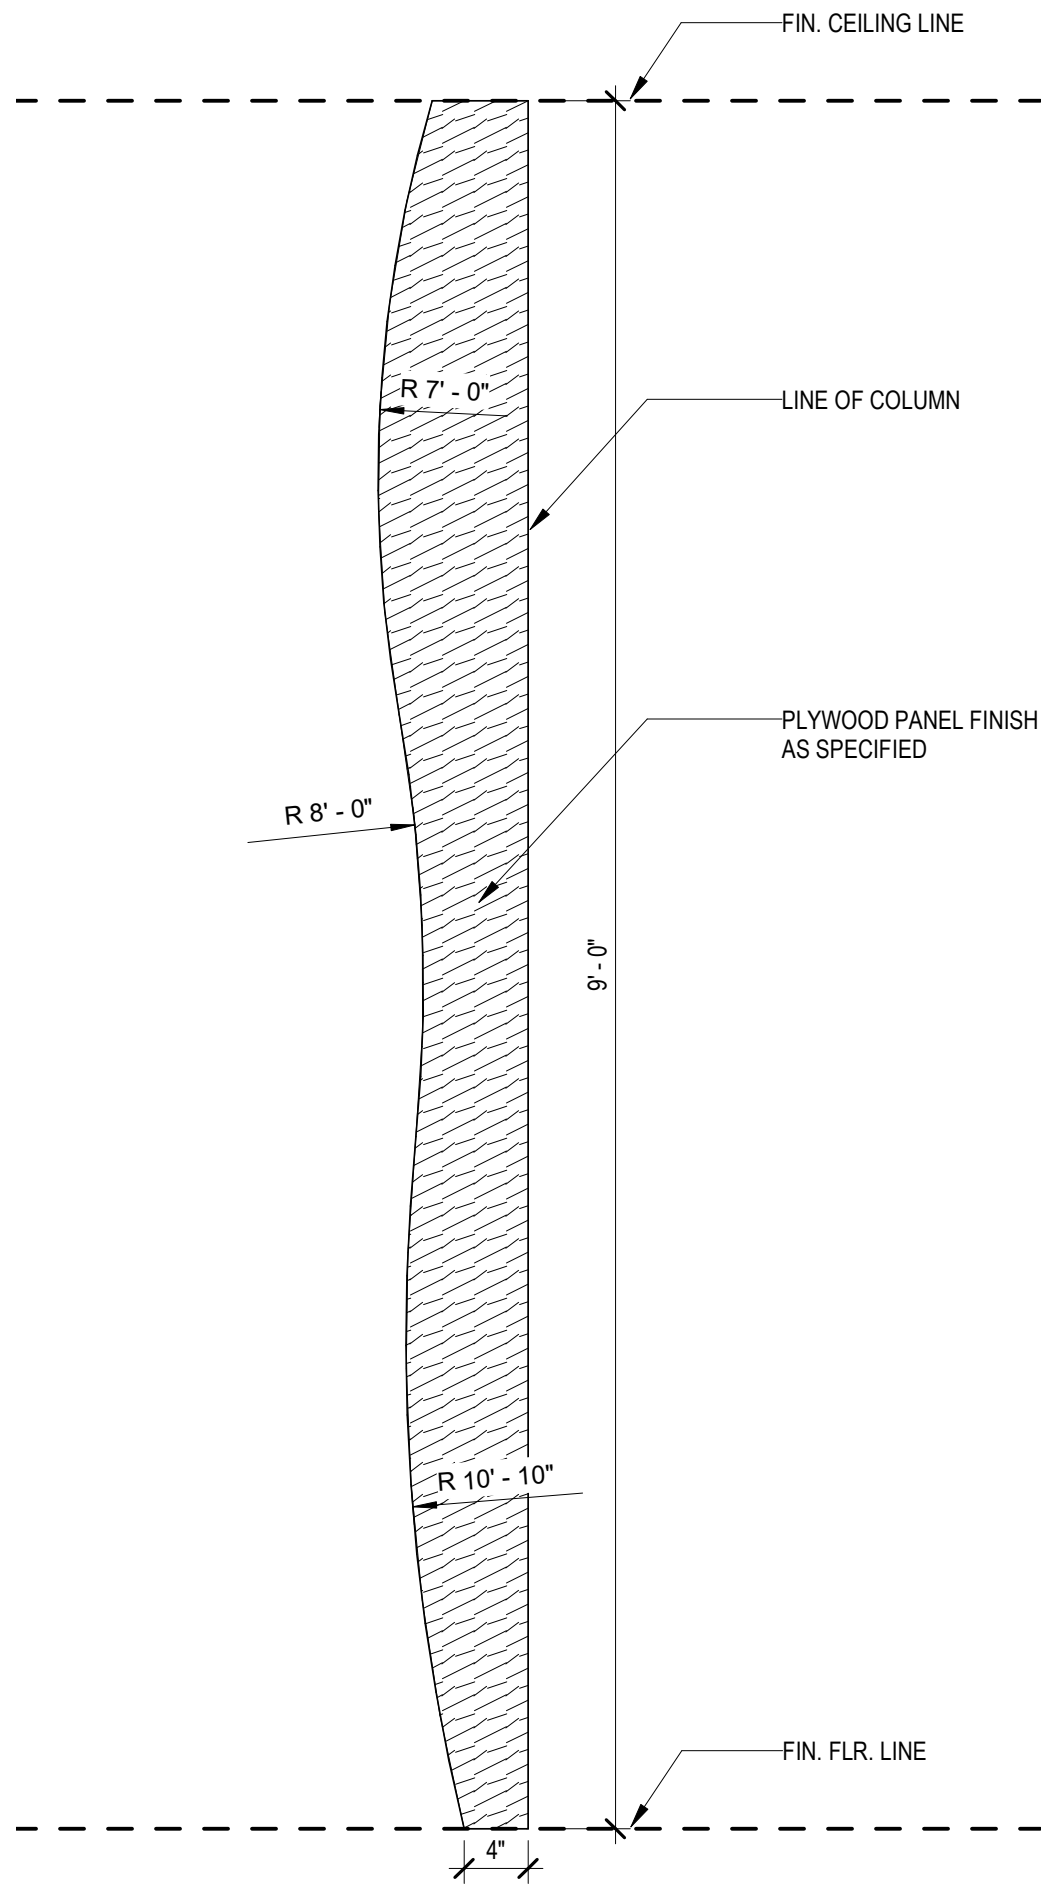


34F

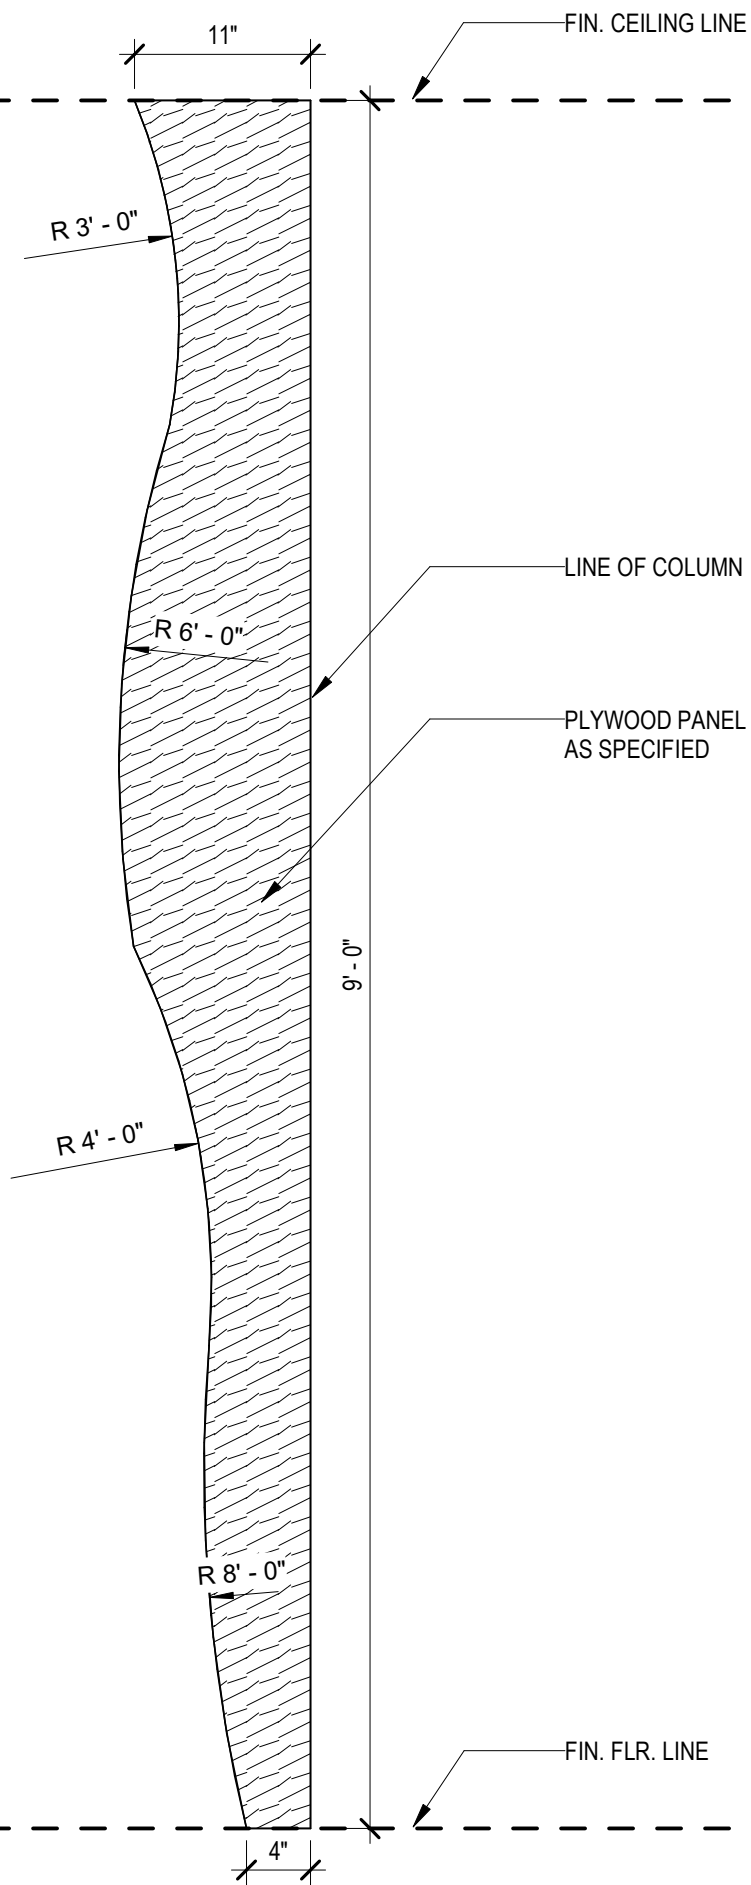


34E

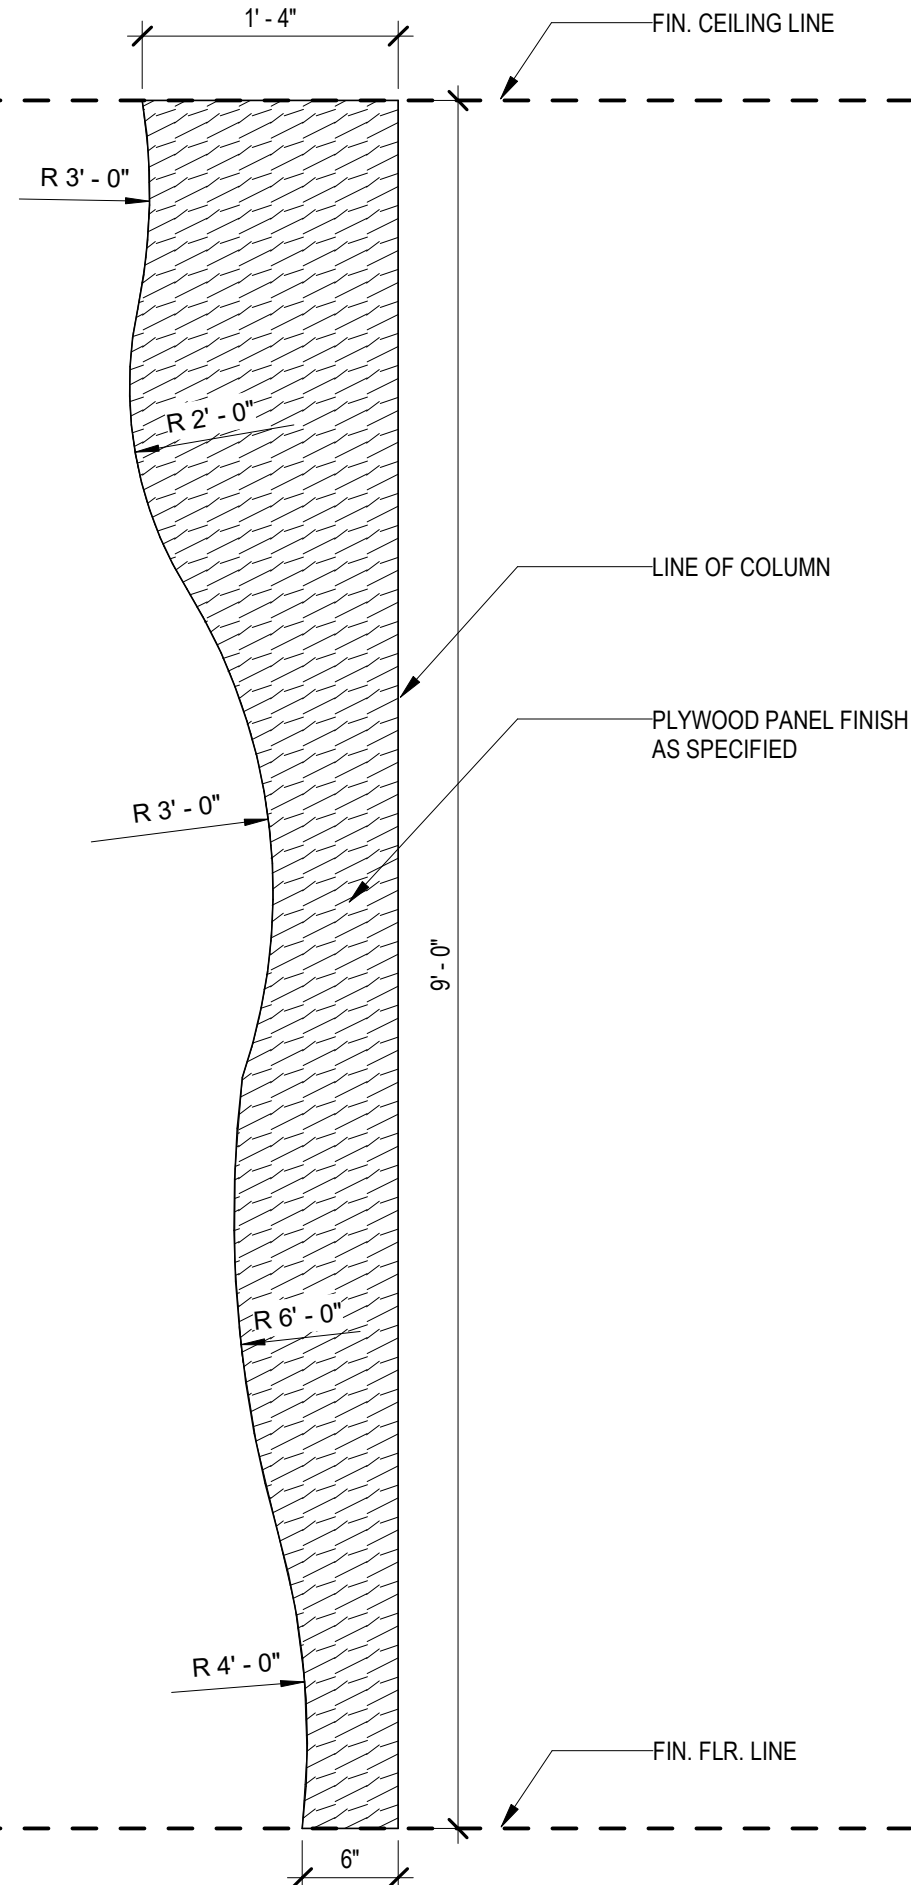


34D

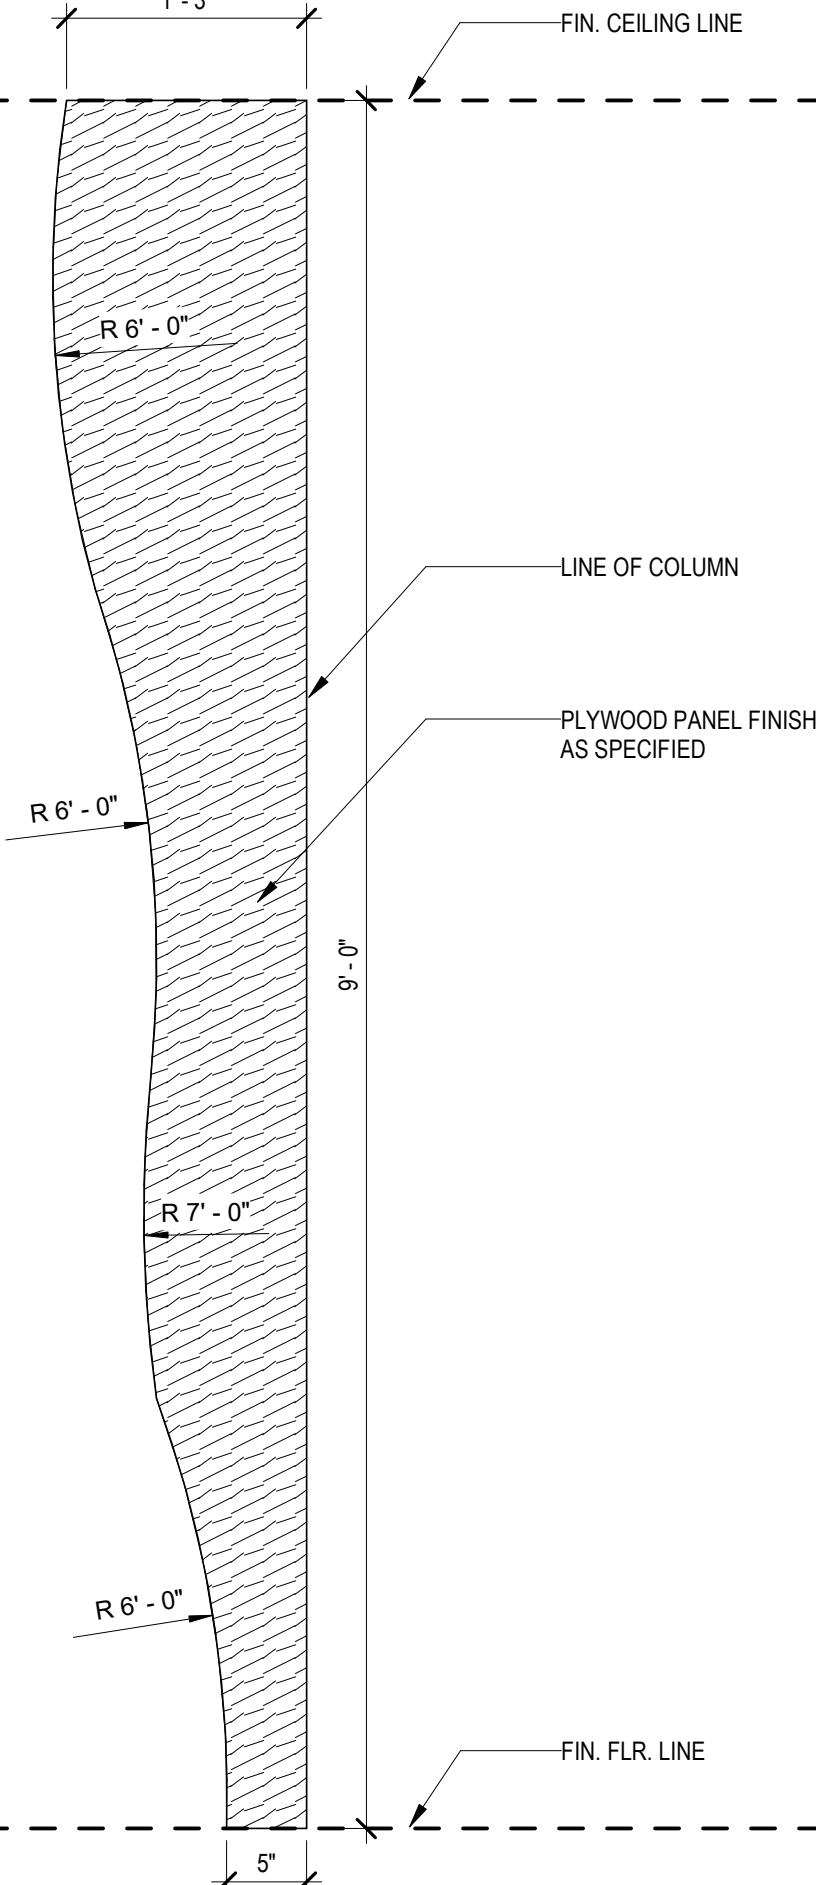

34C

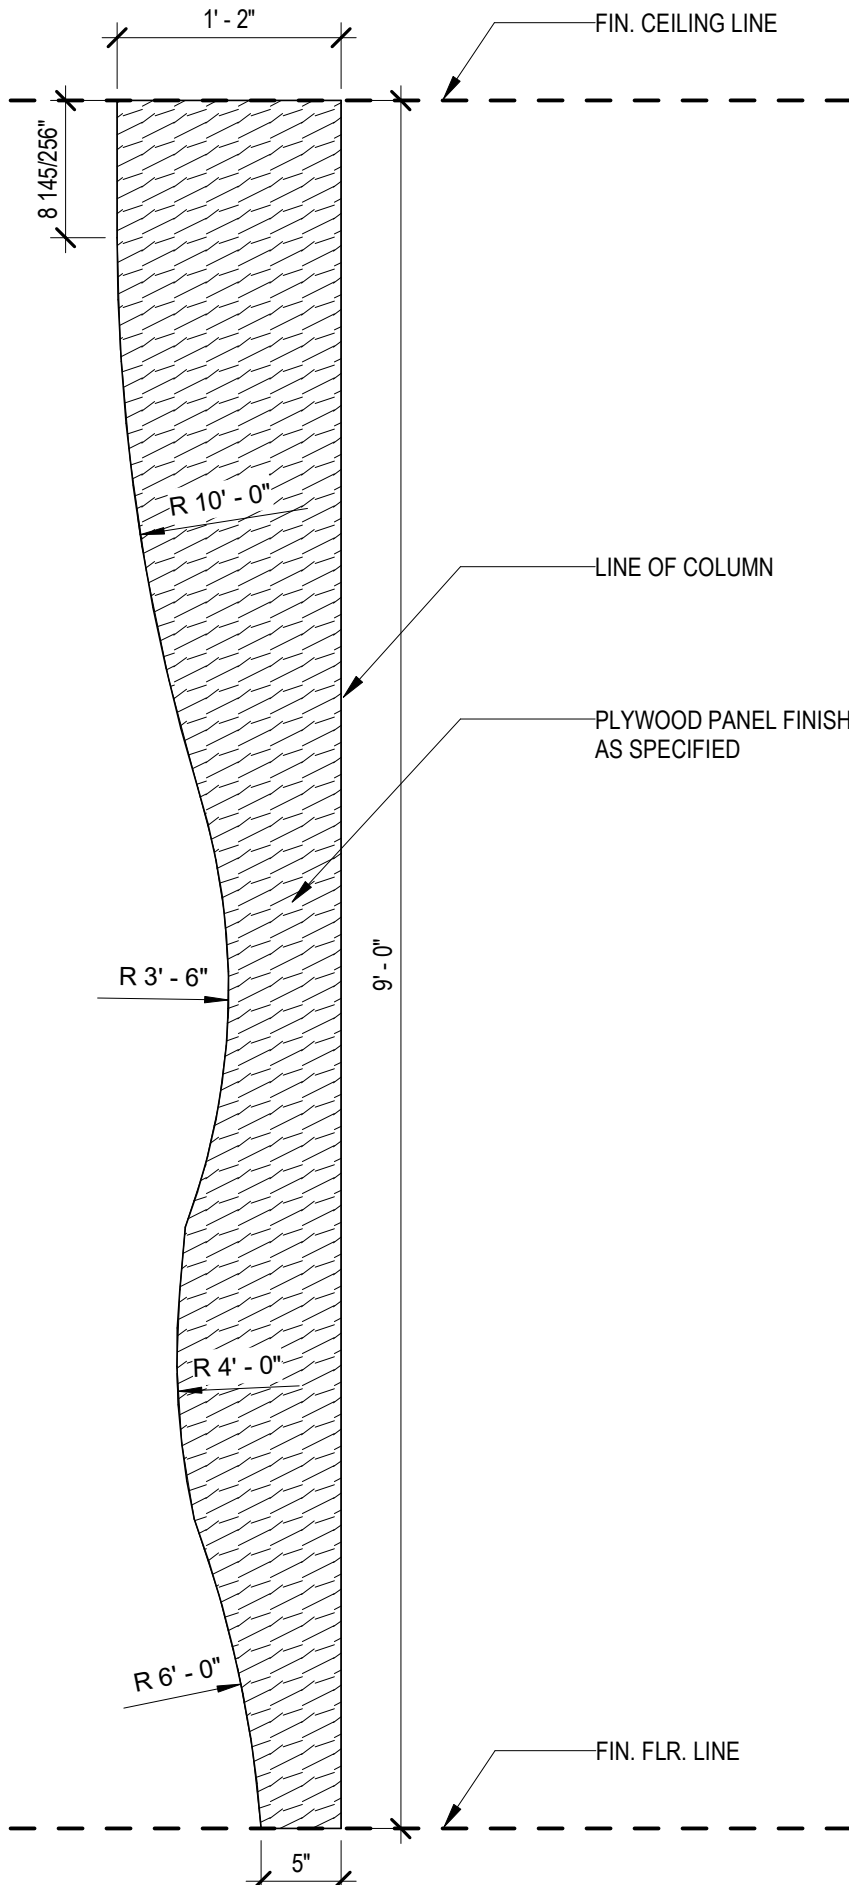


34B

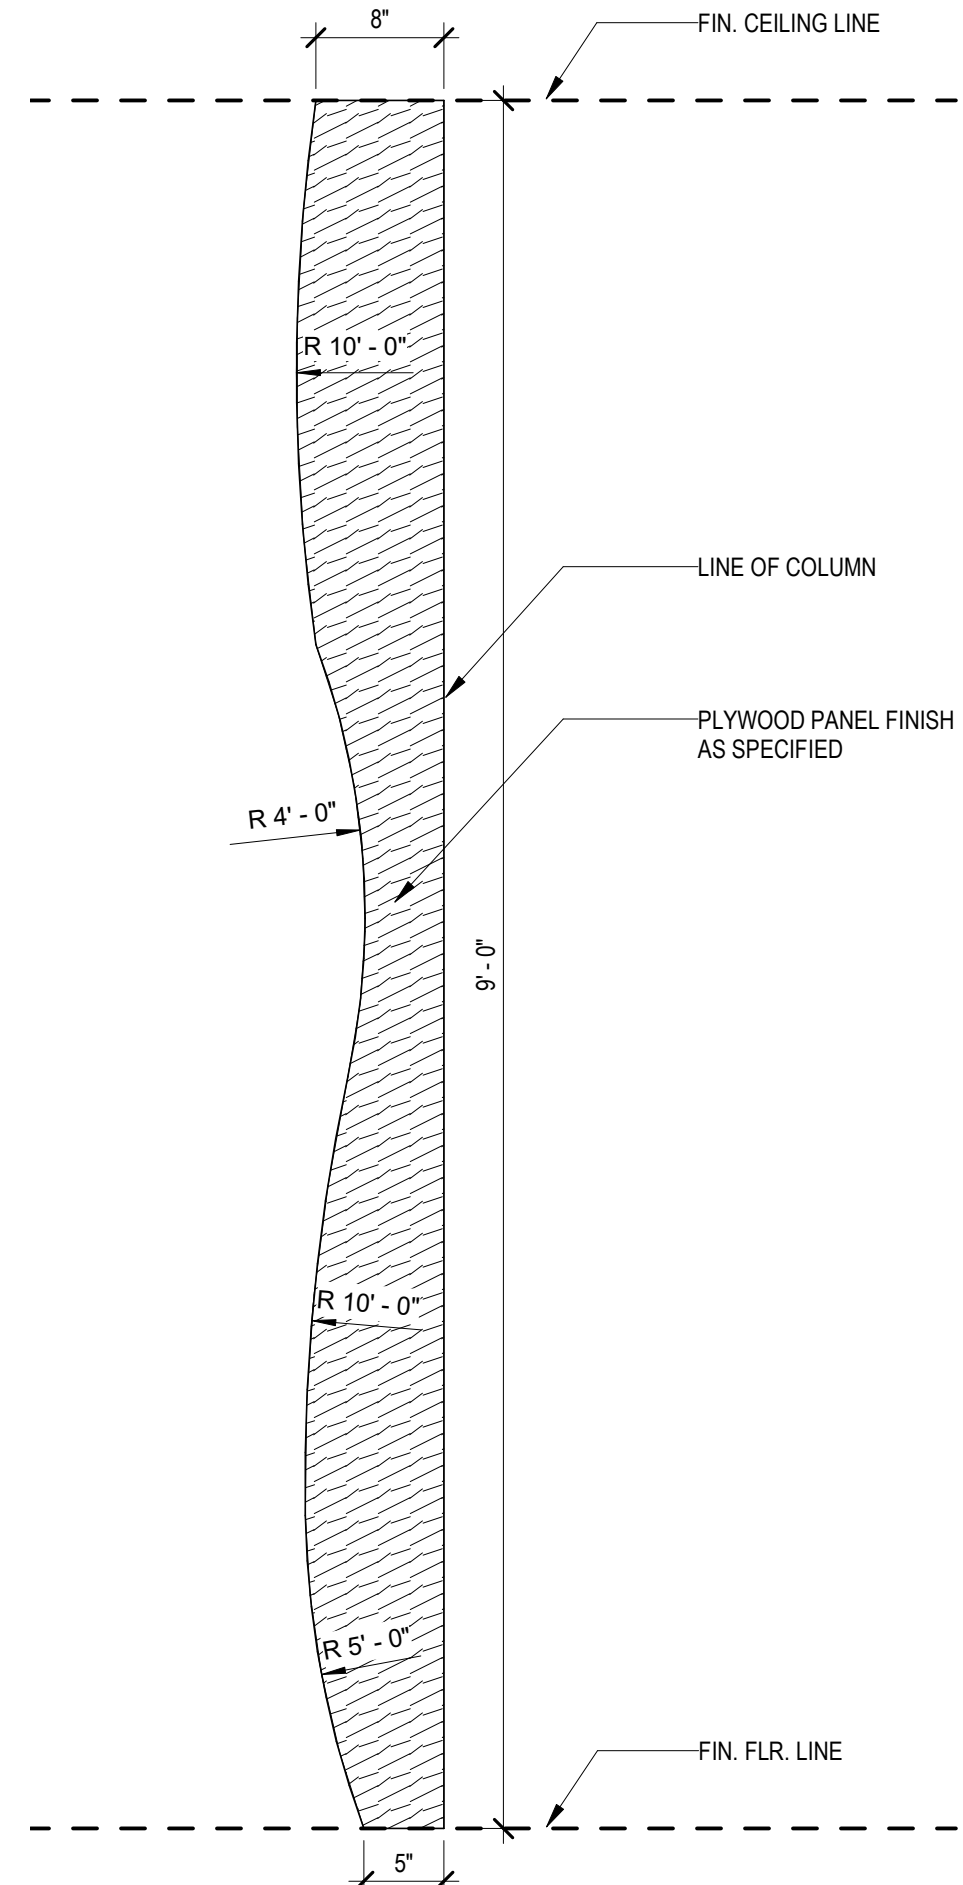


34A


TREE TRUNK PANELS Scale: 1" = 1'-0" 3

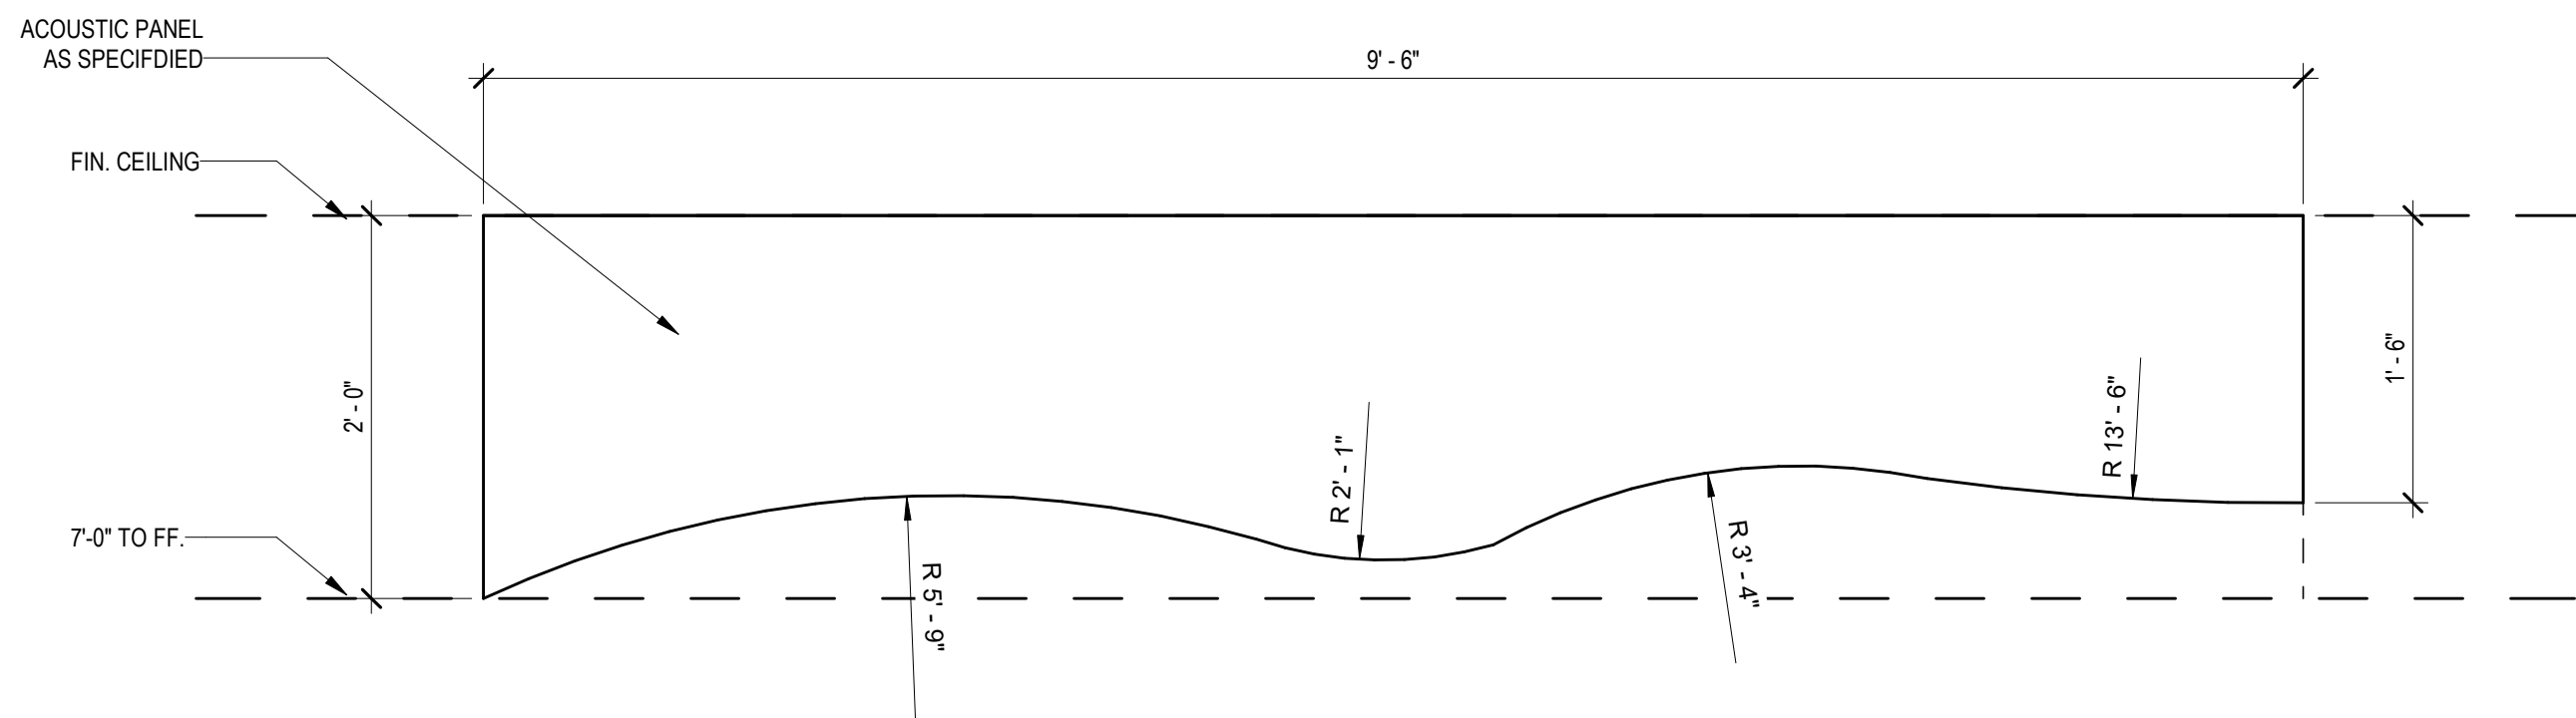


35A

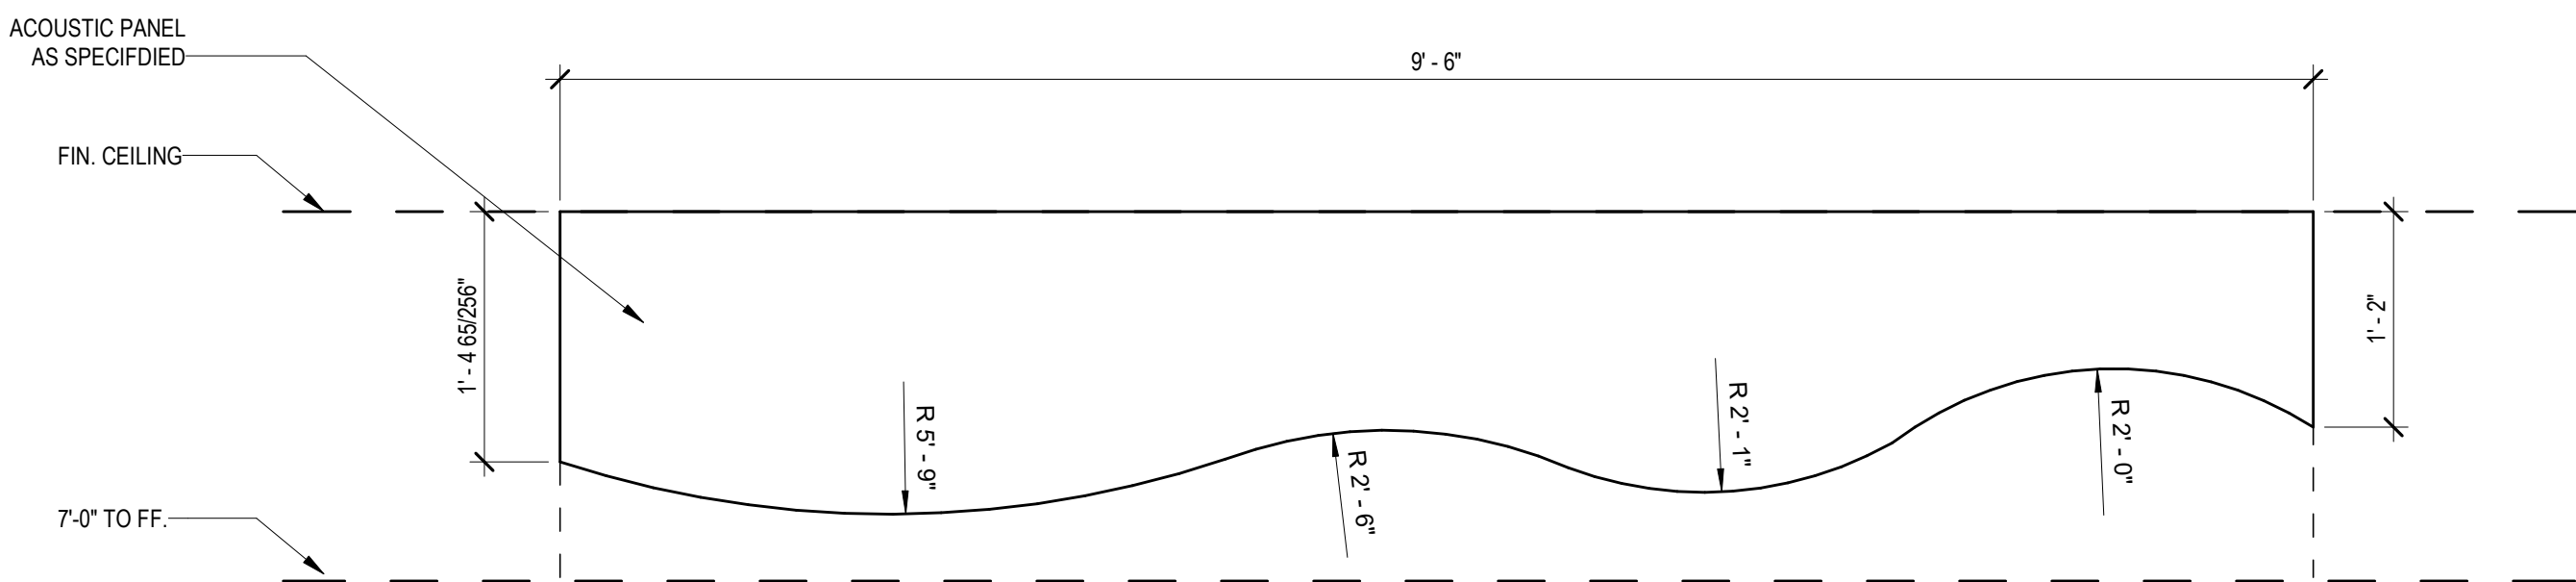

35B




















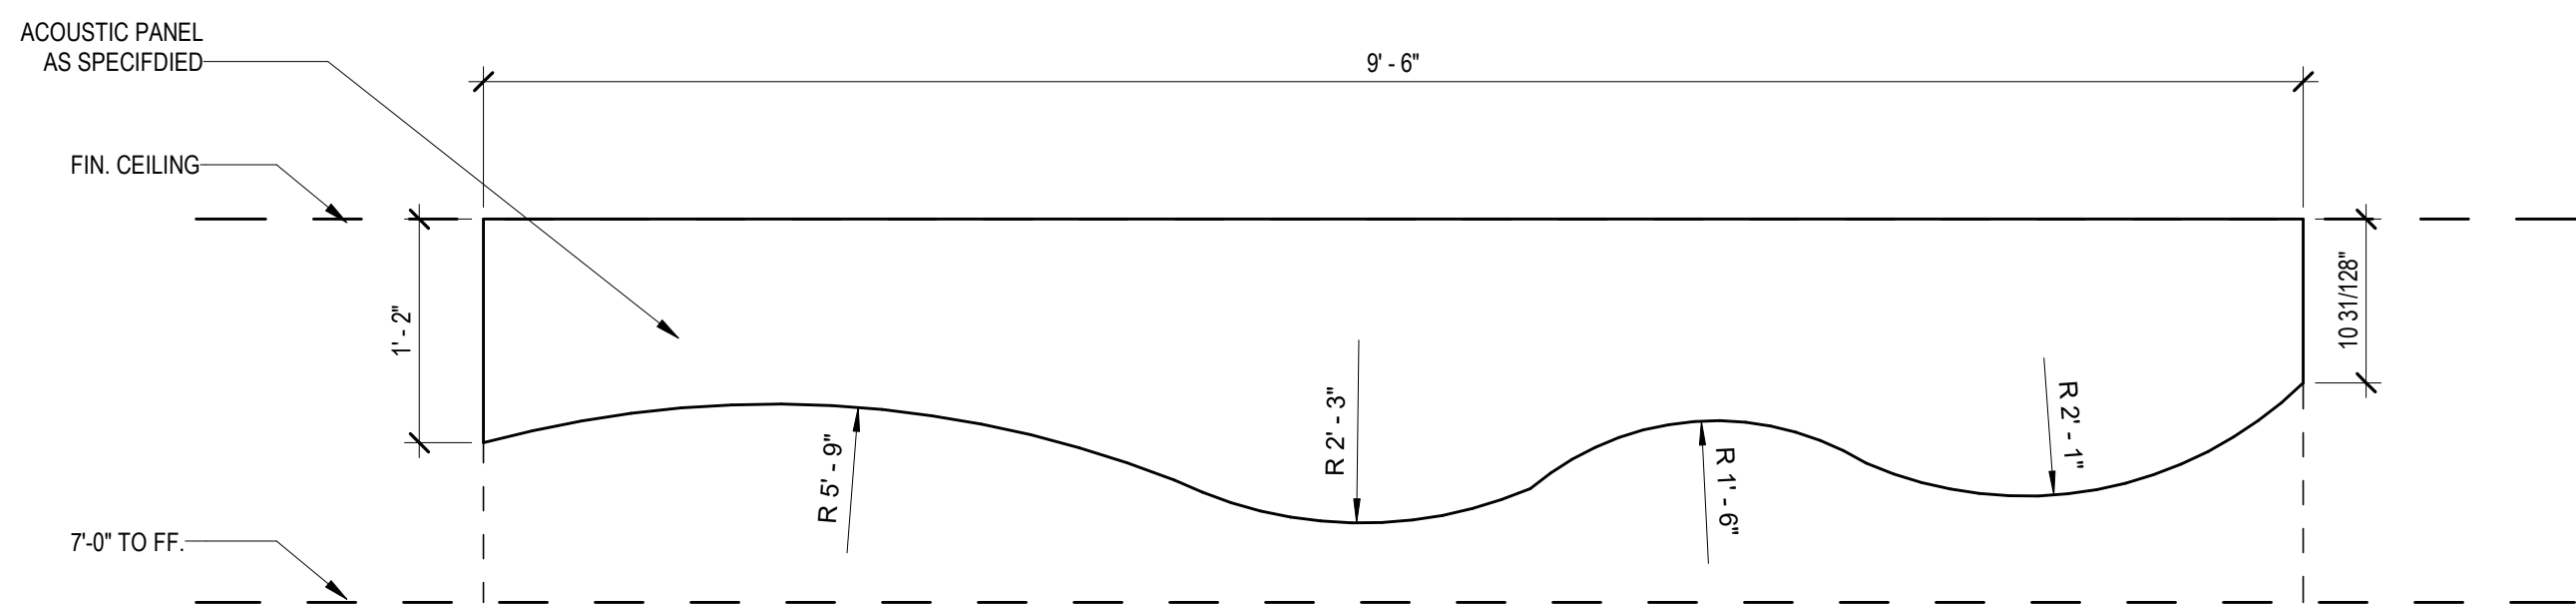


35C

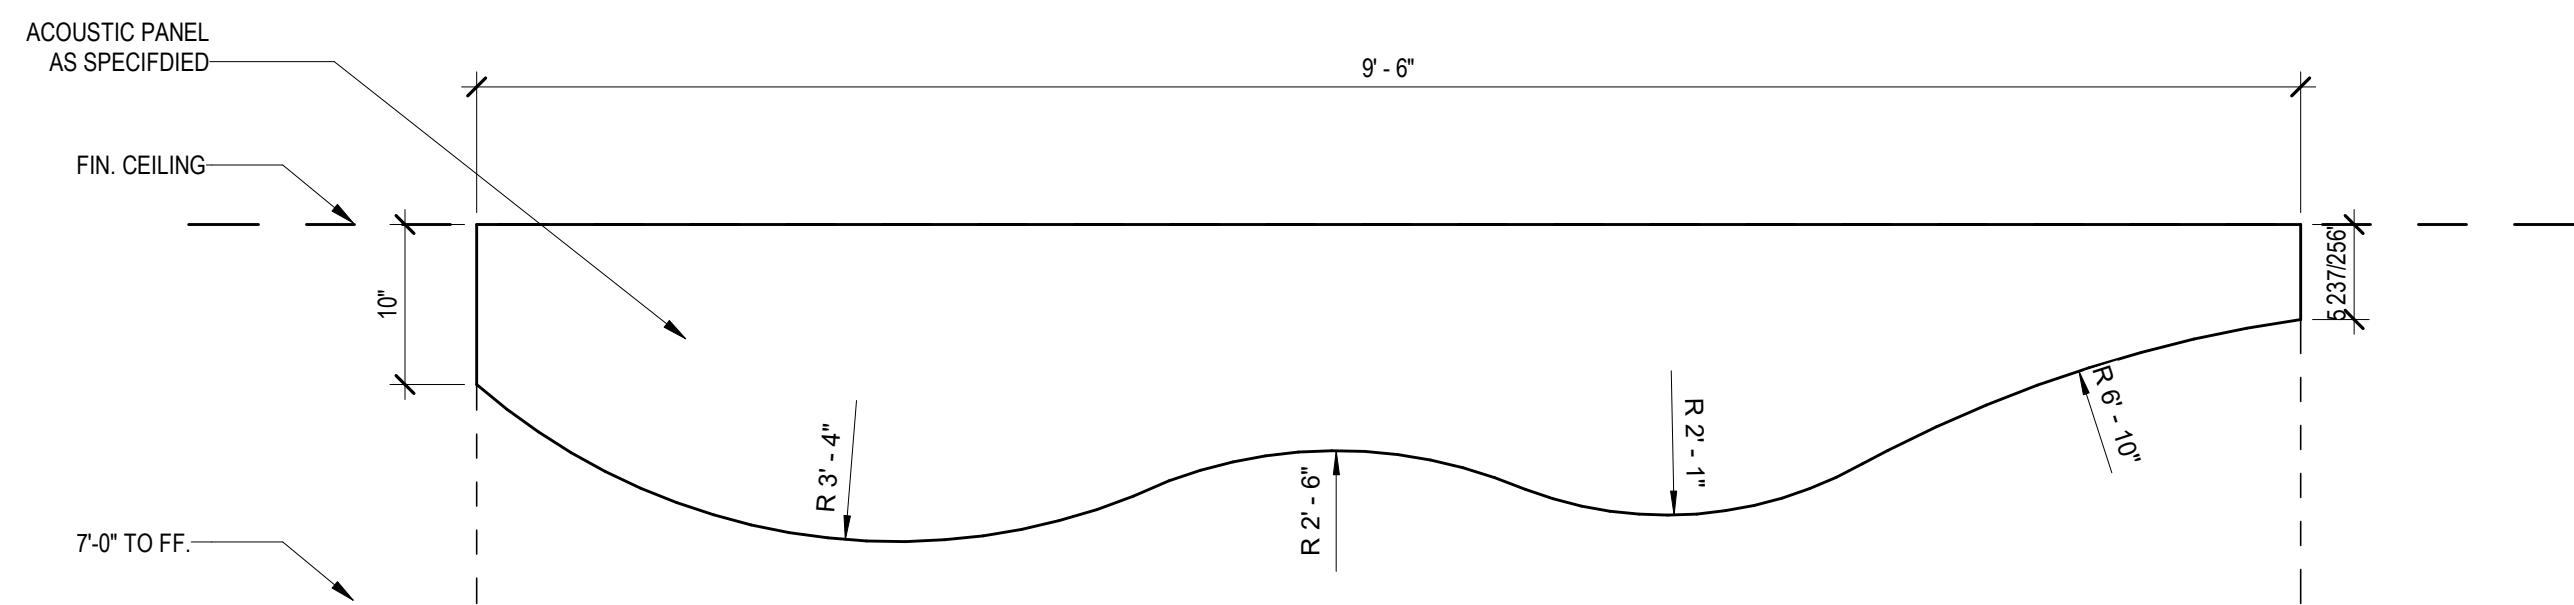

35D

TREE TRUNK PANELS Scale: 1" = 1'-0" 1

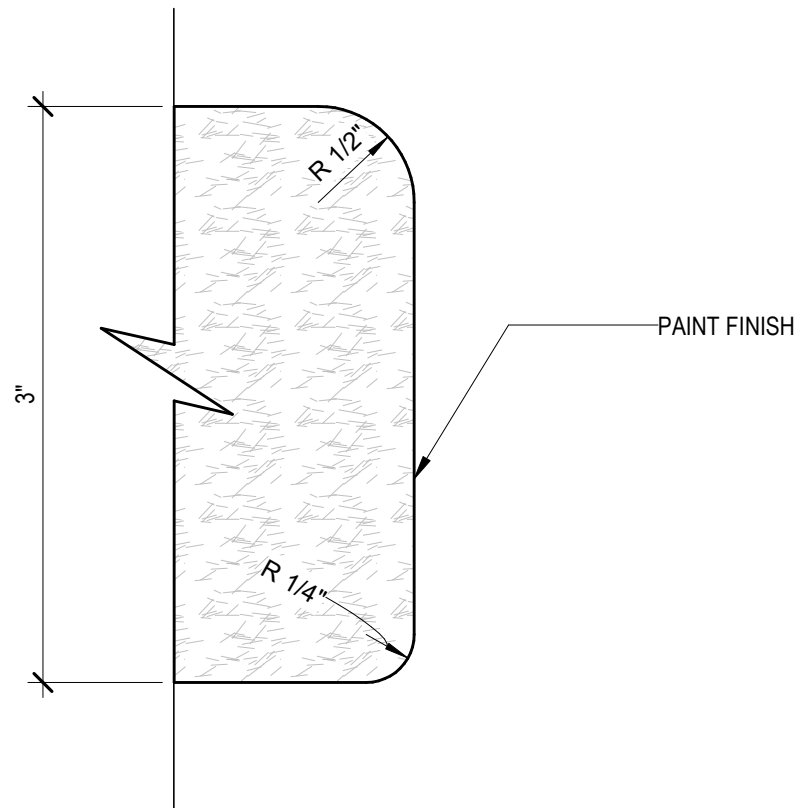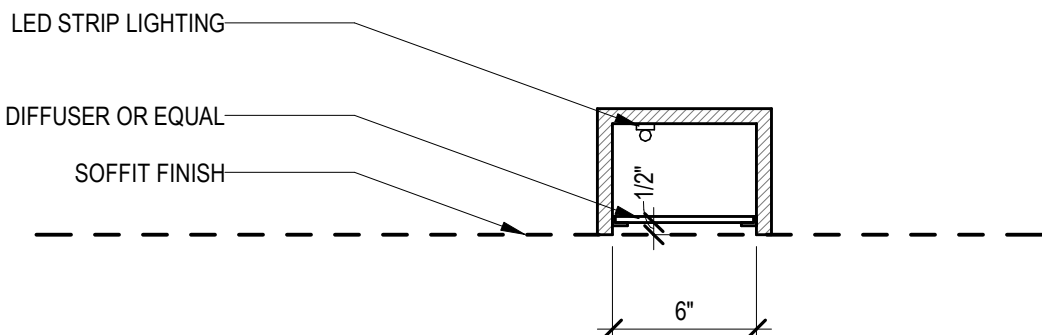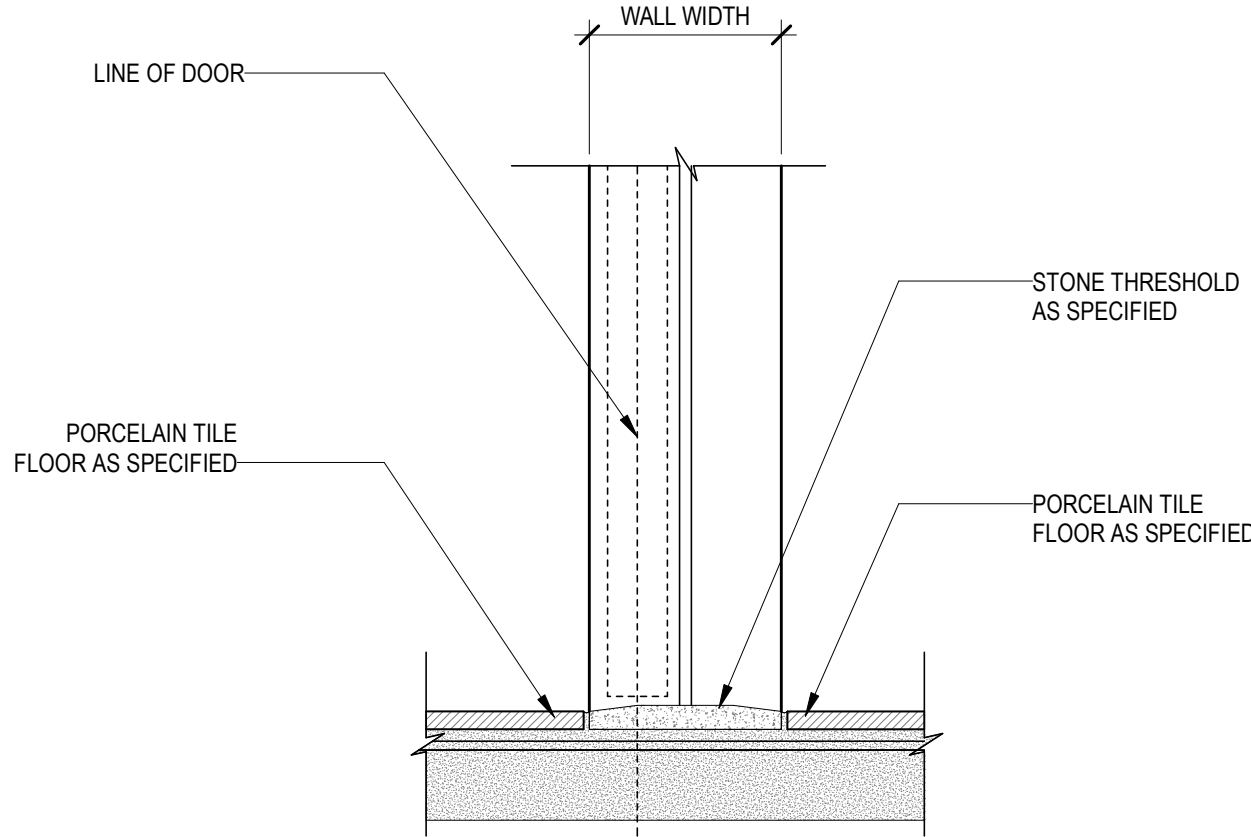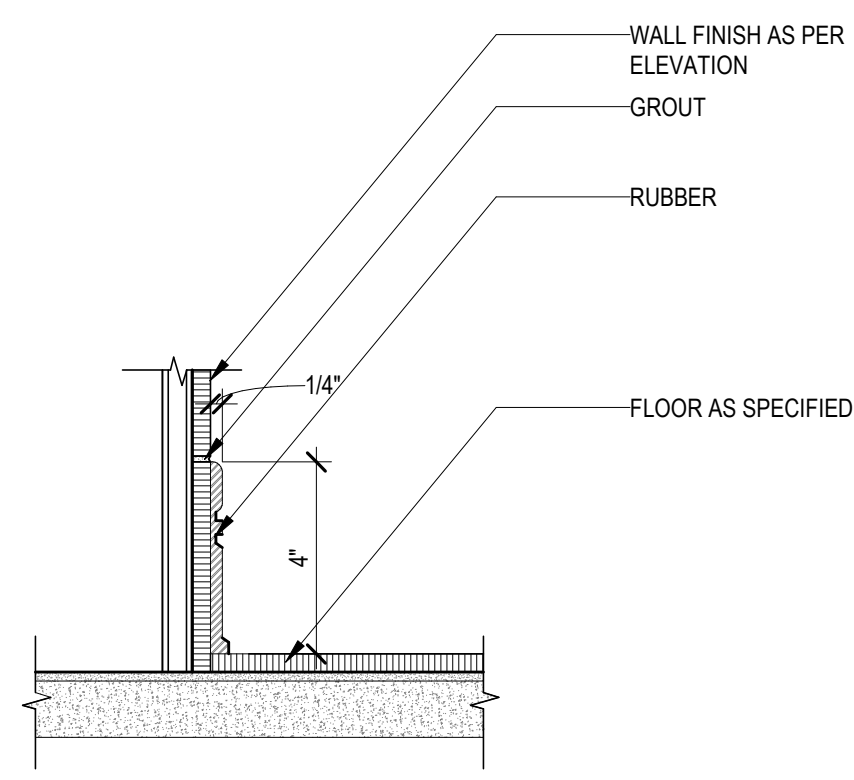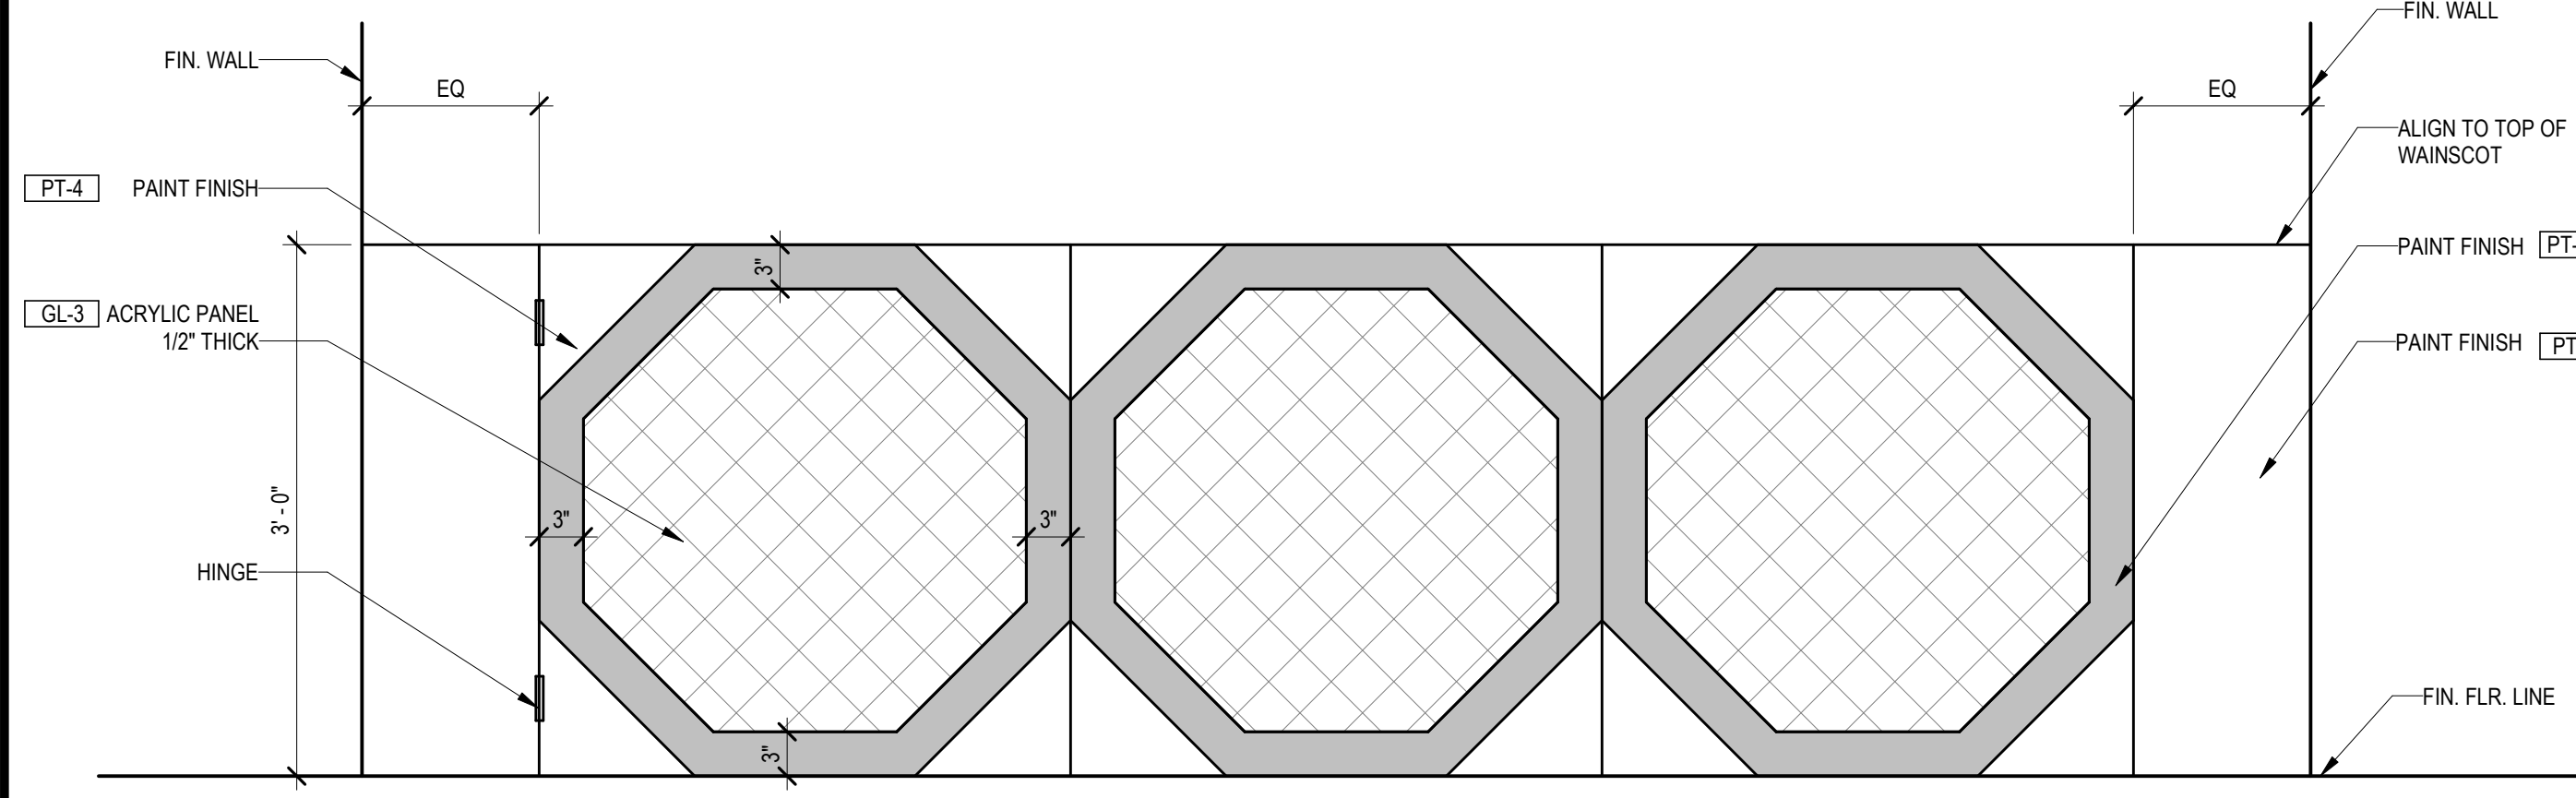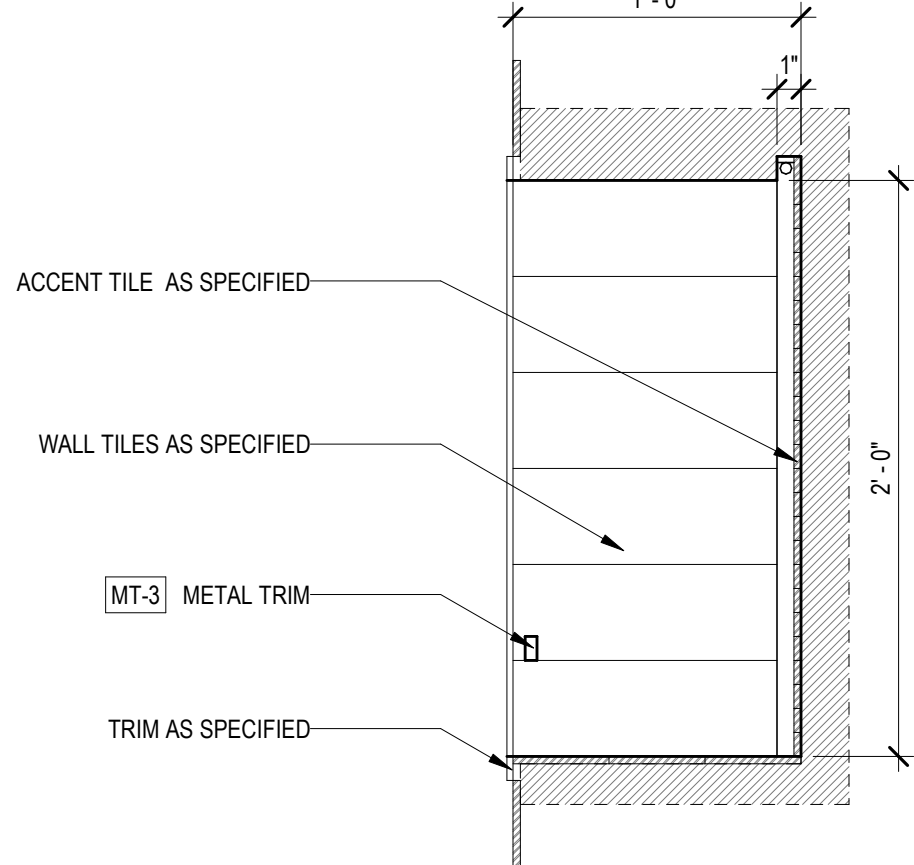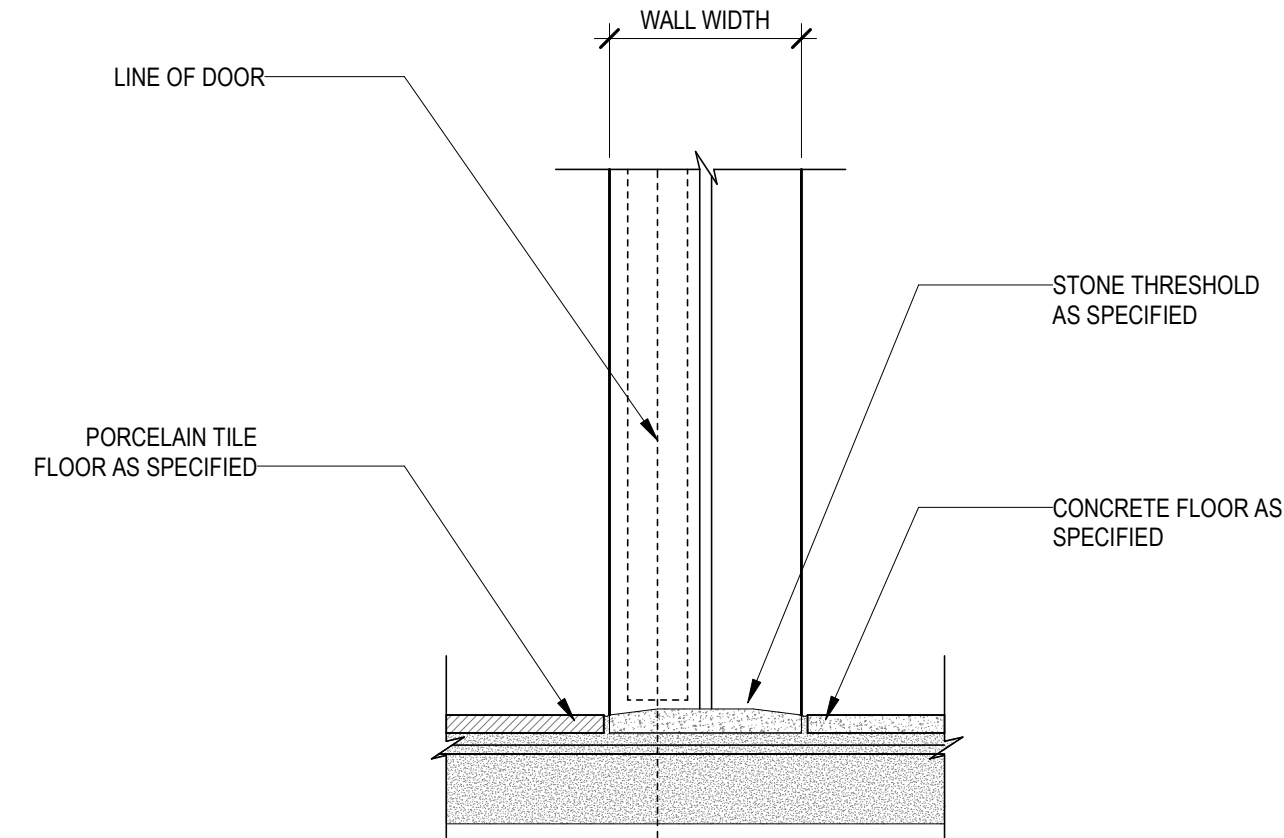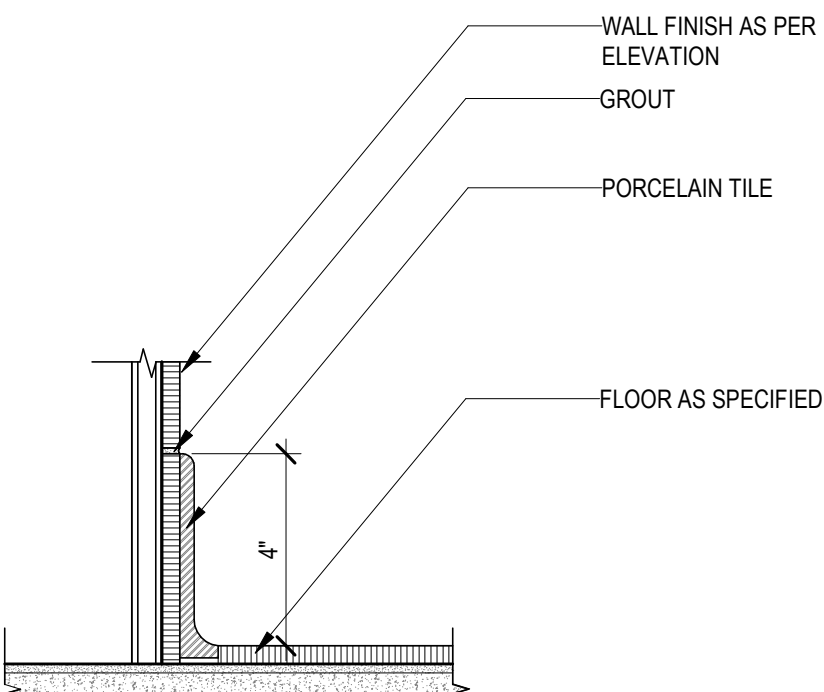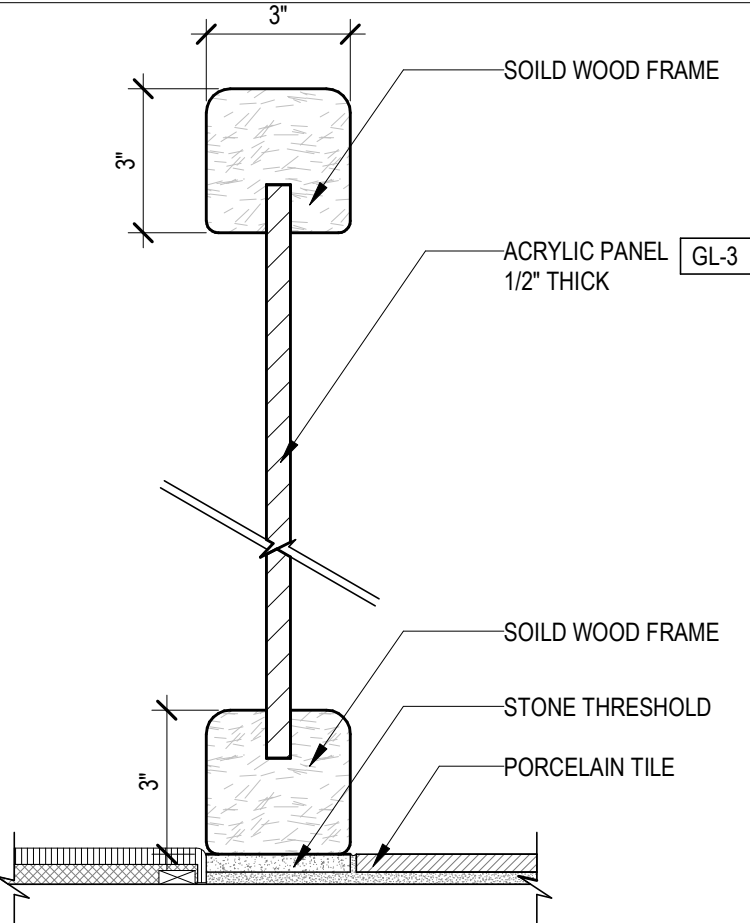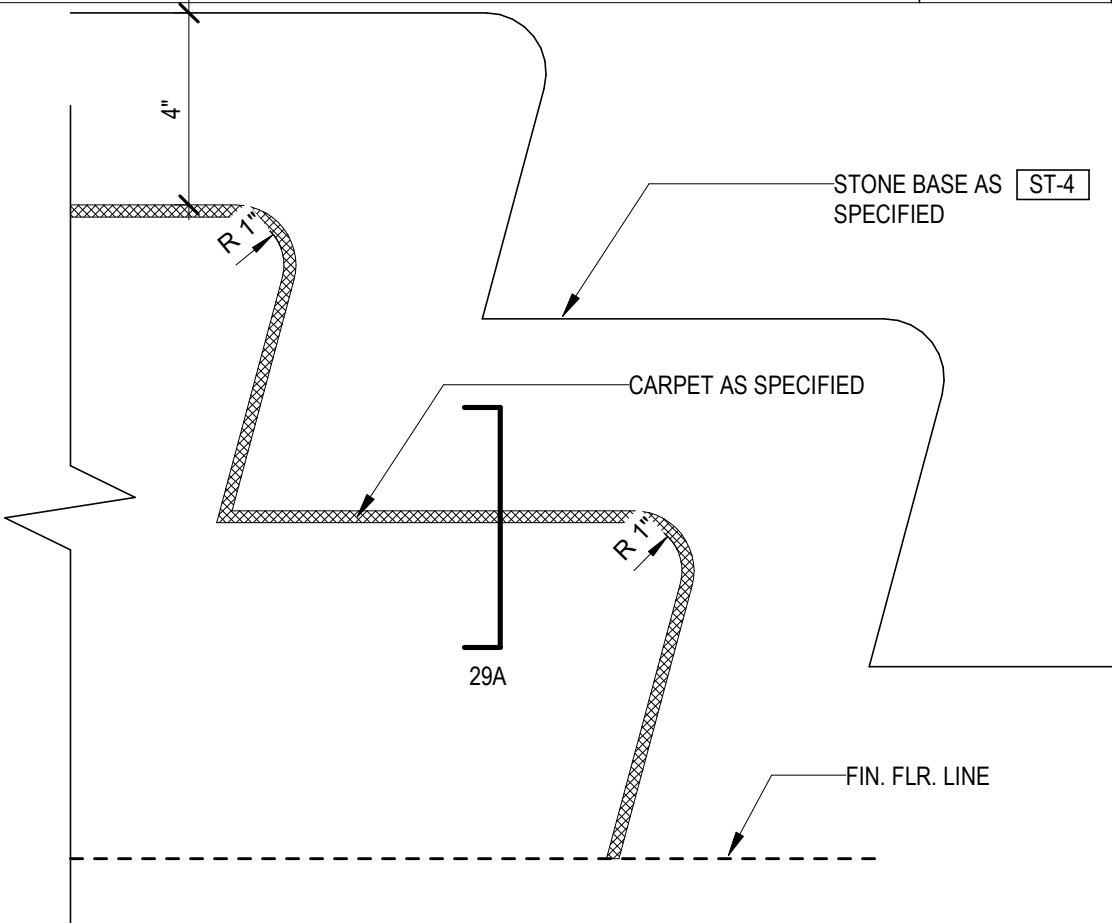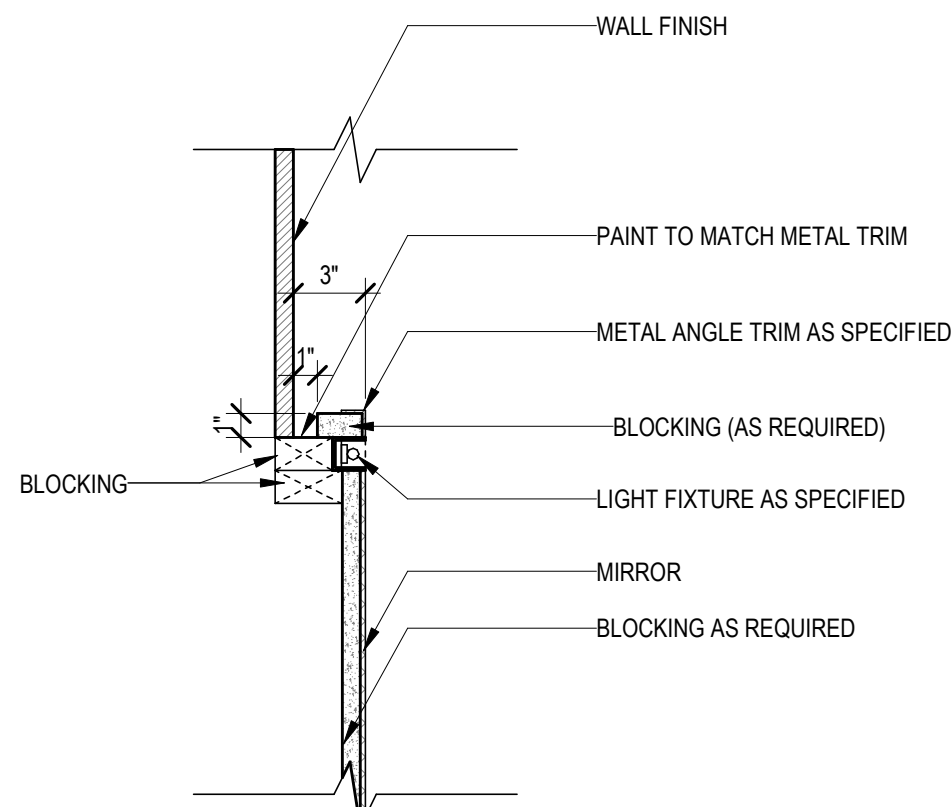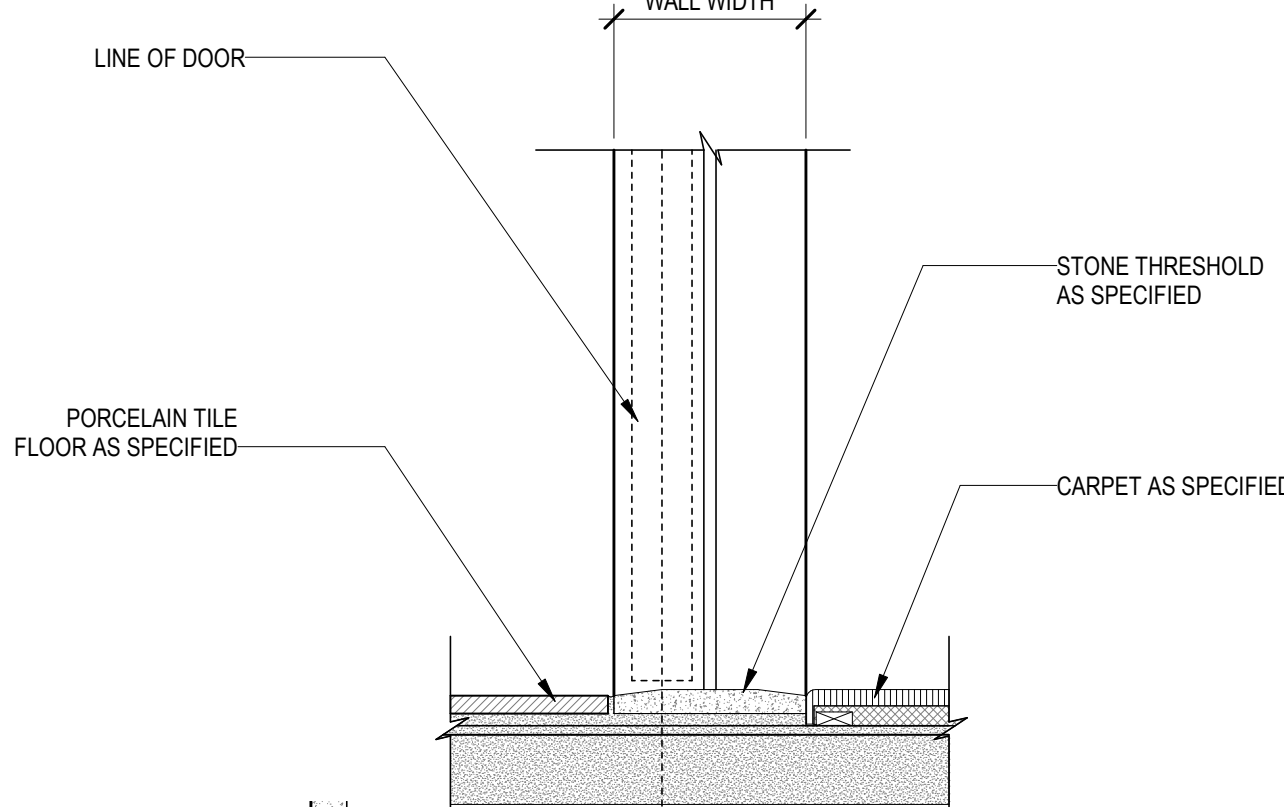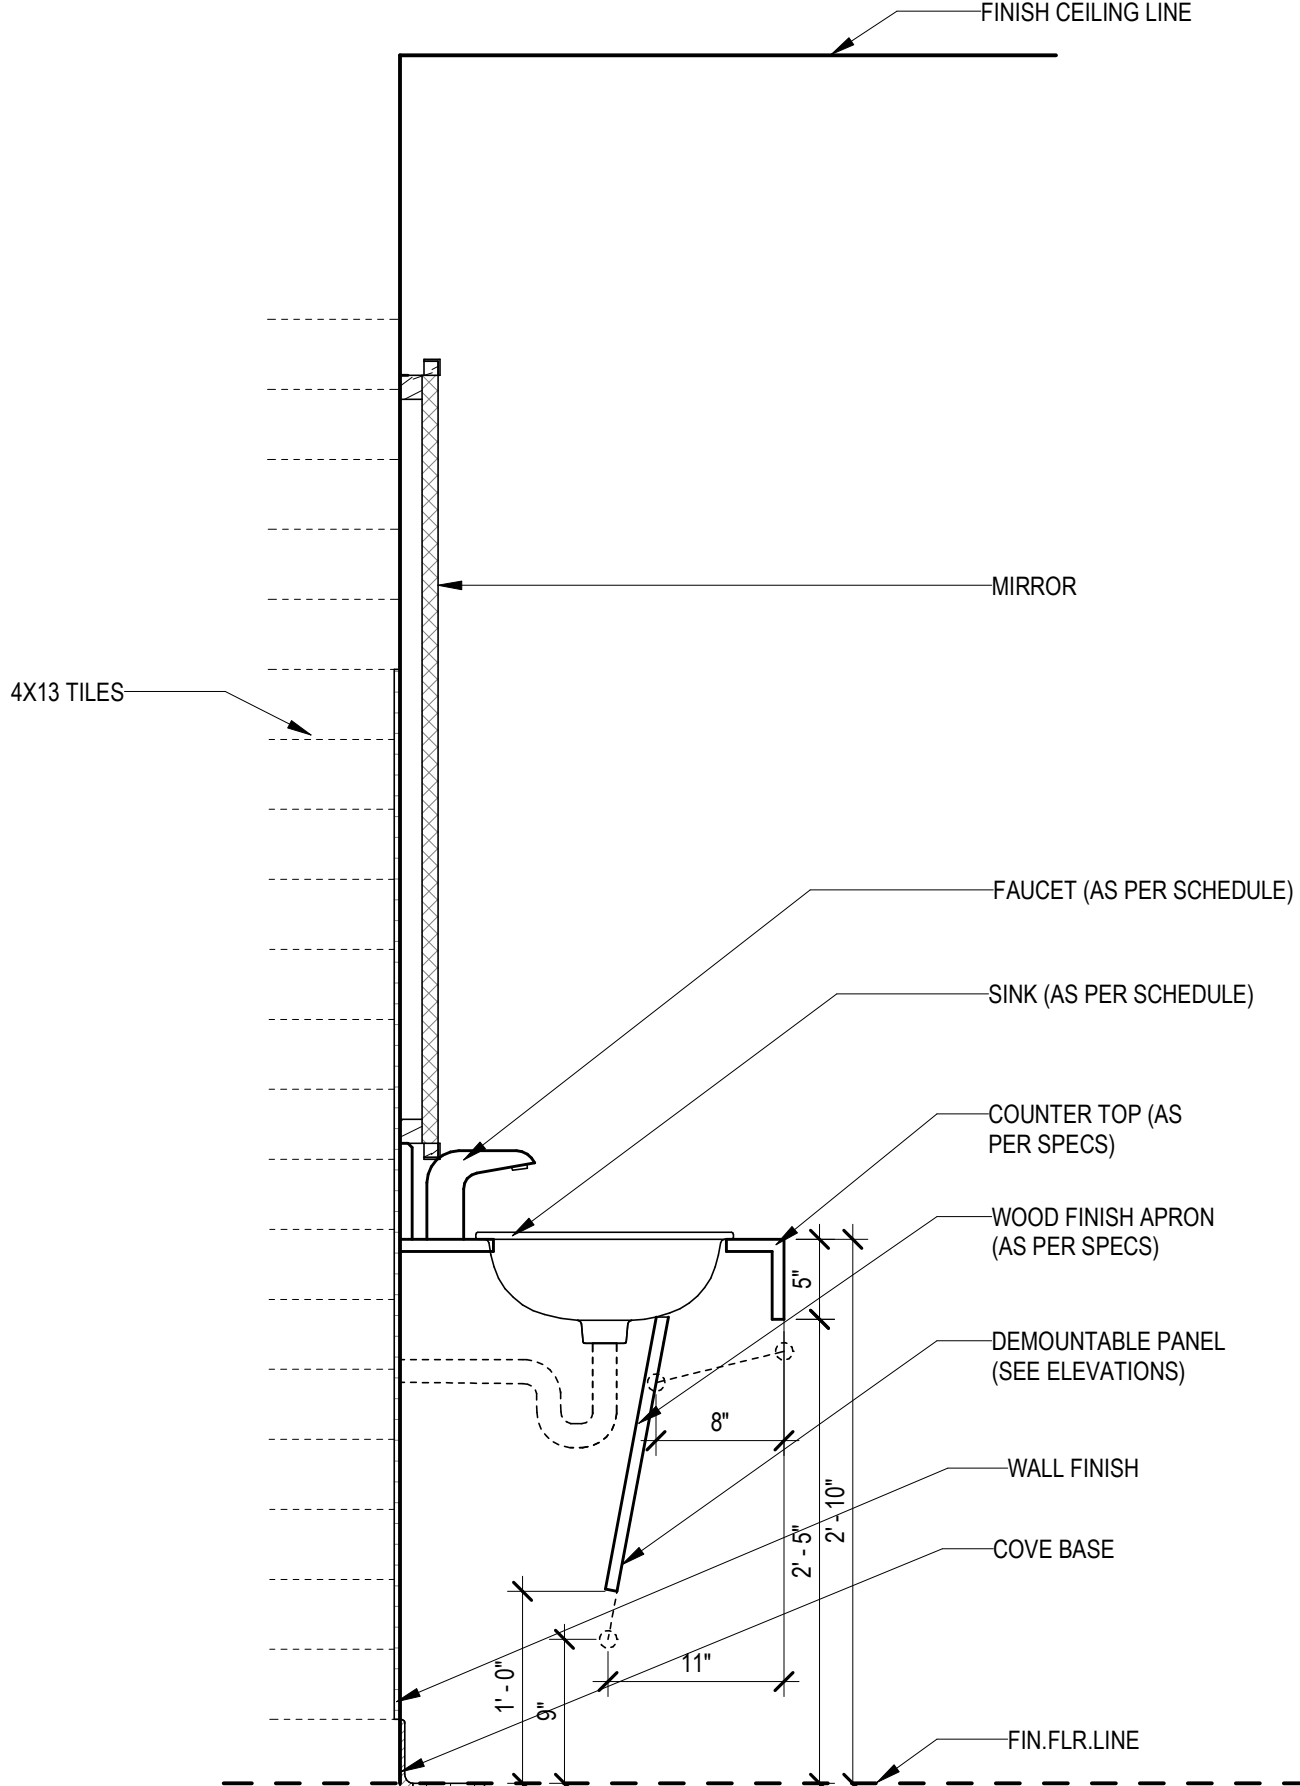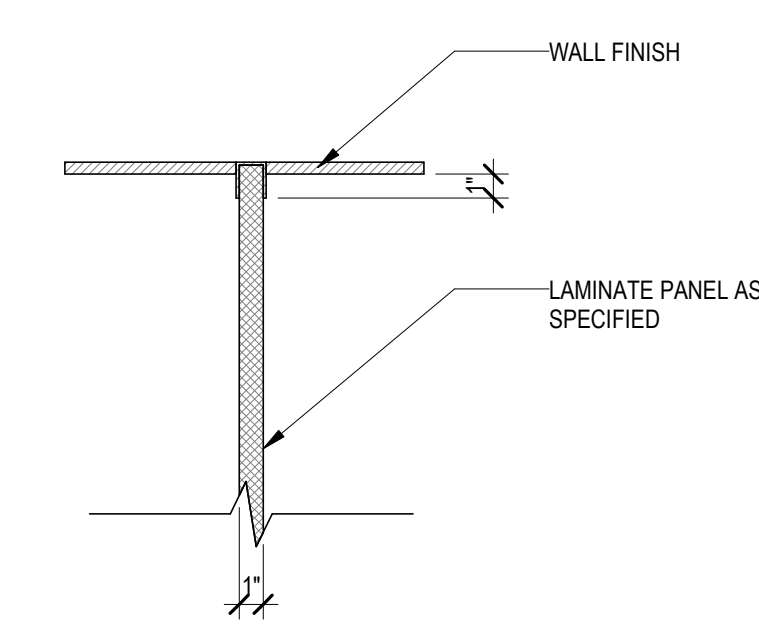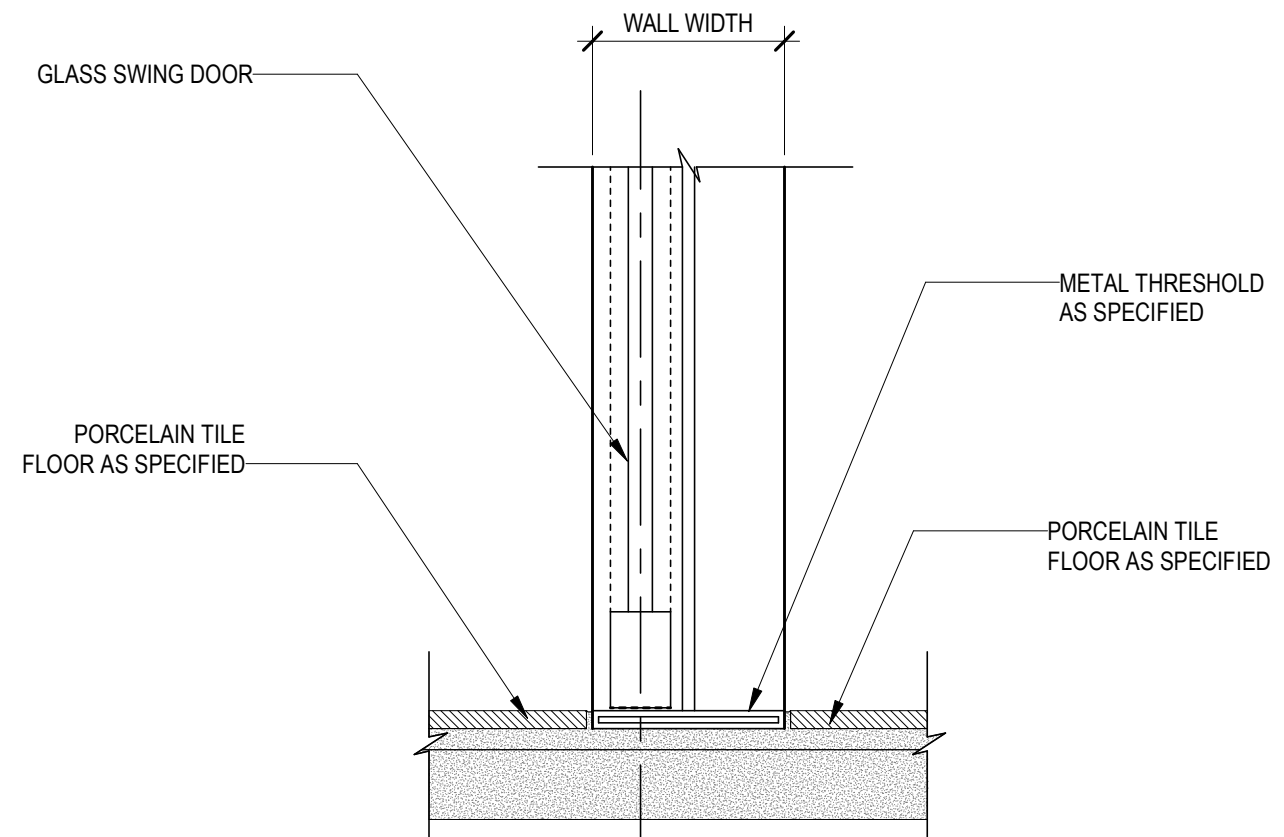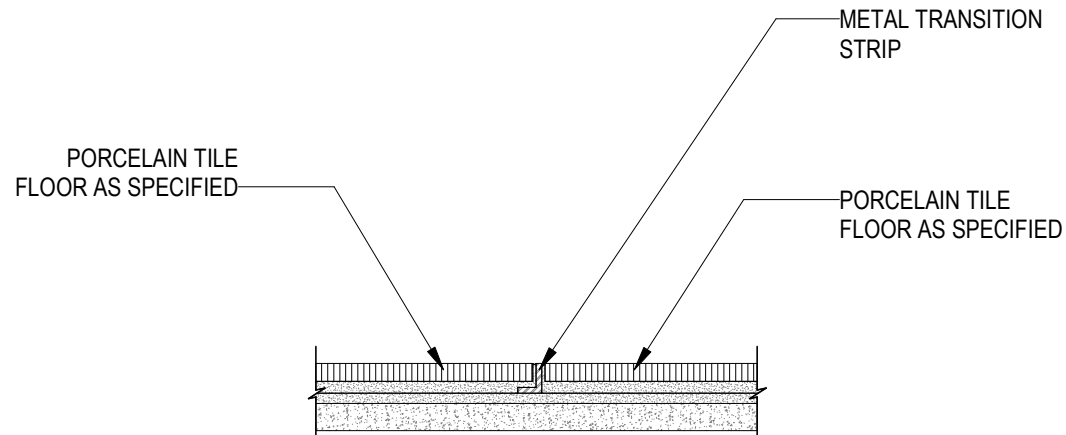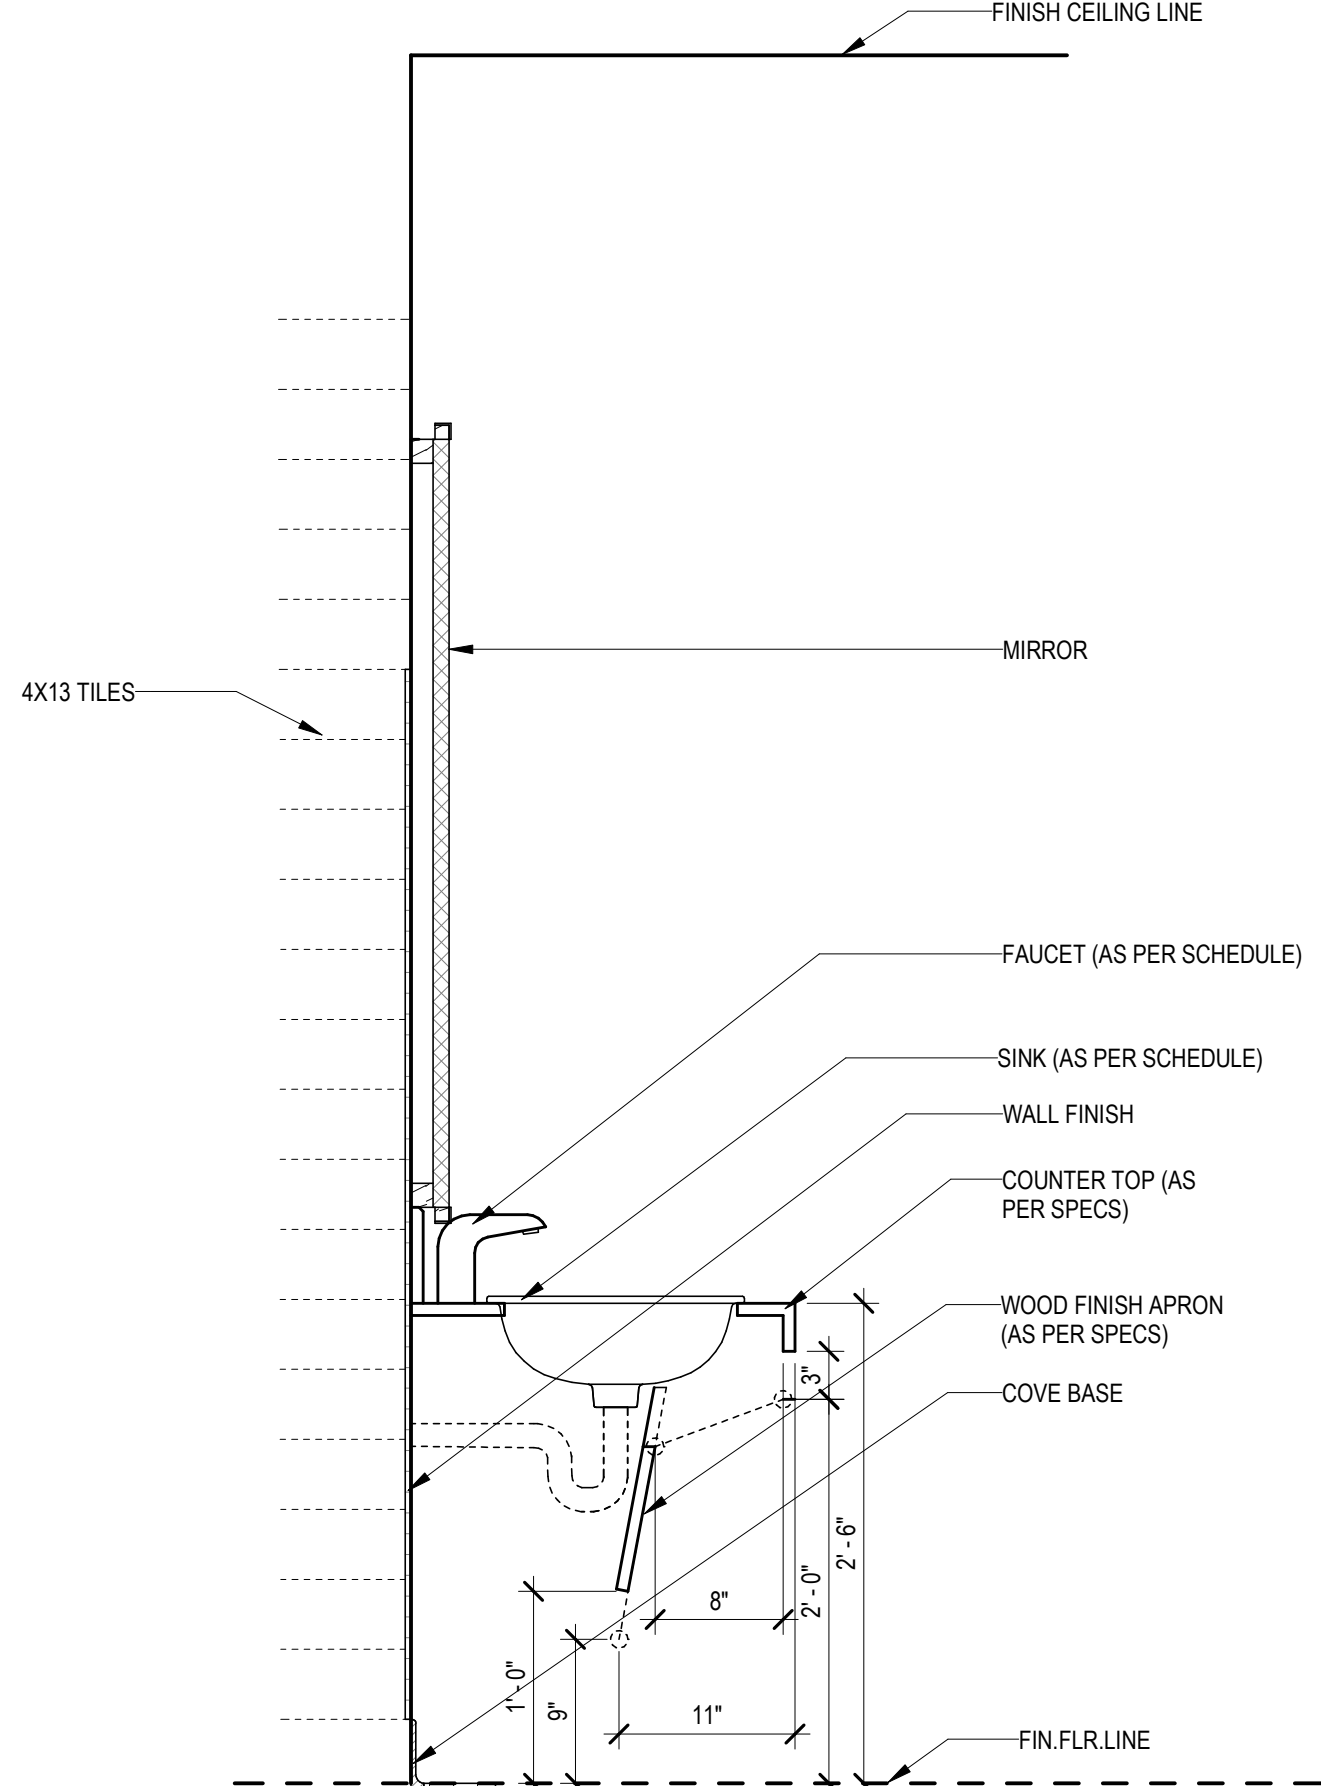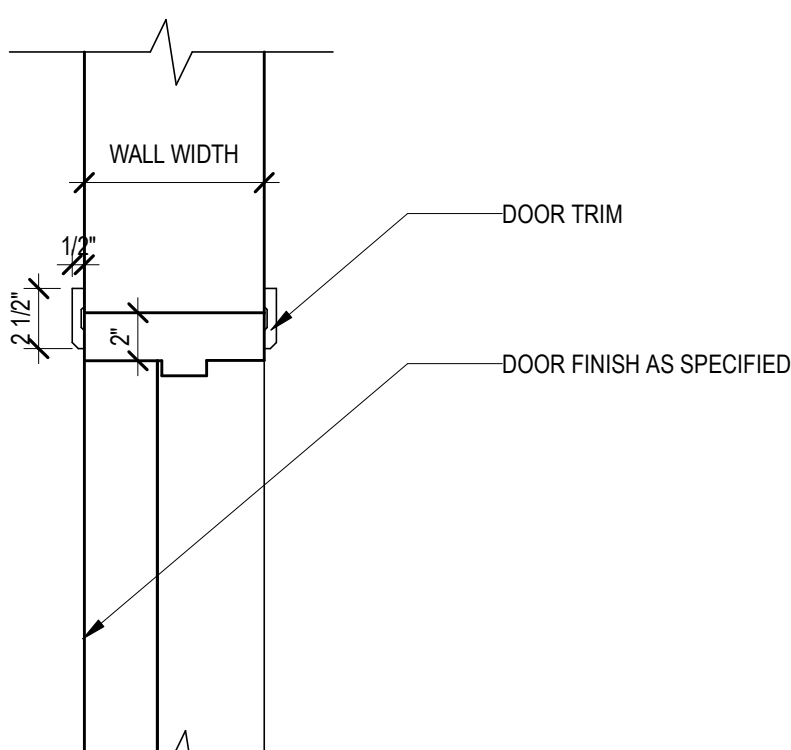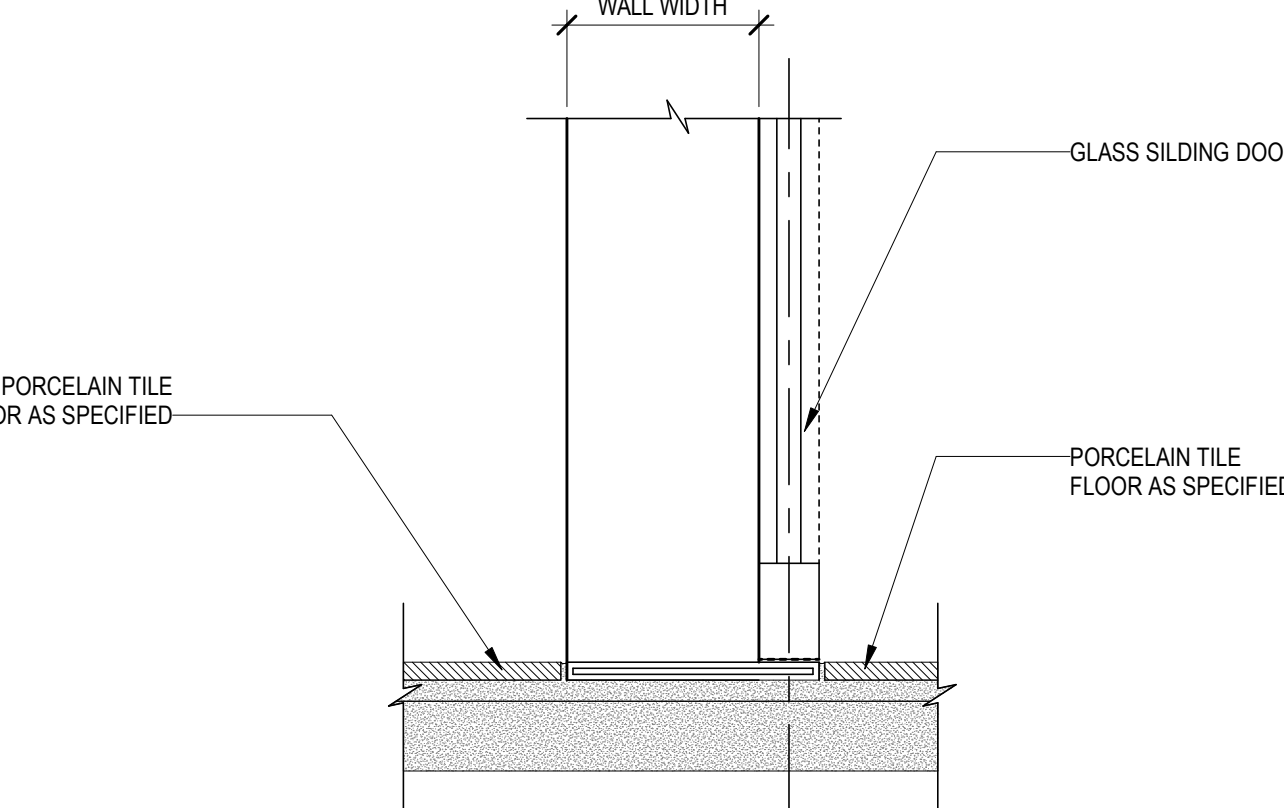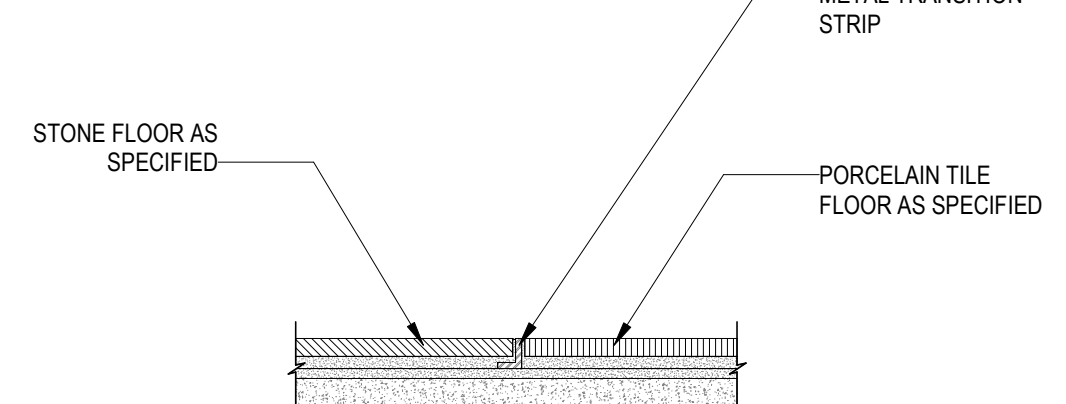	FRAME CORNER DETAIL Scale: 12" = 1'-0" 20		COVE LIGHTING Scale: 1 1/2" = 1'-0" 15		FINISH TRANSITION DETAIL Scale: 3" = 1'-0" 10		WALL BASE DETAIL- CORRIDOR Scale: 3" = 1'-0" 5
	GATE DETAIL - KIDS Scale: 1" = 1'-0" 19		WALL NICHE DETAIL Scale: 1 1/2" = 1'-0" 14		FINISH TRANSITION DETAIL Scale: 3" = 1'-0" 9		WALL BASE DETAIL - RESTROOMS Scale: 3" = 1'-0" 4
	GATE DETAIL - KIDS Scale: 3" = 1'-0" 23		COUCH DETAIL AT KIDS Scale: 3" = 1'-0" 18		FINISH TRANSITION DETAIL Scale: 1 1/2" = 1'-0" 13		FINISH TRANSITION DETAIL Scale: 3" = 1'-0" 8
	COUNTERTOP SINK SECTION Scale: 1" = 1'-0" 16		DOOR TRIM Scale: 1 1/2" = 1'-0" 11		FINISH TRANSITION DETAIL Scale: 3" = 1'-0" 7		FINISH TRANSITION DETAIL Scale: 3" = 1'-0" 2
	COUNTERTOP SINK SECTION Scale: 1" = 1'-0" 16		PARTITION Scale: 1 1/2" = 1'-0" 12		FINISH TRANSITION DETAIL Scale: 3" = 1'-0" 6		FINISH TRANSITION DETAIL Scale: 3" = 1'-0" 1

Last Saved: 3/11/2020 12:45:28 PM by: Author

Sheet Printed: 3/11/2020 12:45:28 PM
Drawing File Name: BM-350-2018-602 Riverton Phase II-Bldg M-INT.rvt

© 2016 Architects Orange. These plans are copyright protected. Unlike and protection unauthorized use is not permitted. These plans shall not be reproduced or used without written permission by Architects Orange.

